


LATERAL 126 SUB. 5 S.S. 22  
 W. B. CARTER CONST. CO. OCT. 13-59  
 BK. NO. K-60 PROJ. NO. C29-78

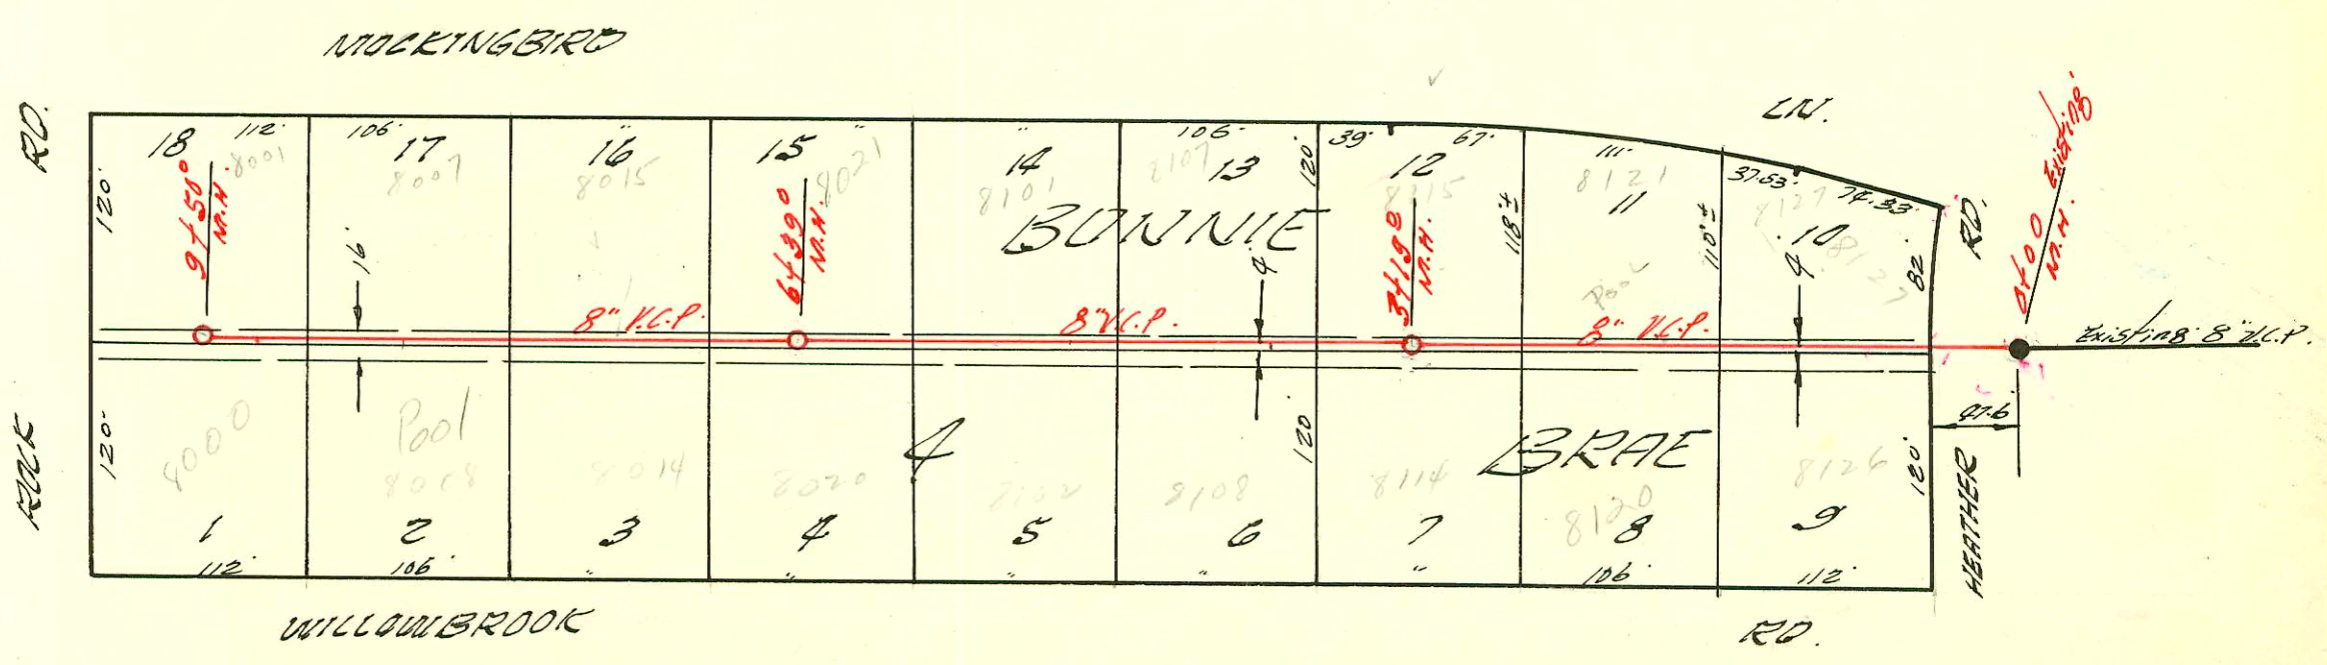

LATERAL 20 U.I. 5.  
 W. B. CARTER CONST. CO. 10-13-59  
 BK. NO. K-55 PROJ. # C28-107

CONSTRUCTION RECORD

SERVICE RECORD

STATION	ELEVATION		Depth	MANHOLE	4-INCH "Y" BRANCHES		No. of Permit		House Number		DATE OF PERMITS	
	Ground	Grade			North West	South East	North West	South East	North West	South East	North West	South East
0+00	126.1	115.00	11.1	NEW M.H.	+80°	+78°	B1690		1406 Westlyn		7-23-64	
1+00	128.1	115.20	12.9		+75°	+73°		#14566	1405 Sabin			8-14-61
2+00	127.2	115.40	11.8		+87°		B4619		1420 Westlyn	1409 Sabin	11-23-65	1-18-61
3+00	127.6	115.60	12.0		+75°	+72°			14368	1413 Sabin		6-27-61
4+00	127.9	115.80	12.1	3+190	+78°	+76°			12927	1417 Sabin		6-10-60
5+00	127.0	116.00	11.0		+75°	+73°	B2476	01414	1516 Westlyn	1421 Sabin	3-30-67	4-1-64
6+00	127.1	116.20	10.9		+87°	+55°	B5634	140.88	1526 Westlyn	1501 Sabin	5-13-64	4-19-61
7+00	127.8	118.23	9.6	6+420	+81°	+79°		12158		1505 Sabin		1-13-60
8+00	128.2	118.59	9.6	7+848								
9+00	128.6	118.63	10.0		+07°	+05°	B8887	13965	1536 Westlyn	1507 Sabin	2-18-64	3-14-61
10+00	128.8	119.03	9.8		+09°	+07°	B504	11625	1546 Westlyn	1513 Sabin	12-4-63	10-14-59
10+00	129.7	119.43	10.3		+97°	+95°		11761		1517 Sabin		10-27-59
10+00	128.9	119.59	8.8	10+380			tap M.H.	#17047	1556 Westlyn		5-2-63	
0+00	126.6	116.33	10.2	Existing M.H.	+73°			12469	1422 Sabin		4-6-60	
1+00	126.9	116.62	10.3			+65°						
2+00	127.7	116.92	10.8		#10840 2+020	+65°	B2039 2032053	12876	1118 Sabin		10-16-00	3-23-60
3+00	128.1	117.22	10.9		+125°			13222	1414 Sabin		8-3-60	
4+00	128.0	117.33	10.7	3+355		+74°						
5+00	128.2	117.52	10.7		#150435 4+218	+68°	#1913 12785		1410 Sabin		1-22-92	5-3-60
6+00	127.7	117.82	9.9		+25°	+53°	14872		1406 Sabin		10-24-61	
7+00	128.1	118.12	8.0		+52°	+50°	17168		1402 Sabin		5-23-63	
8+00	127.2	118.33	8.9	6+705								
0+00	156.4	150.60	5.8	Existing M.H. V. No.	+67°	+69°	#4203	#4	8127 Mackinac	8126 Mackinac	5-26-61	8-12-63
1+00	158.2	151.00	7.2		+80°	+82°		14973	8120 Mackinac		10-24-61	
2+00	160.5	151.40	9.1		+81°	+83°	B484	15467	8115 Mackinac	8114 Mackinac	12-2-63	4-9-62
3+00	162.3	151.80	10.5		+90°	+92°	15615	17326	8107 Mackinac	8108 Mackinac	5-11-62	7-29-60
4+00	162.5	151.88	10.6	3+190	+94°	+96°	B218	15462	8101 Mackinac	8102 Mackinac	6-16-63	4-7-60
5+00	164.9	154.04	10.9		+03°	+05°	14930	15675	8021 Mackinac	8020 Mackinac	11-9-61	5-25-62
6+00	165.4	155.24	10.2	6+390	+04°	+06°	#14564	16147	8014 Mackinac		8-14-61	9-17-62
7+00	165.6	155.72	9.9		+125°	+145°	#00480	17117	8007 Mackinac		6-6-80	5-14-63
8+00	167.1	158.44	8.9		+23°	+25°	B725	11889	8001 Mackinac	8000 Mackinac	1-23-64	11-24-59
9+00	167.7	158.84	8.9	9+500								
10+00	168.2	159.44	8.8									

13726 tap 1401 Sabin Leo Justice 1-19-61 (1+19)  
 #16352 - tap - 8008 Willamshook Reynolds Pkg - 11-13-62 (8+44)  
 #17443 - tap - 8121 Mackinac - Rhupp Pkg - 7-26-63 (2+30)  
 #153095 - tap - 1416 Westlyn - Reynolds Pkg 4-19-65 (1+78.0)