


LATERAL 71 S.S. 22  
 W.B. CARTER CONST. CO. OCT. 29 59  
 BK. NO. K-34 PROJ. NO. C2960



LATERAL 22 S.S. 22  
 W.B. CARTER CONST. CO. OCT. 29 59  
 BK. NO. K-64 PROJ. NO. C2590

SWL 2002-01311 S1862 1018 N Edwards Wichita ET  
 Recmet  
 SWL 2002-01312 S1862 1018 N Edwards - Wichita ET

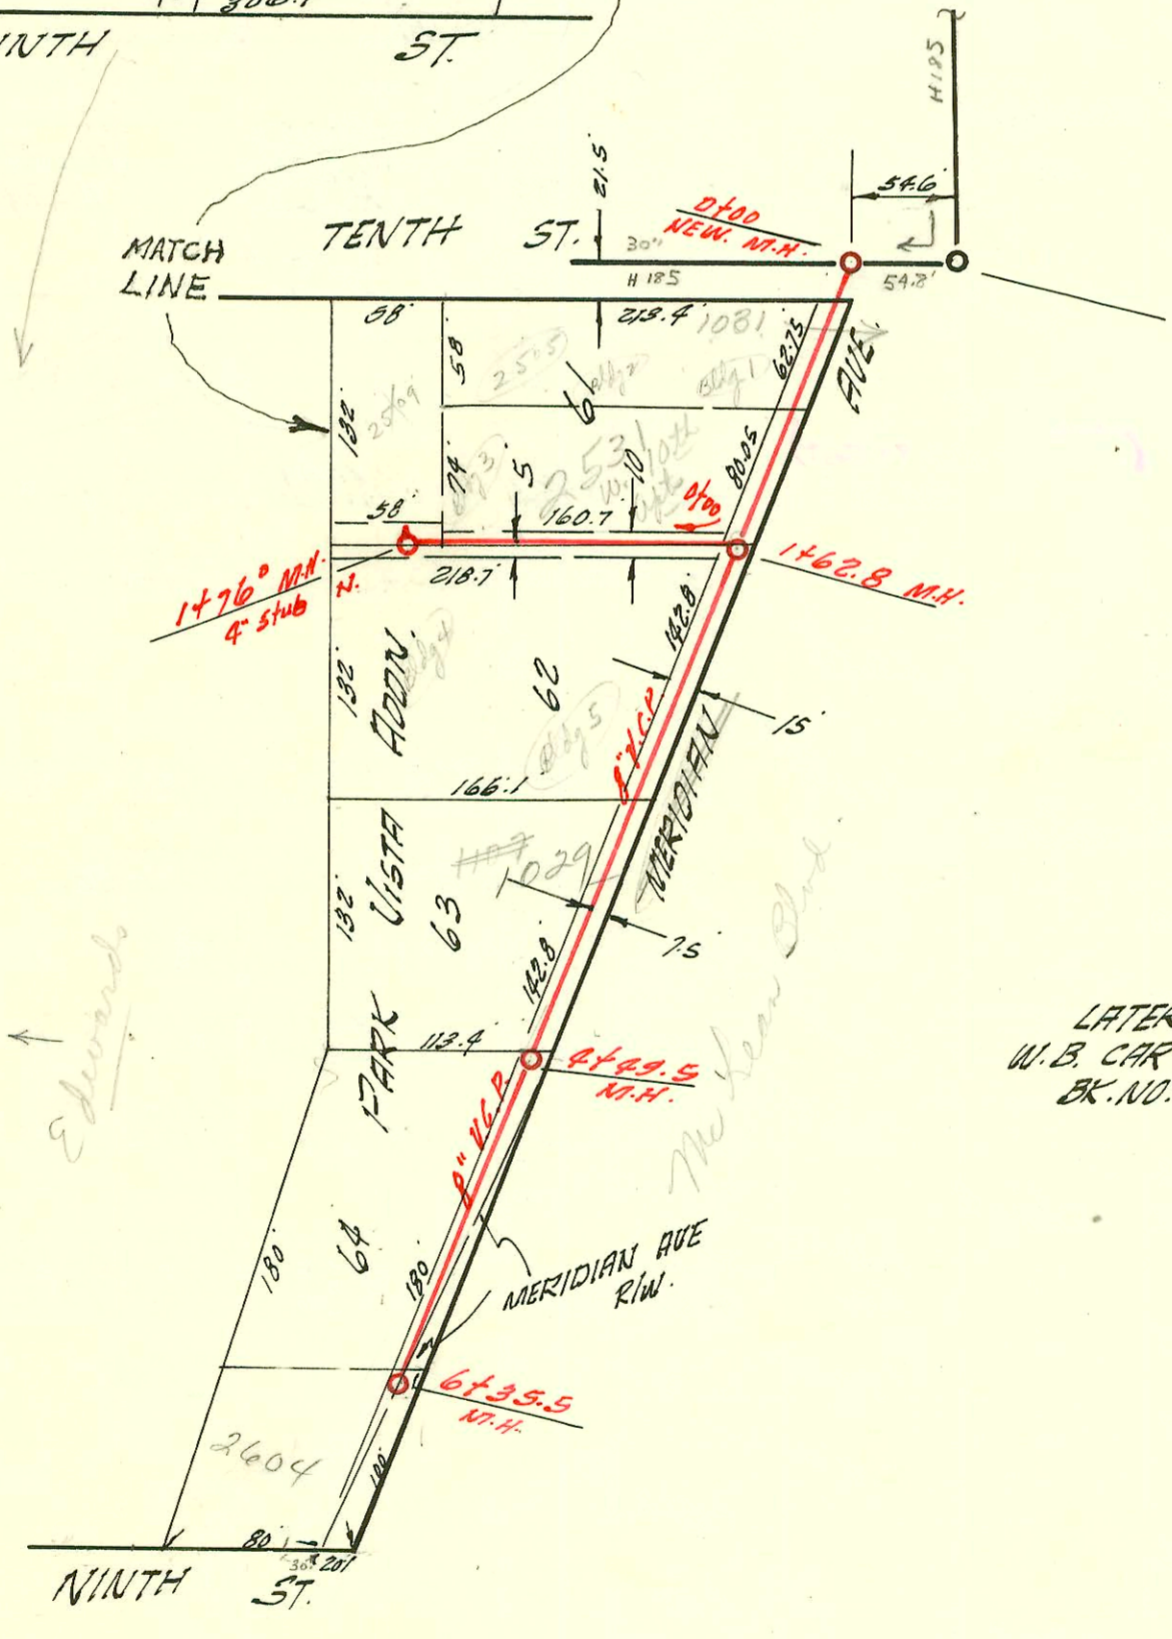