

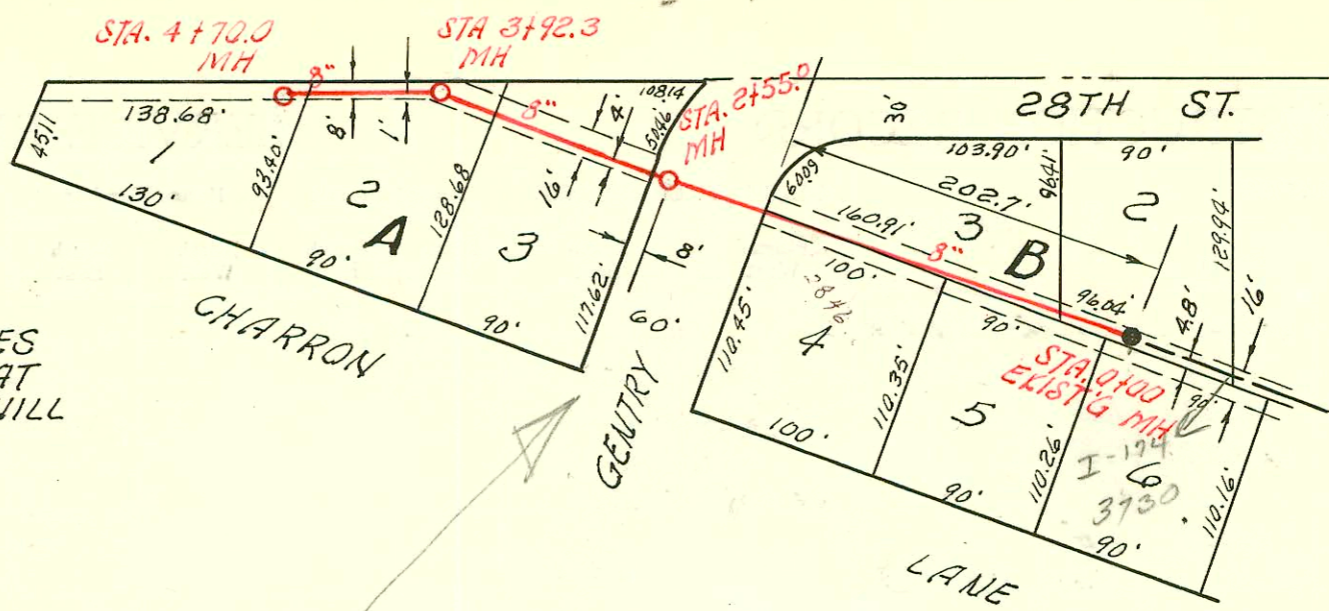




CHARRON'S GARDEN ESTATES
SECOND ADDN. & A REPLAT
OF LOTS 1 & 3 BLACKWILL
ADDITION.

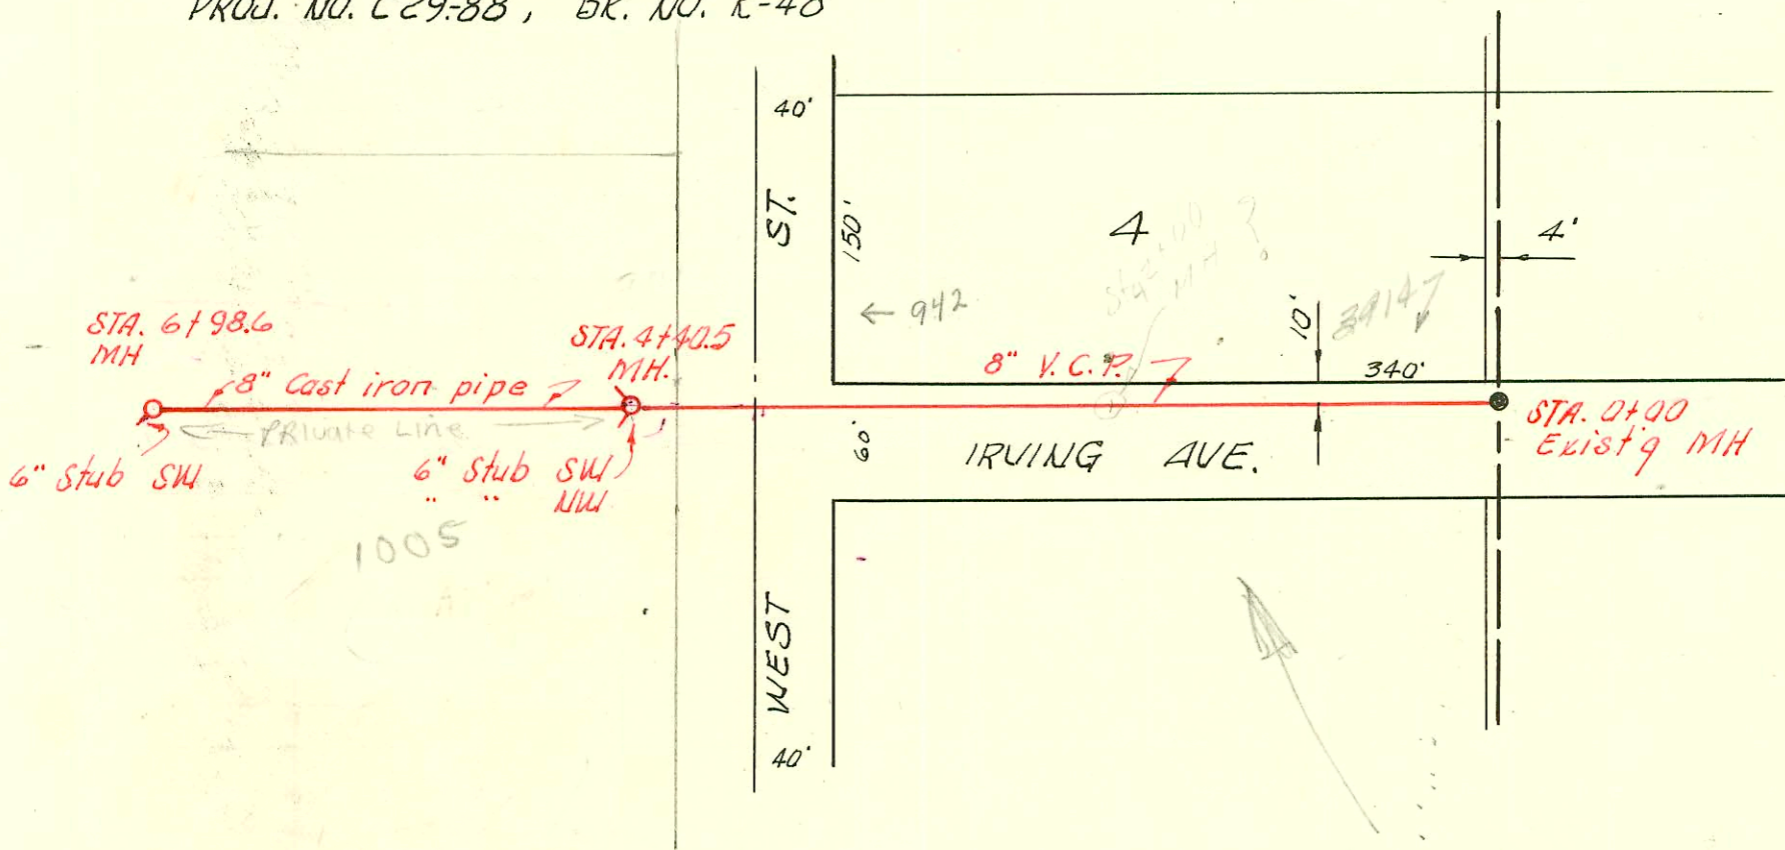



LAT. 17, S. S. NO. 23
UTILITY CONTR. INC. 11-25-59
PROJ. NO. C29-88, BK. NO. K-48

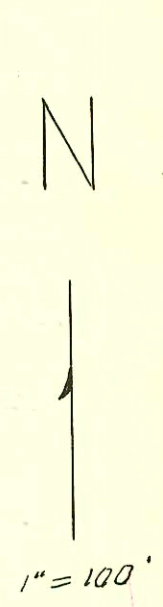


MASSEY-FERGUSON SAN. SEWER
UTILITY CONTR. INC., 11-25-59
PRIVATE CONTRACT, BK. K-61

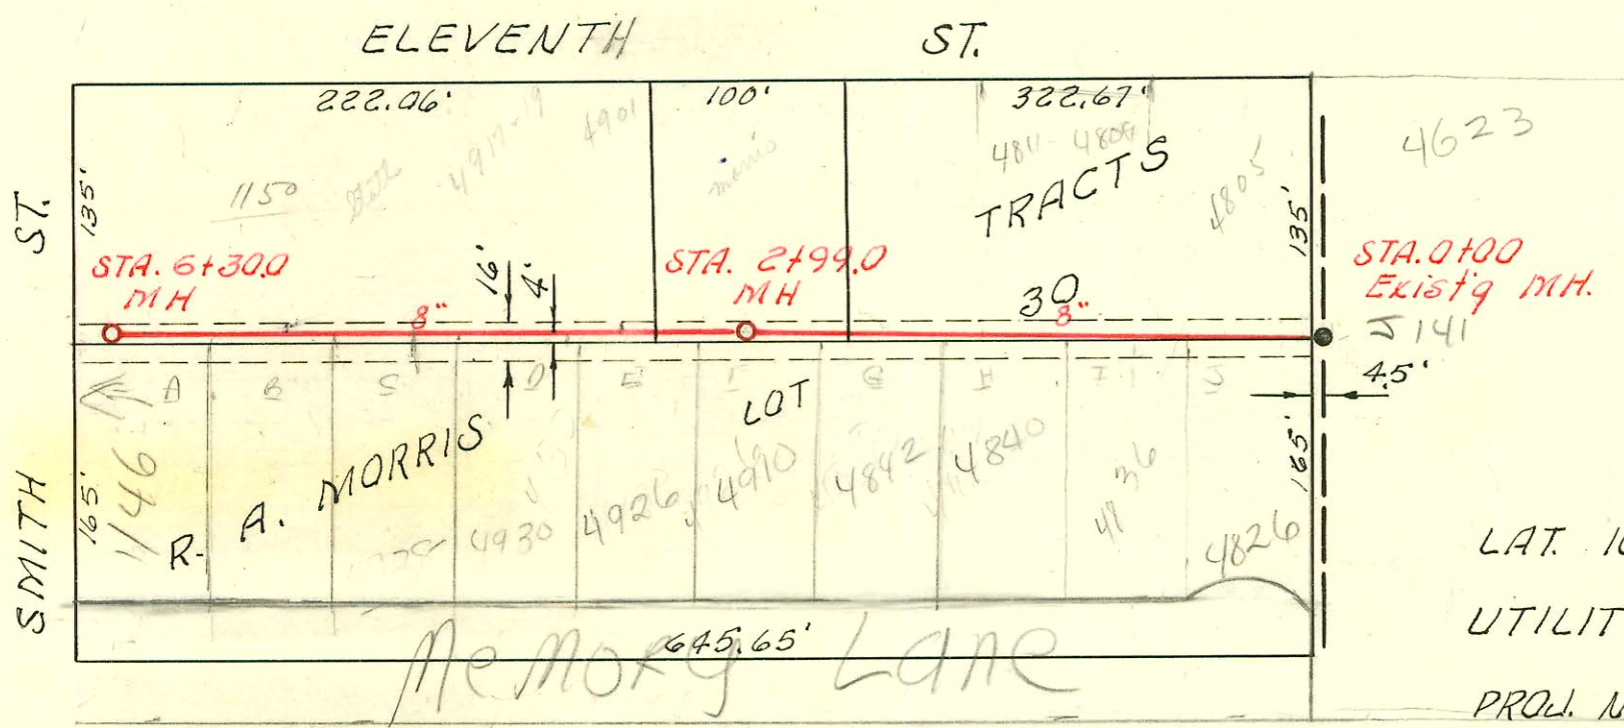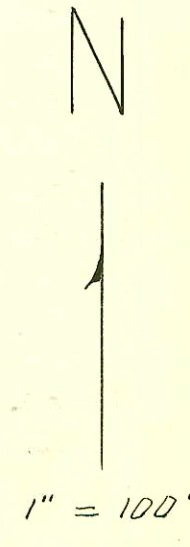

LAT. 104, SUB. 5, S. S. # 22
UTILITY CONTR. INC., 11-25-59
PROJ. NO. C29-11, BK. # K-56

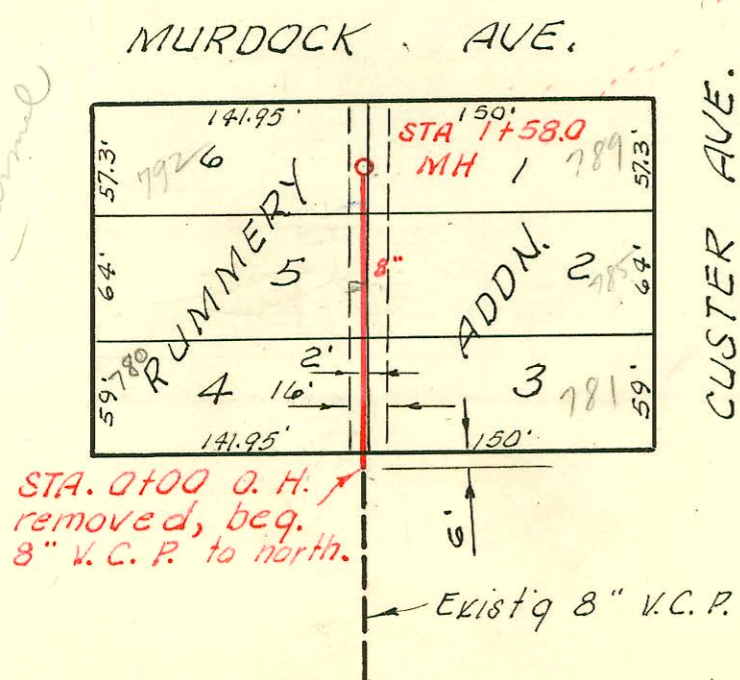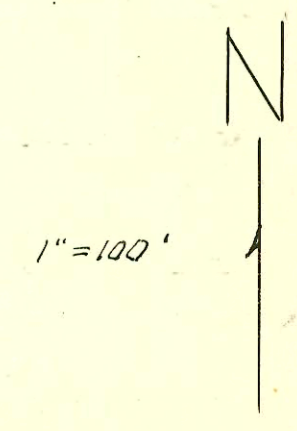

LAT. 72, SAN. SEWER # 22
HENSLEY ENTERPRISES INC.
PROJ. NO. C29-86, 11-25-59
BK. K-46

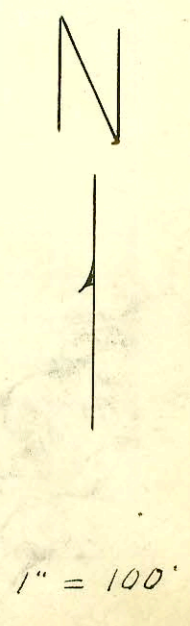

CONSTRUCTION RECORD					SERVICE RECORD							
STATION	ELEVATION		Depth	MANHOLE	4-INCH "Y" BRANCHES		No. of Permit		House Number		DATE OF PERMITS	
	Ground	Grade			North West	South East	North West	South East	North West	South East	North West	South East
0+00	154.9	145.84	9.1	0+00 Existg MH								
1+00	153.8	146.14	7.7		0+62.0	0+36 0+45.0 1+77.7		C66097 C76232	3730 Charramom 02846 CENTRY		4-26-78 1-21-80	
2+00	152.9 152.4	146.44 146.61	6.5 5.8	2+55.0	1+24.0	1+26.0		C76233	02846 CENTRY		1-21-80	
3+00	151.9	146.74	5.2		2+86.5	2+88.5						
4+00	151.6 151.5 151.4	147.02 147.04 147.25	4.6 4.5 4.1	3+92.3 4+70.0		3+78.0						
0+00	113.1	108.45	4.6	0+00 Existg MH								
0+03				Beq. Proj.								
1+00	113.1	108.60	4.5									
2+00	113.2	108.76	4.4		1+32.6			C24002	3974 Spring West		5-3-71	
3+00	113.4	108.91	4.5	2+00.0	1+70.3			C33635			1-17-72	
4+00	113.6 113.7	109.07 109.13	4.5 4.6	4+40.5	6" stub NW	6" stub SW						
5+00	113.0	109.22	3.8									
6+00	112.7 112.7	109.37 109.53	3.3 3.2	6+98.6		6" stub SW	13089		1009 West		7-15-60	
0+00	124.8	116.68	8.1	0+00 Existg MH								
0+03				Beq. Proj.								
1+00	125.3	116.88	8.4		0+21.0	0+38.0 0+23.0	24657 13817	25473	4805 W. 11th 4809 W. 11th	4826 Memory	10-9-89 1-30-61	6-6-90
2+00	126.0	117.08	8.9		0+71.0	0+73.0	17523				12-23-86	
3+00	125.6	117.28	8.3	2+99.0	1+19.0 1+72.0	0+91.0 1+21.0 1+74.0	17523	17235 21117	487 W. 11th N	4836 Memory LN	11-3-86	7-20-88
4+00	125.1	117.48	7.6		2+22.0 2+71.5	2+24.0 2+73.5	13976	17236	4817 W. 11th	4842 Memory LN	3-16-61	11-3-86
5+00	125.4	117.68	7.7		4+21.0 4+69.8	4+23.0 4+71.5	9114	17408	4910 Memory LN		12-8-86	
6+00	125.5 125.7	117.88 117.94	7.6 7.8	6+30.0	3+20.0 3+75.5 4+58.0	3+20.0 3+75.5 4+58.0	17237 17409 9115	17408	4926 Memory LN 4930 Memory LN 4938 Memory LN		11-3-86 12-8-86 8-31-83	1-5-88
0+00	121.3	114.00	7.3	Existg O.H. Removed Beq. 8" V.C.P.	Y-WEST	Y-EAST						
1+00	119.7	114.40	5.3		0+15.0 0+96.0 0+76.5	0+26.0	93-24378-7 03333	12067	780 N. Custer 781 N. Custer	9-93 R 5-4-65	12-18-59	
					1+32.5	1+02.4	04378	13999	782 N. Custer	3-4-74	3-23-61	
	119.2	114.64	4.6	1+58.0	1+50.0		012331	11933	789 N. Custer	1-23-69	11-27-59	

Change 1 to
 1009 West St.
 M.H. Stub
 4" Sch 40 P.V.C.

#12029 top 4901 W. 11th St. Al Kenning 12-2-59 3+65
 Rec 44793 spec for 400.00 1009 S. West St. Murray Ferguson 7-14-60 (13089 7-15-60)
 #93-24378-7 - 780 N. Mt Carmel - R - 2nd Kick-out under addition tie into existing sewer;
 2-4" C.O.; 2-45 H; 4" DR 35
 94-8247 - 6-1-94 1005 S. West = 4" clay - 10ft 2nd sub out.
 94-8290-7 - 6-1-94 1005 S. West N.C.
 94-8213-7 - 6-1-94 1005 S. West = M.H. Stub = 4" Sch 40 P.V.C.