



Pine Valley Estate 5th

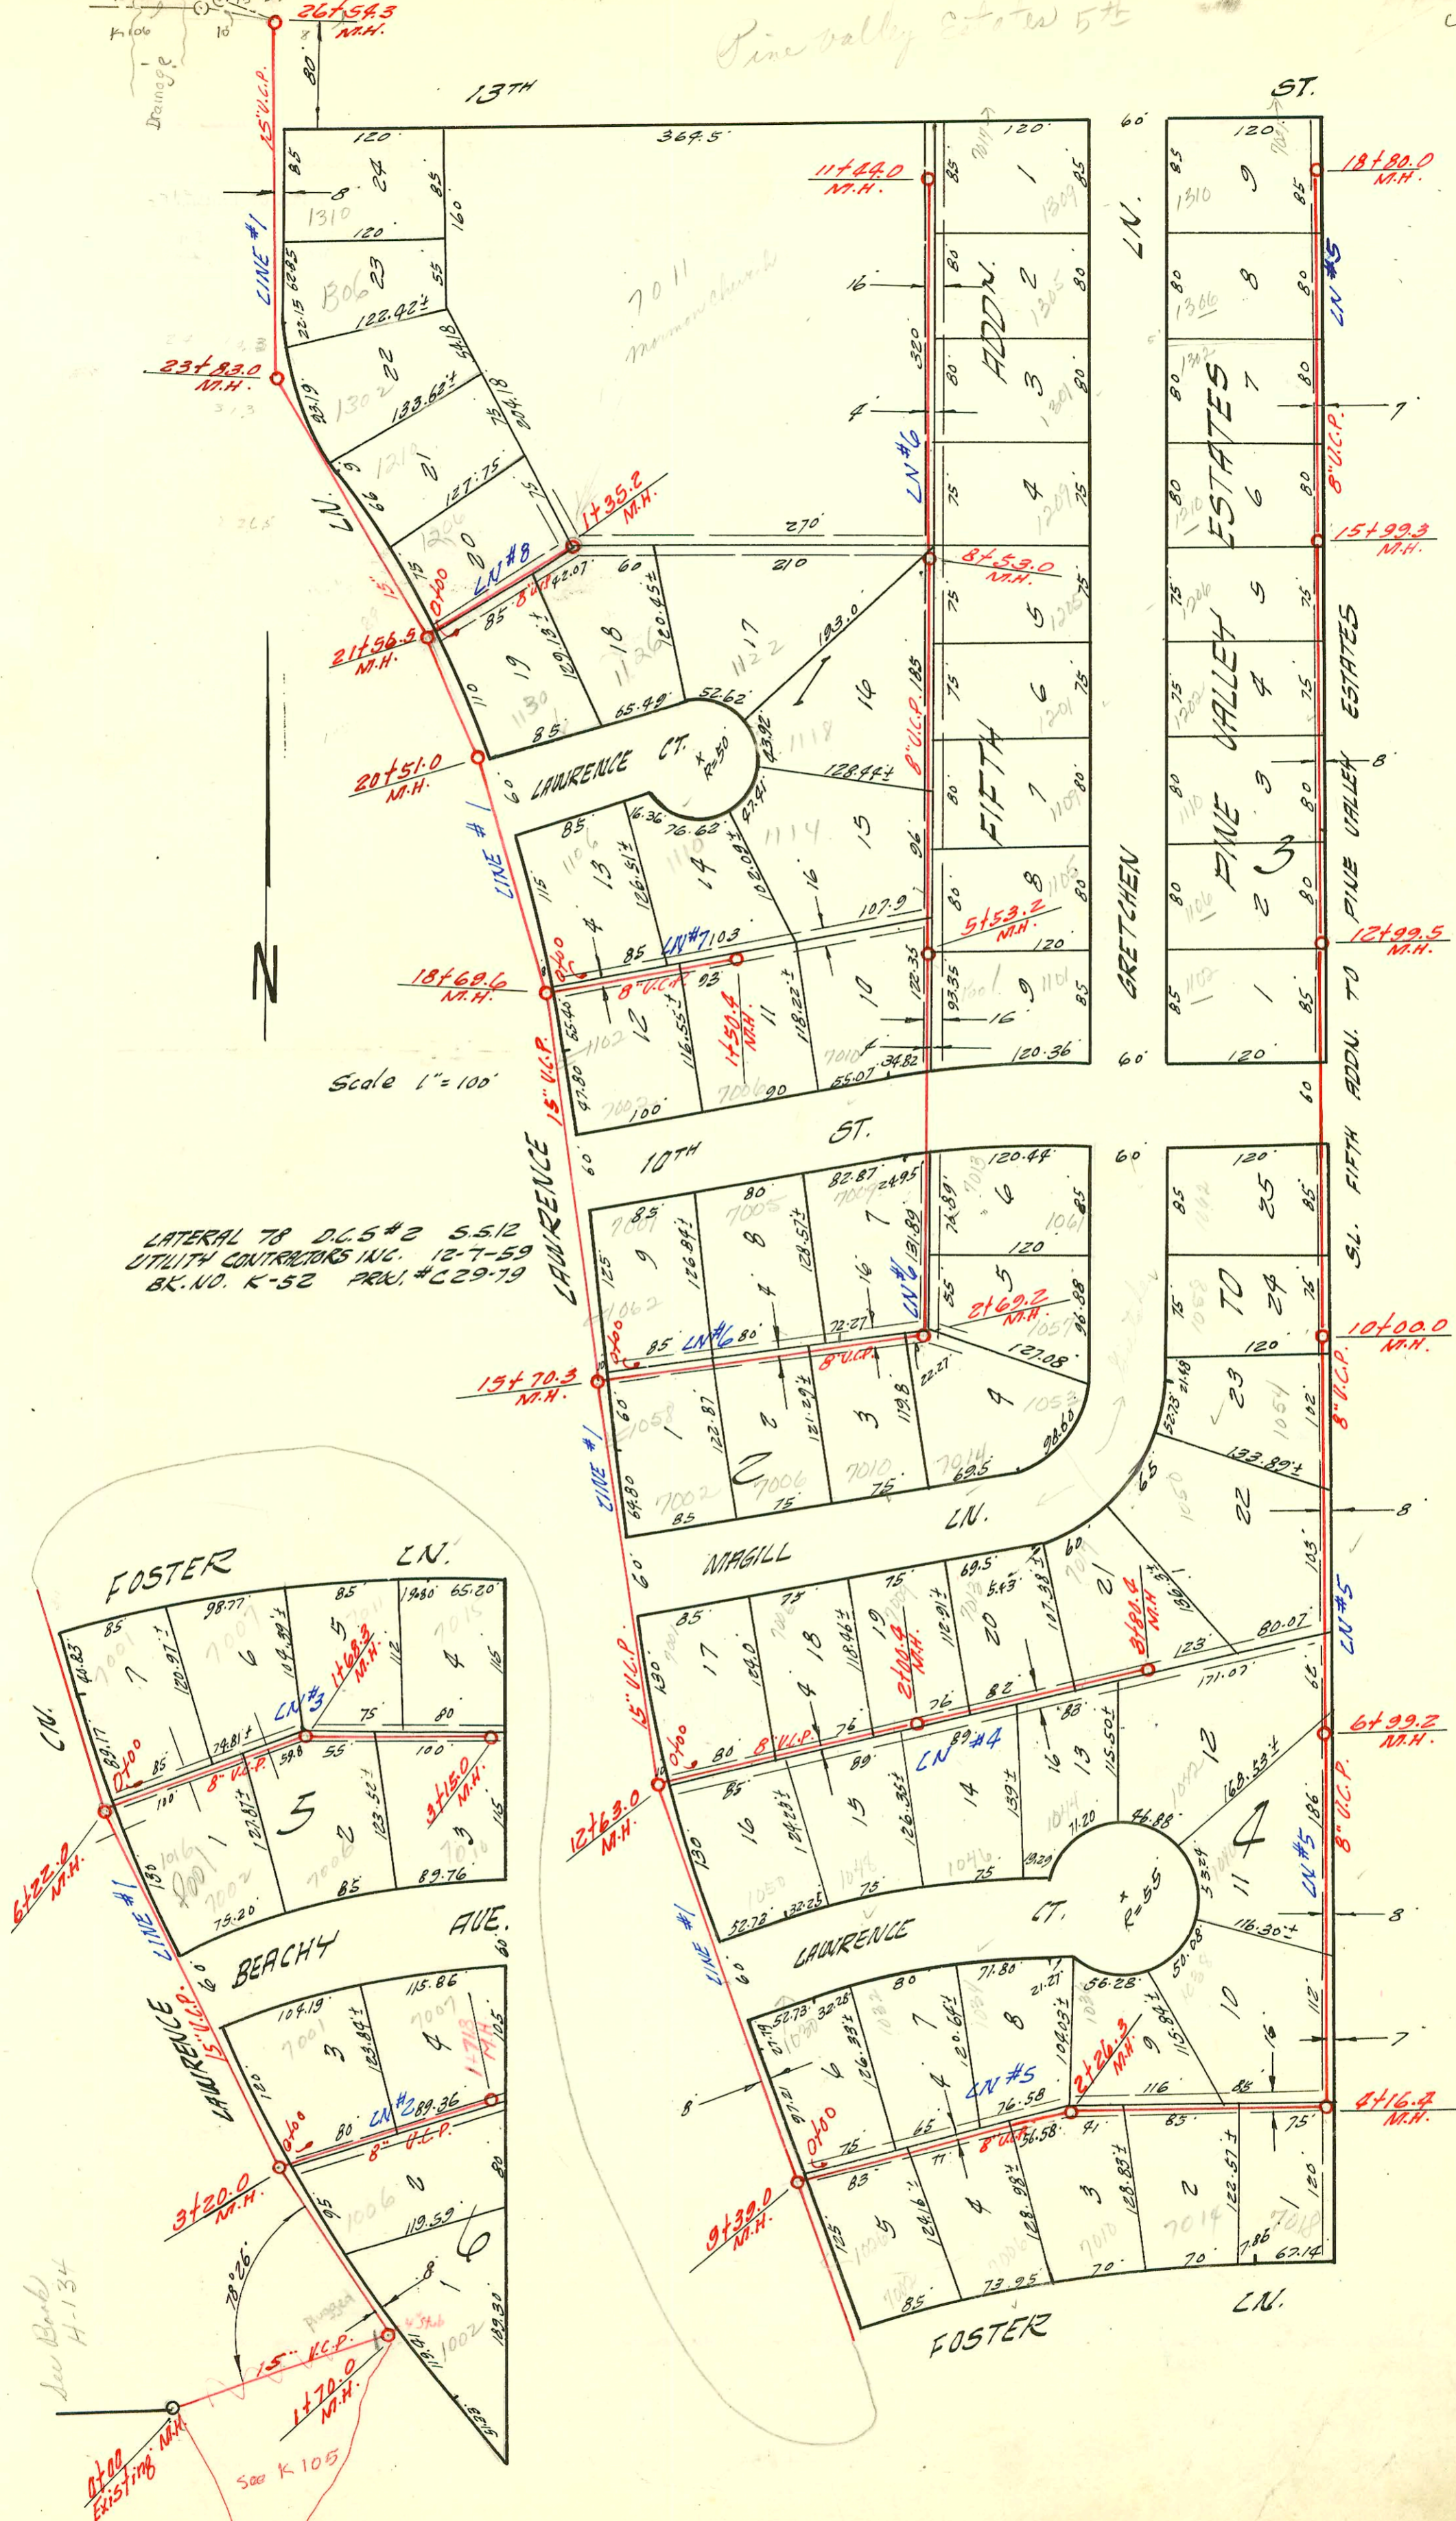

LATERAL TO D.C.S.#2 S.S.12
 UTILITY CONTRACTORS INC. 12-7-59
 BK. NO. K-52 PRK. #C29-79

Scale 1" = 100'

See Book H-134
 See K 105

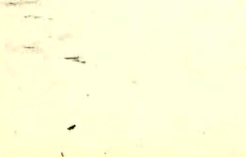

CONSTRUCTION RECORD						SERVICE RECORD						
STATION	ELEVATION		Depth	MANHOLE	4-INCH "Y" BRANCHES		No. of Permit		House Number		DATE OF PERMITS	
	Ground	Grade			North West	South East	North West	South East	North West	South East	North West	South East
3+00	180.0	171.29	8.7		+306	3+035	C1972		1044 Lawrence St			2-21-67
	183.2	171.61	11.6	3+80 ⁹		3+64 ⁹	B304		1040B Lawrence St			10-22-63
LINE #5 0+00	174.6	168.96	5.0	Existing M.H.	+267 +98 ²	+247	14212 B3517		1030 Lawrence St 1032 N Lawrence St			5-22-61
1+00	176.9	169.36	7.5		+63 ⁰	+05 ² +88 ⁰	B2676 15304		1034 N 7006 Lawrence St 1032 N Lawrence St			1-15-65 3-15-62
2+00	177.1	169.56	7.5			2+17 ⁰	13769		7010 Foster Ln			1-16-61
	177.3	169.86	7.4	2+26 ³	+41 ⁰	4" SCH 40 2+79 ⁰	B947 00571 12334		1936 N Lawrence St 7014 R Foster Ln			3-2-64 6-28-61 2-18-60
3+00	179.0	170.91	8.1		2+91 ⁰	3+58 ⁰	B618 12244		1038 Lawrence St 9018 Foster Ln			12-31-63 1-28-60
4+00	183.1	172.31	10.8			West Y +432						
	184.1	172.55 (CN) 172.57	11.5	4+16 ⁴		East E						
5+00	184.4	173.81	10.6			+42 ¹						
6+00	185.6	175.21	10.4			+29 ⁰						
7+00	186.8	176.61 177.00	10.2 9.8	6+99 ²		+34 ⁰ 9+22 ⁵	13121		1050 Kitchen			7-27-60
8+00	188.5	178.60	9.9			+39 ⁴						
9+00	190.0	180.20	9.8			+02 ⁰	18087		1054 Kitchen			7-15-60
10+00	191.6	181.80	9.8	10+00 ⁰		+09 ⁰ +75 ⁰	16813 17433 15099		1058 Kitchen 1062 Kitchen			8-7-86 7-23-63 1-12-62
11+00	192.5	182.30	10.2			+18 ⁵	14533		1102 Kitchen			8-7-61
12+00	193.0	182.80	10.2			+09 ³ 13+84 ⁰	15707 B 1581		1106 Kitchen 1110 Kitchen			6-4-62 6-29-64
13+00	193.1	183.30	9.8	12+99 ⁵		+66 ⁵	1012864		1202 Kitchen			2-20-69
14+00	193.1	183.80	9.3			+36 ⁶	B.219		1206 Kitchen			10-2-63
15+00	193.5	184.30	9.2			+14 ⁷ +89 ⁶	15708 17238		1210 Kitchen 1302 Kitchen			6-4-62 6-10-63
16+00	194.6	184.80	9.8	15+99 ²		+72 ⁰	16658		1306 Kitchen			2-14-63
17+00	195.1	185.30	9.8			+46 ²						
18+00	195.6	185.80	9.8									
19+00	196.4	186.18	10.2	18+80 ⁰								
LINE #6 0+00	177.5	171.16	6.3	Existing M.H.		+35 ⁰ (W) +37 ⁰ (E)	#15679 13592		1062 Lawrence St 7002 Magill			5-28-62 12-7-60
1+00	179.0	171.66	7.3			+19 ⁰ (W) +21 ⁰ (E) 4" SCH 40 4" SCH 40 1+92 ⁰ (N) 1+94 ⁰ (S)	#14795 13593 #2005 13704		7005 7006 104 7009 1010 R Magill E 10th			10-6-61 12-7-60 4-5-00 12-17-60 9-1-00
2+00	179.9	172.16	7.7			+57 ⁰ (E)	13531		7014 Magill			11-4-60
	182.2	172.51 (CN) 172.57	9.7 9.6	2+69 ²		+88 ⁰	16342		1057 Kitchen			11-13-62
3+00	182.7	172.76	9.9			+43 ⁰	14315		1061 Kitchen			6-20-61
4+00	183.3	173.26	10.0			+87 ⁰	#14739		1101 Kitchen			9-26-61
5+00	182.7	173.76	8.9									

14533 top - 1102 Kitchen - Reynolds Reg - 8-7-61 12+56.5
 # 15098 top - 7002 Foster Ln - J. Kelly - 1-31-62 (5+45)
 # B505 top - 1310 Kitchen - Reynolds Reg - 2-7-64 (18+59) #2000-00462 - 6" SCH 40, Tied back to clay tile, 2-way co
 # B1691 top - 1040 Lawrence St - Reynolds Reg - 7-23-64 (5+85.2)

