


LATERAL 141 SUB. 5 S.S. 22
 UTILITY CONTRACTORS INC. FEB 26 '60
 BK. NO. K-51A PROJ. NO. C29-108

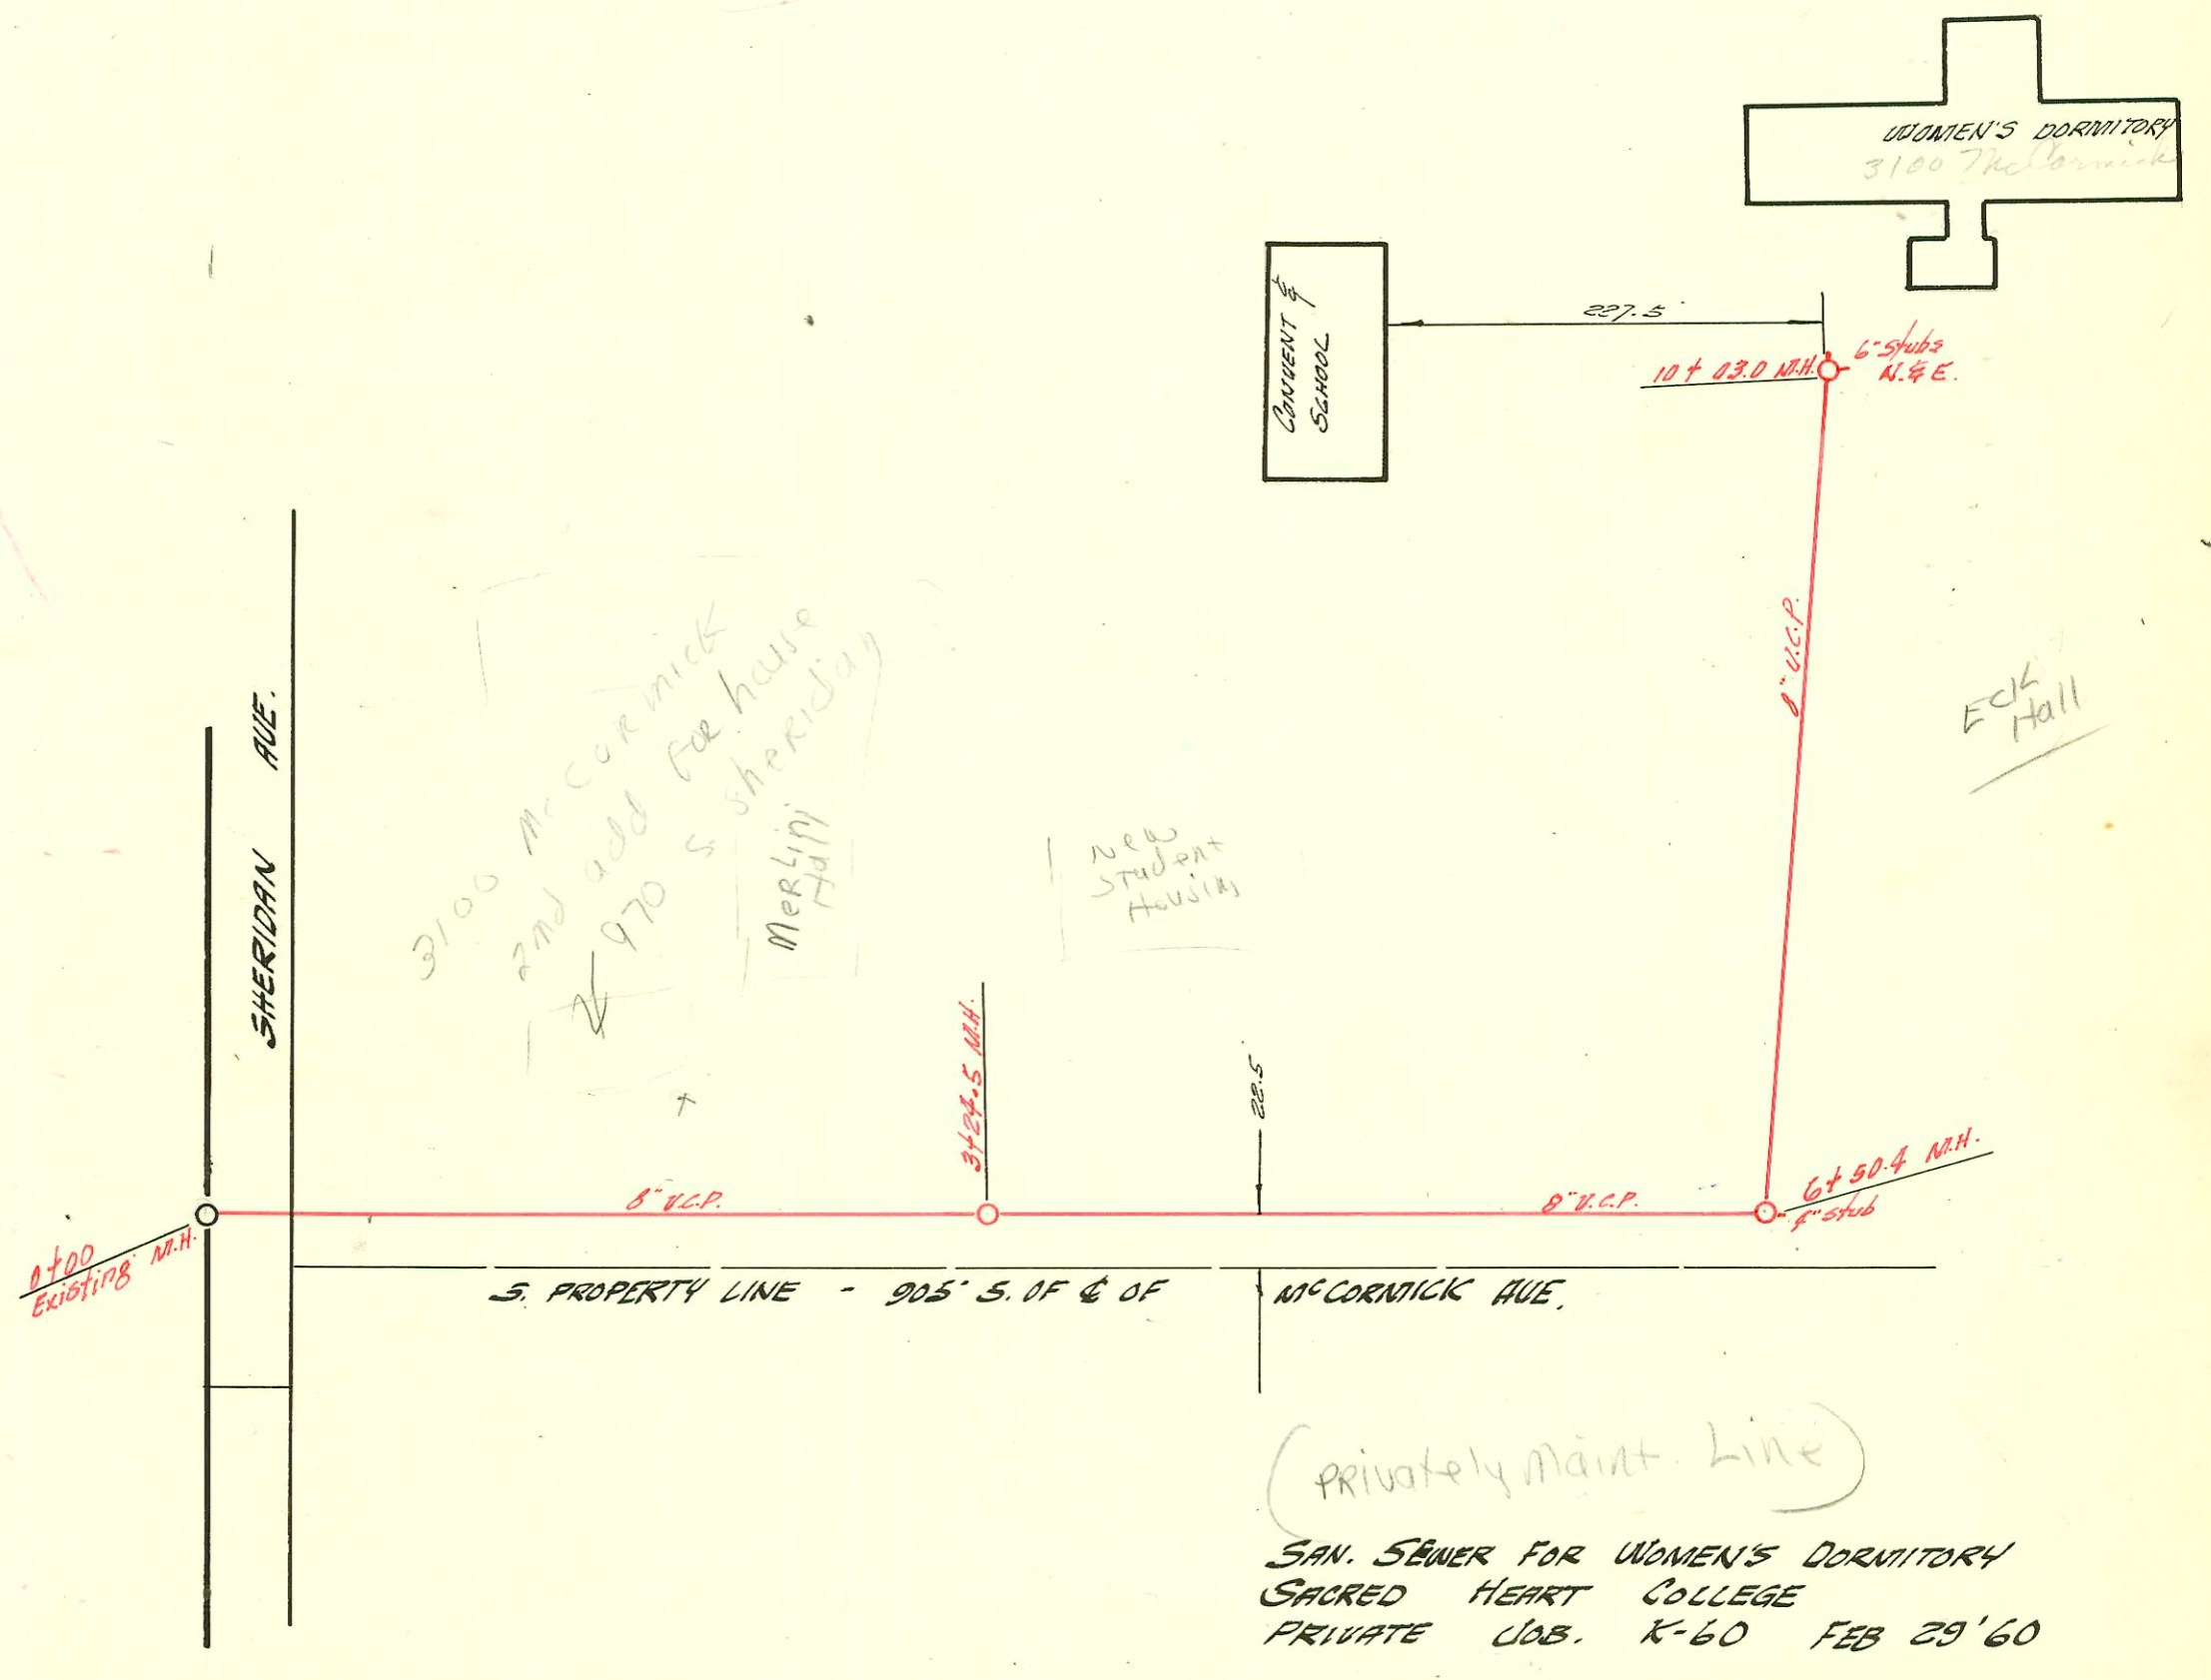

(Privately Maint. Line)
 SAN. SEWER FOR WOMEN'S DORMITORY
 SACRED HEART COLLEGE
 PRIVATE JOB. K-60 FEB 29 '60

