


LATERAL 79 SUB. 5 S.S. 22
 MID-STATES CONSTRUCTION CO. MARCH 15/60
 BK. NO. K-52 PROJ. NO. C28-97



LATERAL 134 SUB. 5 S.S. 22
 W. B. CARTER'S CONSTR. CO. 3-17-60
 BK. NO. K-51 PROJ. NO. C29-93

SCALE 1"=150'

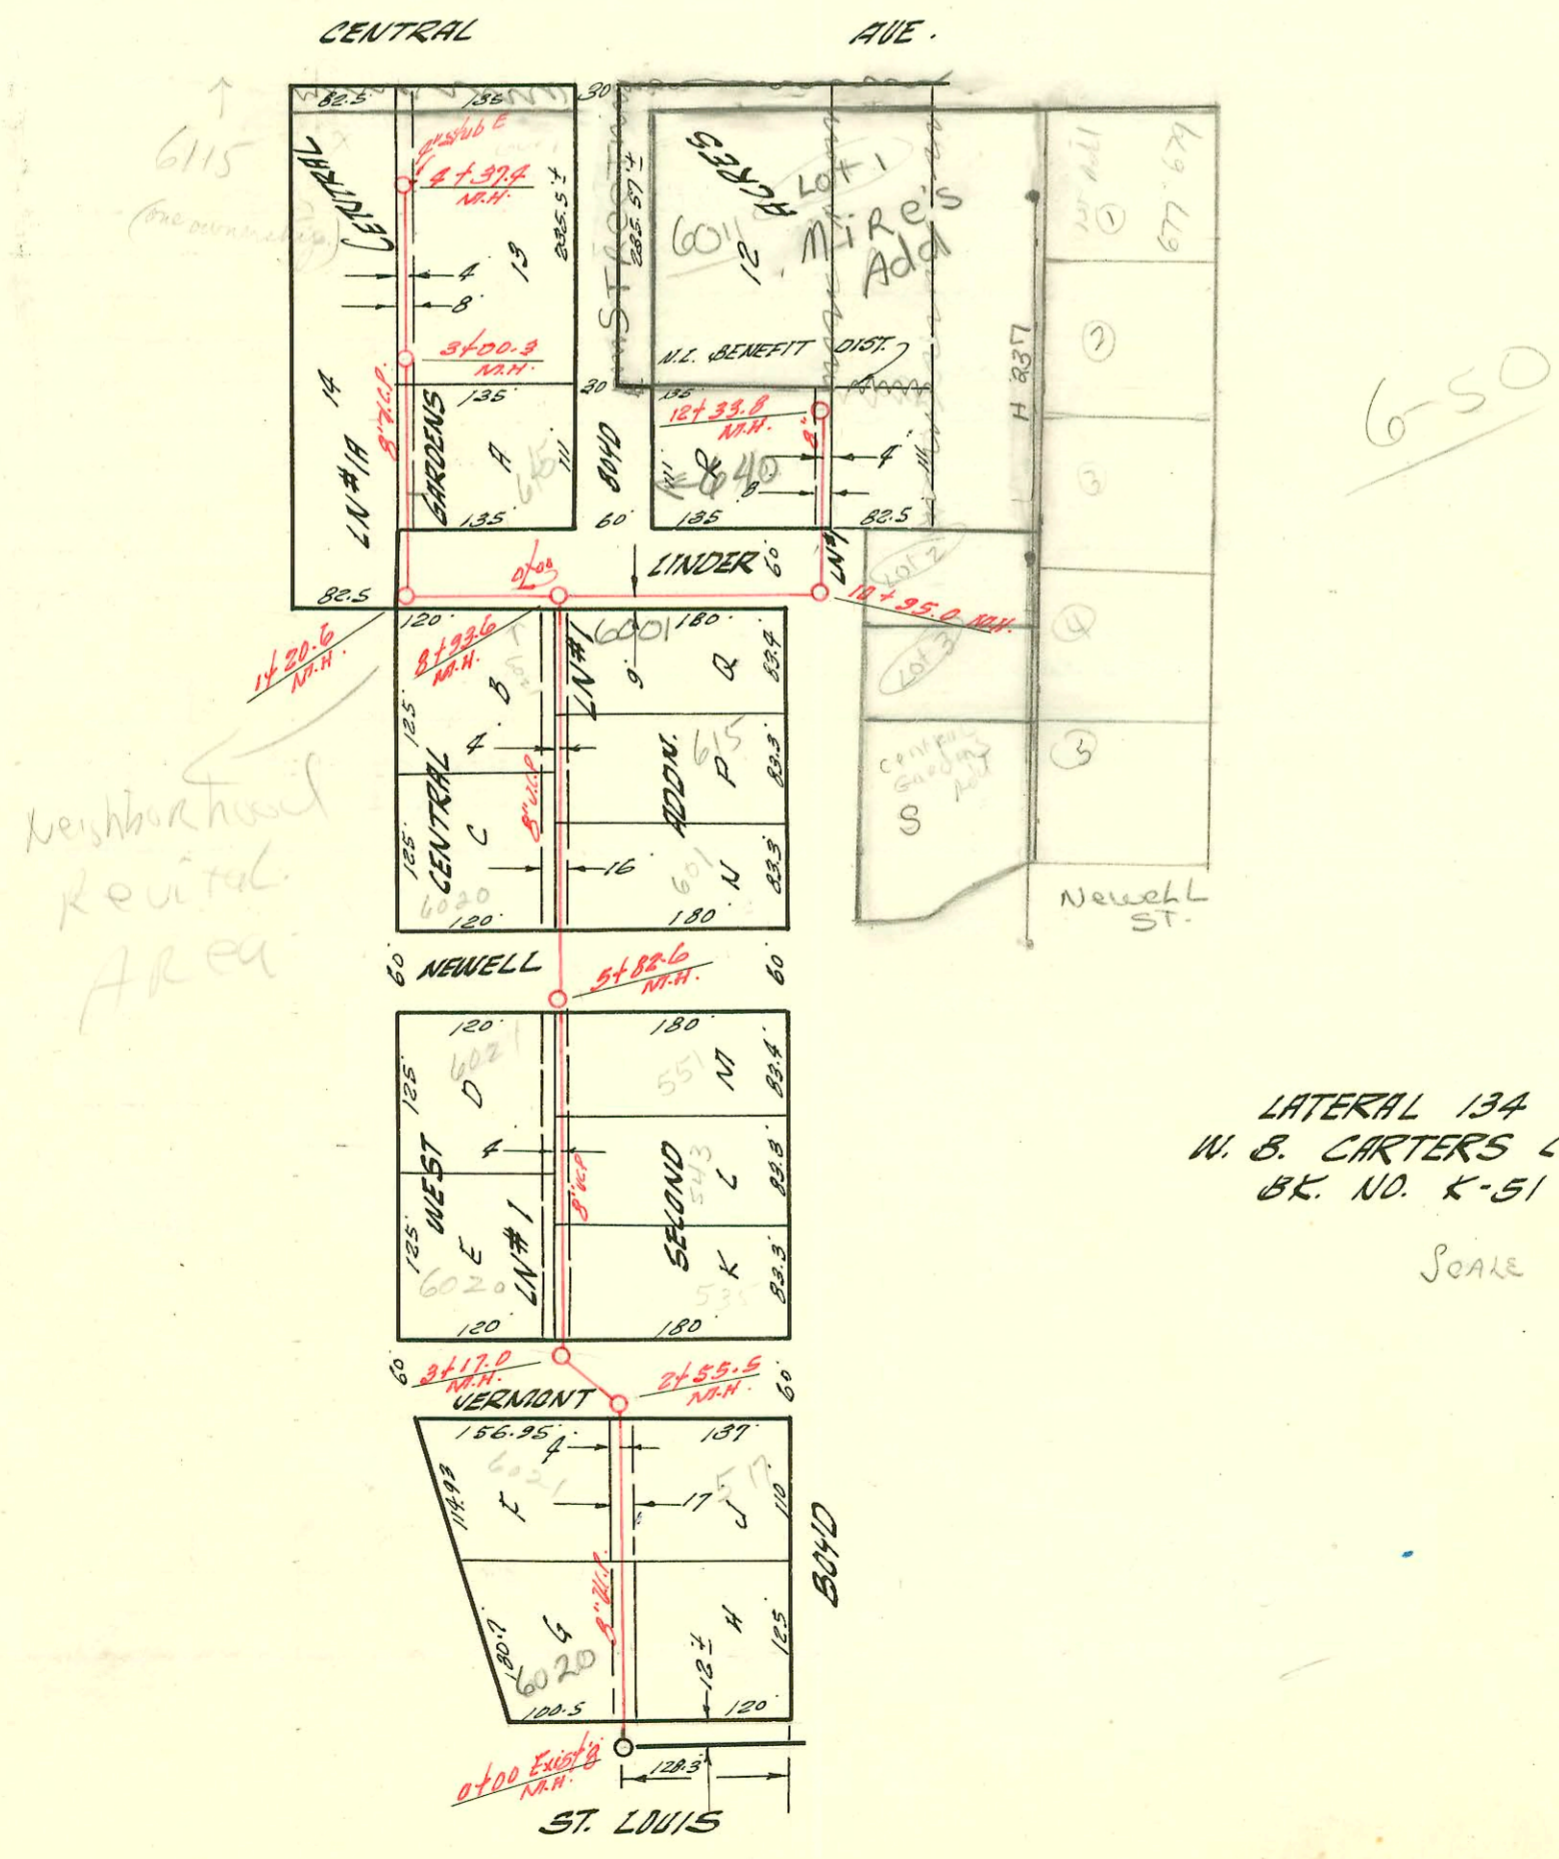