



Ray Yarbrow Jr  
 Homeowner called  
 9/16/66. Col  
 sewer info.  
 He said he was  
 going to only dig  
 to see if any  
 part needed  
 repair.  
 6'

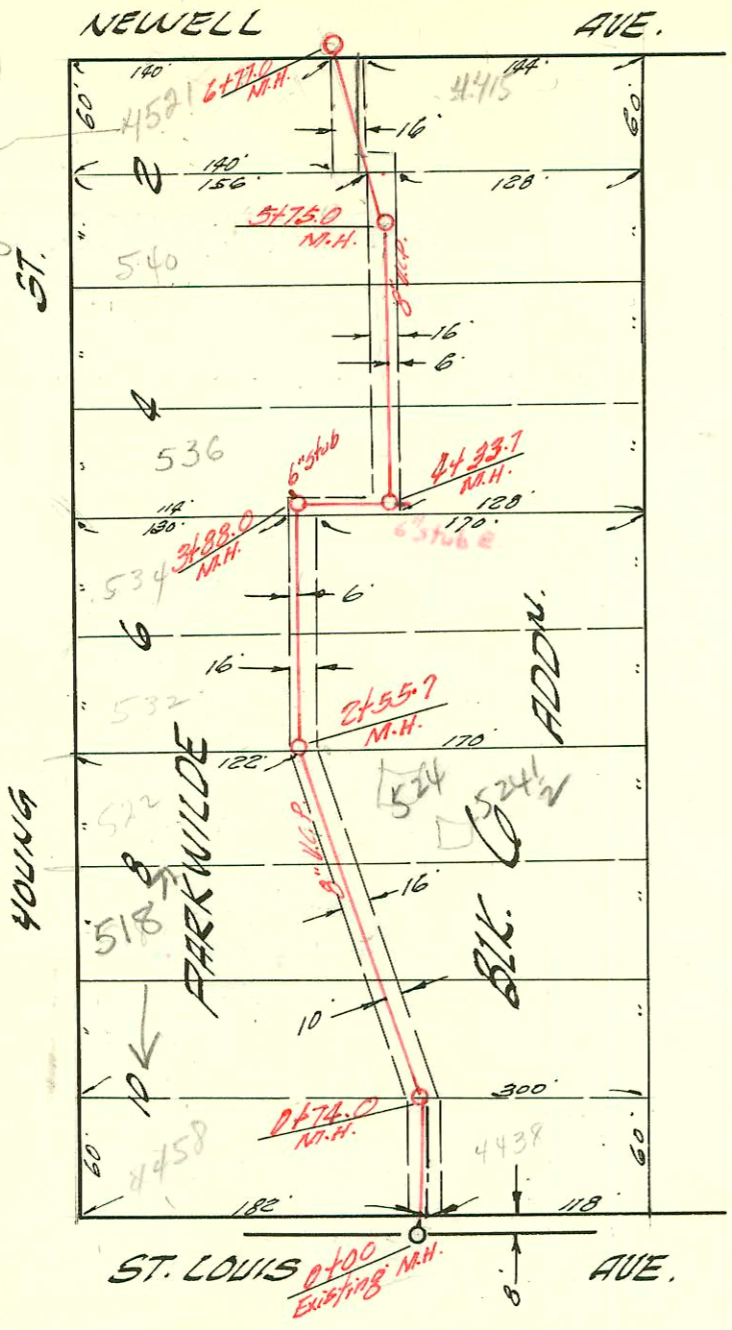

LAT. 82 SUB. 5 S.S. 22  
 W.B. CARTER CONST. CO. 4/15/60  
 BK. NO. K-53 PROJ. NO. C28100

Homeowner  
 avail.

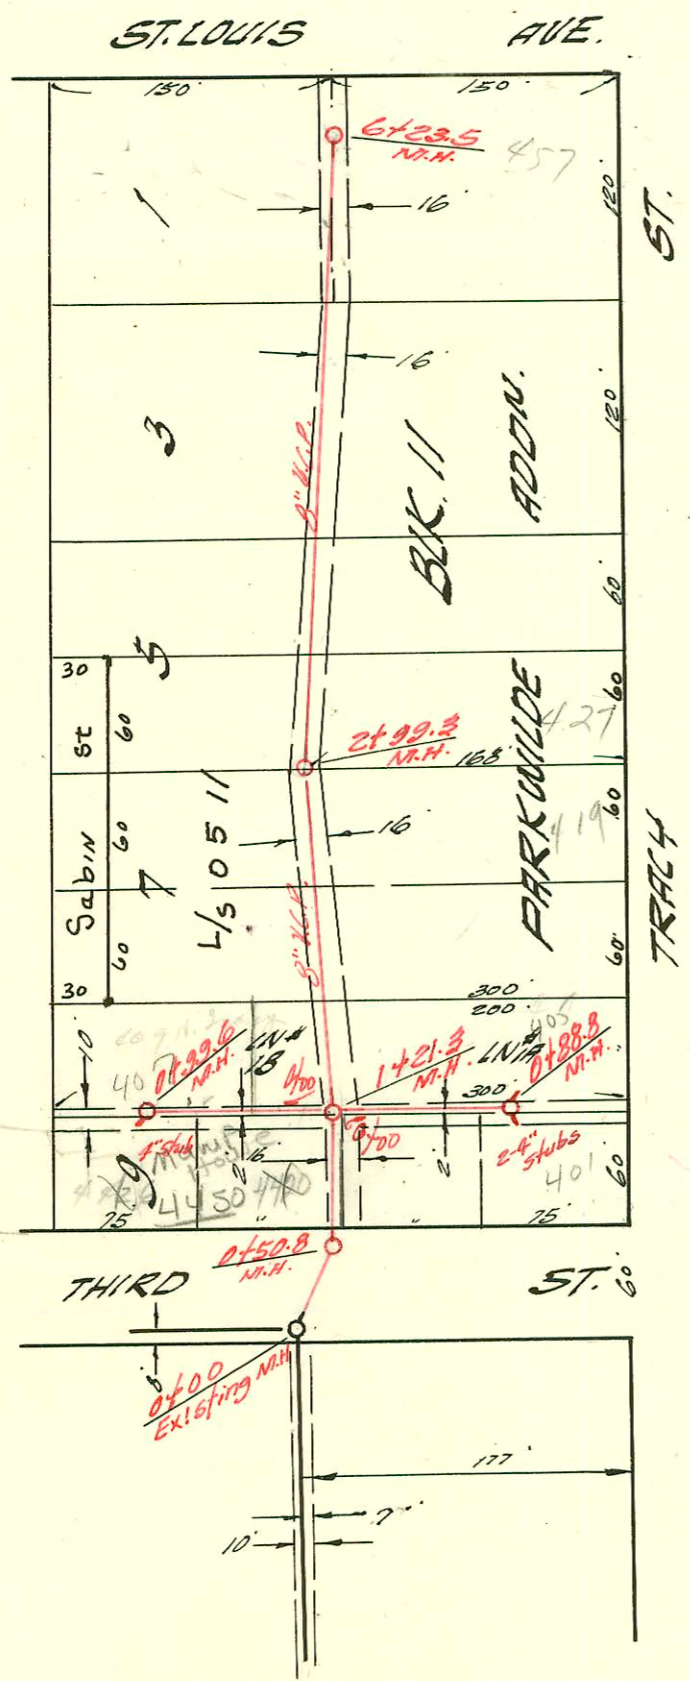

LAT. 67 SUB. 5 S.S. 22  
 MID-STATES CONST. CO. 4/15/60  
 BK. NO. K-45B PROJ. NO. C2874

N

