



36"-29"th

LAT. 94 SUB. 5 S.S. 22
 UTILITY CONSTR. CO. APRIL 18'60
 BK. NO. K-52 PROJ. NO. C28-123

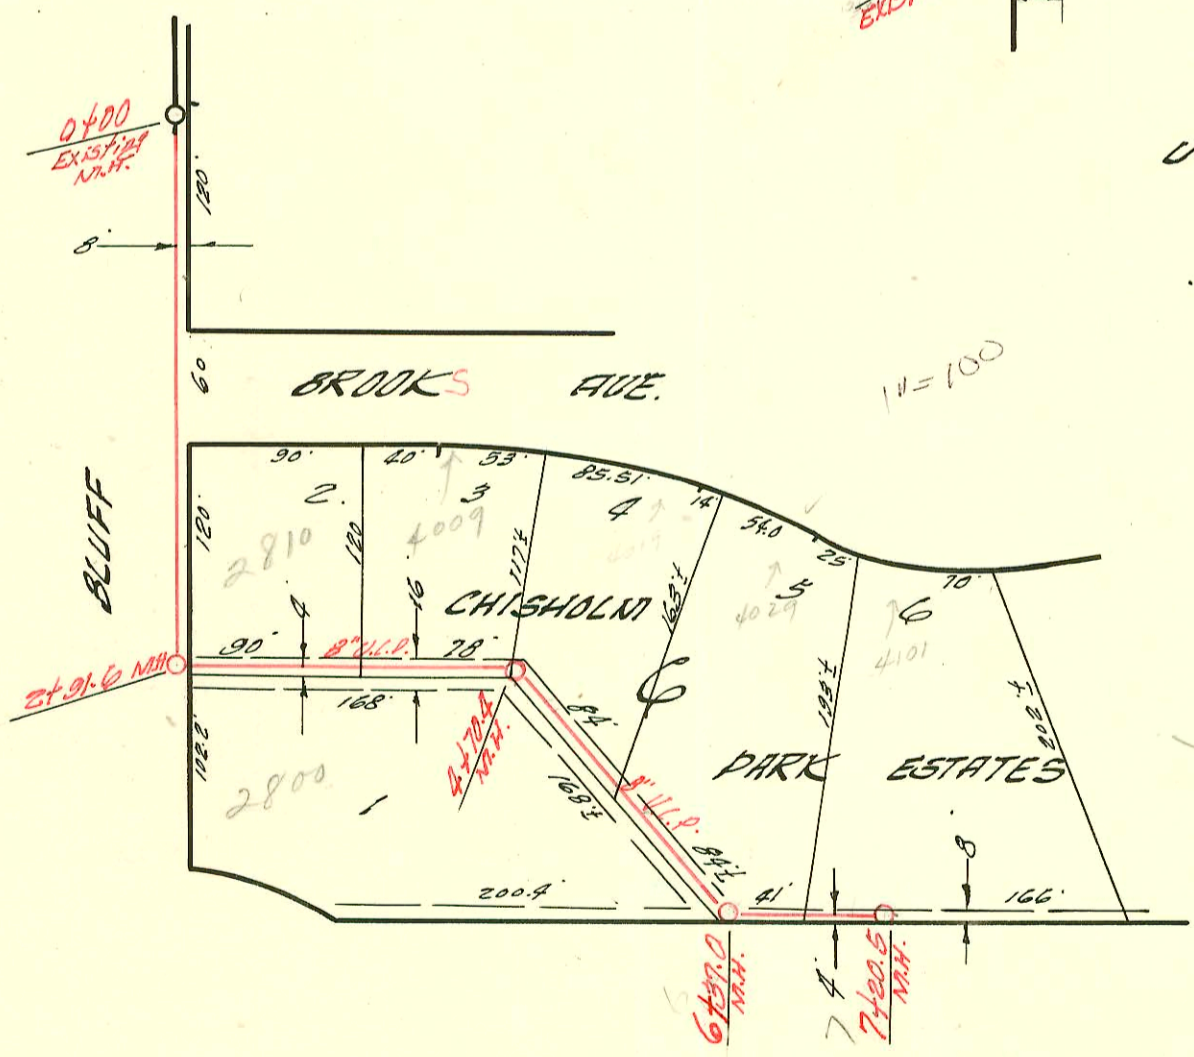

27"th

LATERAL 18 SAN. SEWER 23
 MID-STATES CONSTR. CO. APRIL 18'60
 BK. NO. K-45A PROJ. NO. C29-94

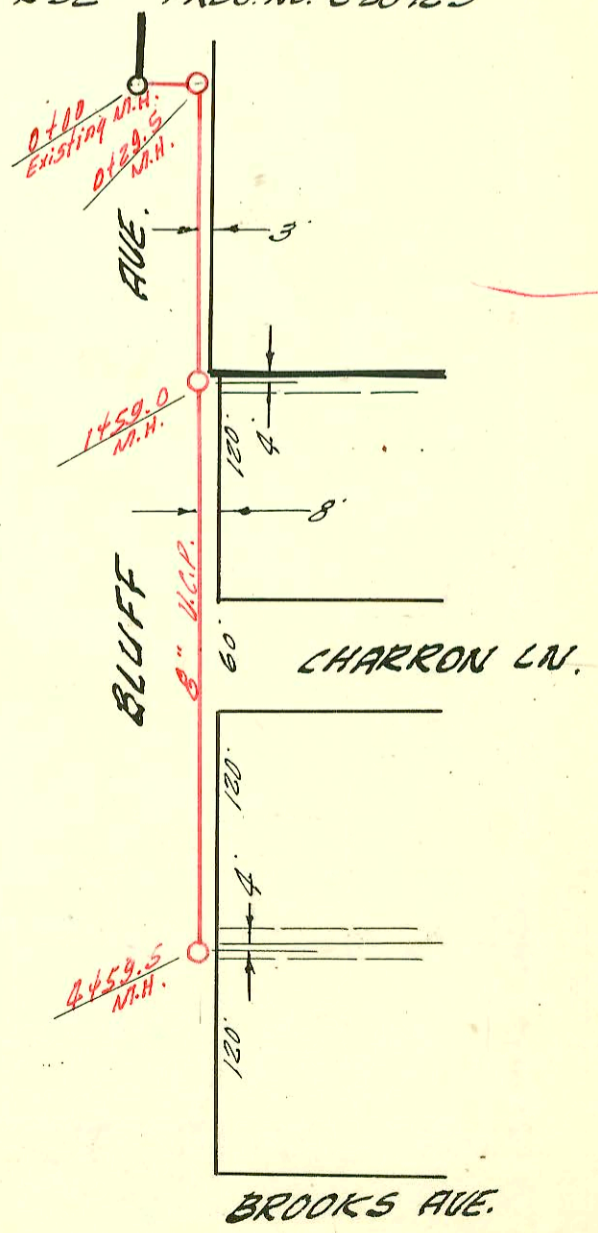

EXT. OF LAT. 9 S.S. 23
 PRIVATE CONTRACT
 BK. NO. K-45A
 APRIL 18'60

