



Florence Street

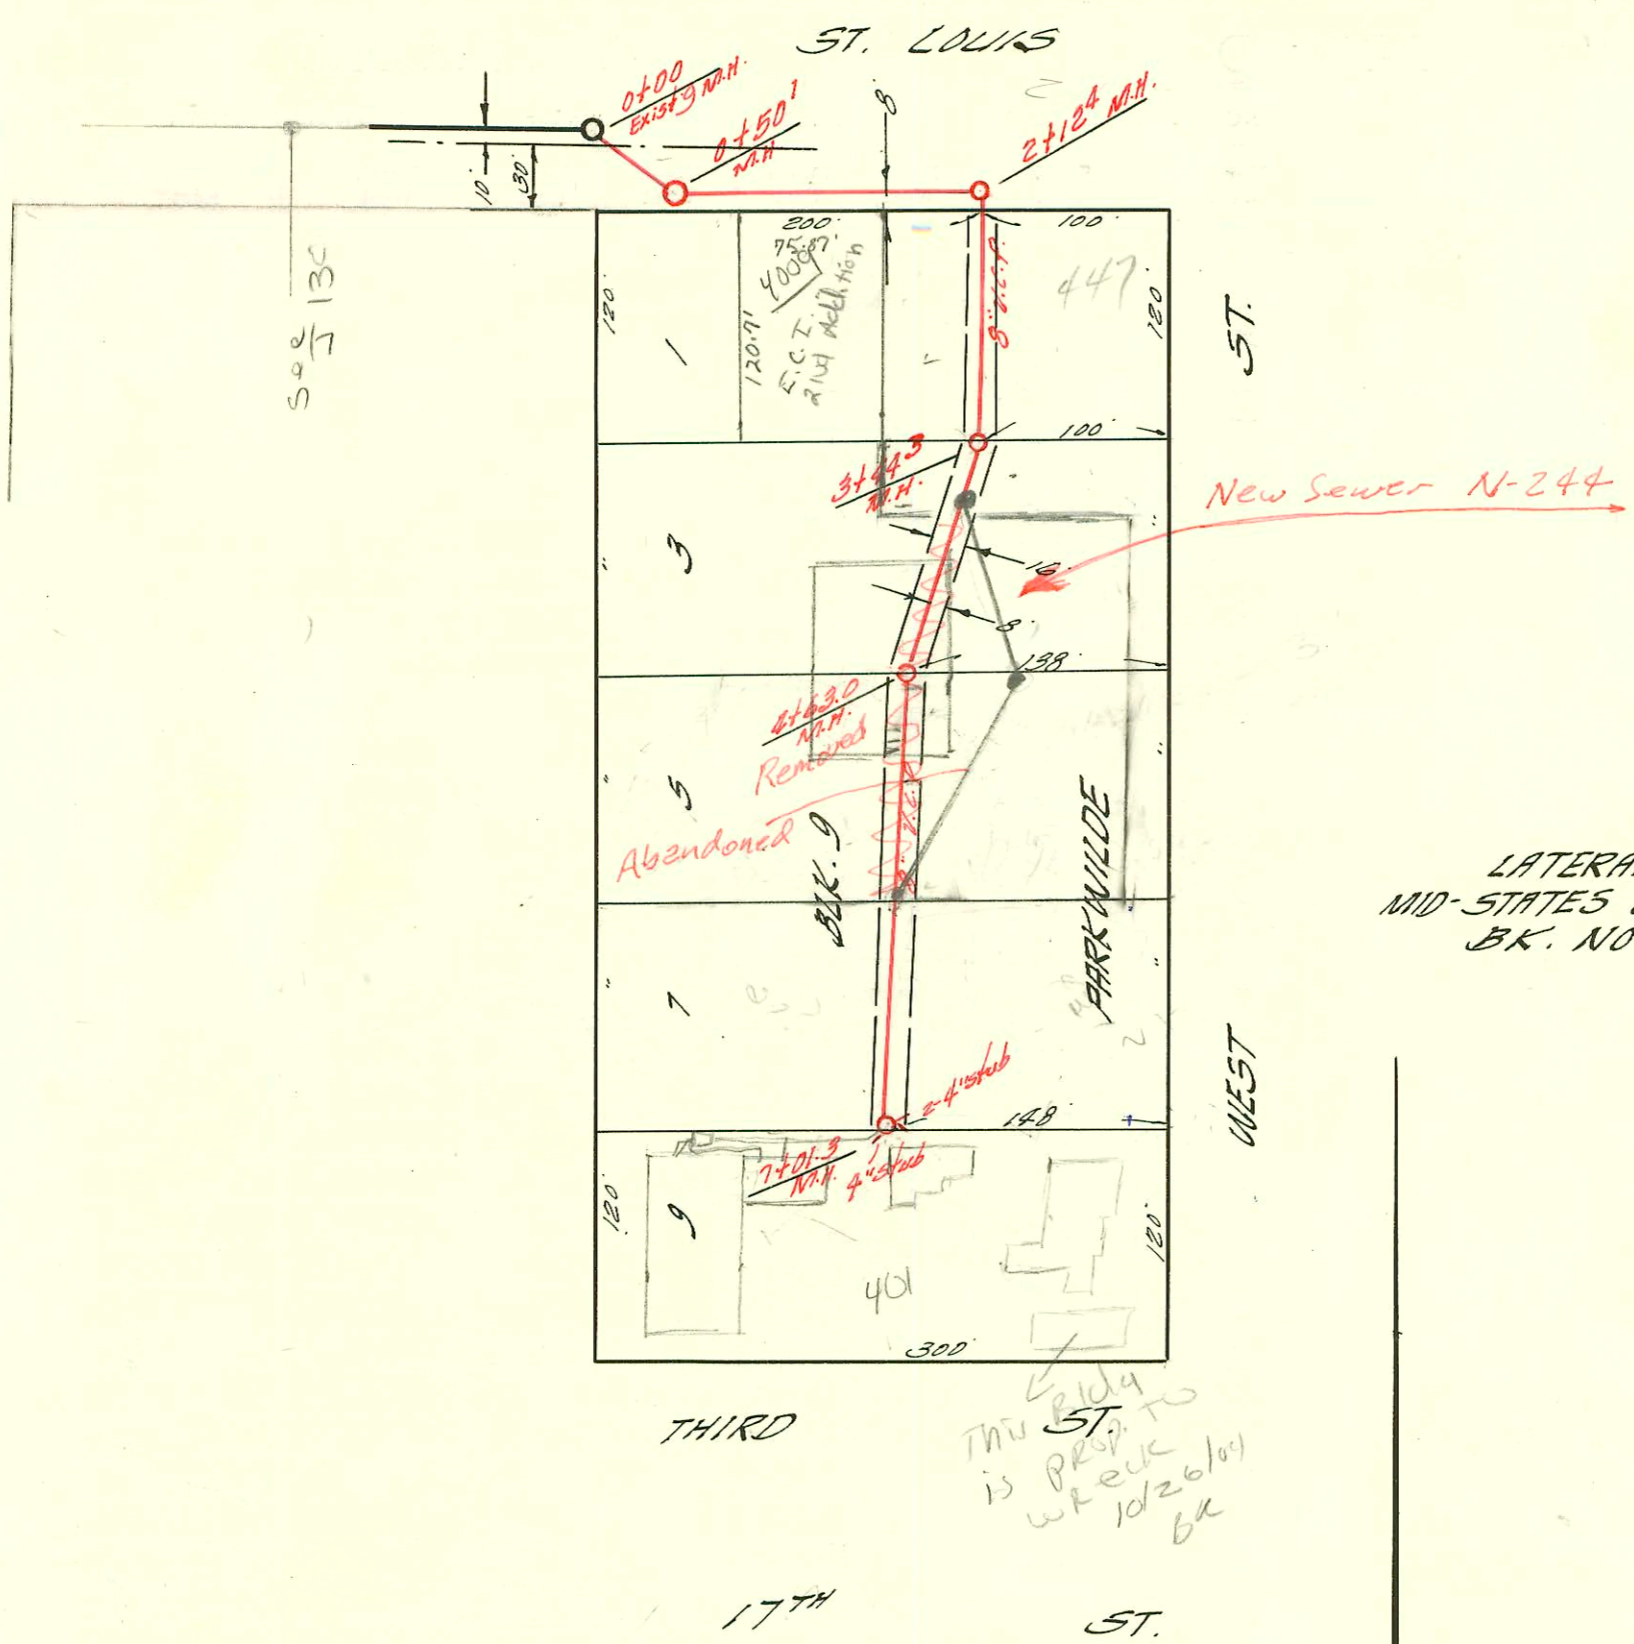

LATERAL 143 SUB. 5 S.S. 22  
 MID-STATES CONSTR. CO. MAY-27-60  
 BK. NO. K-53 PROJ. NO. C 20-10

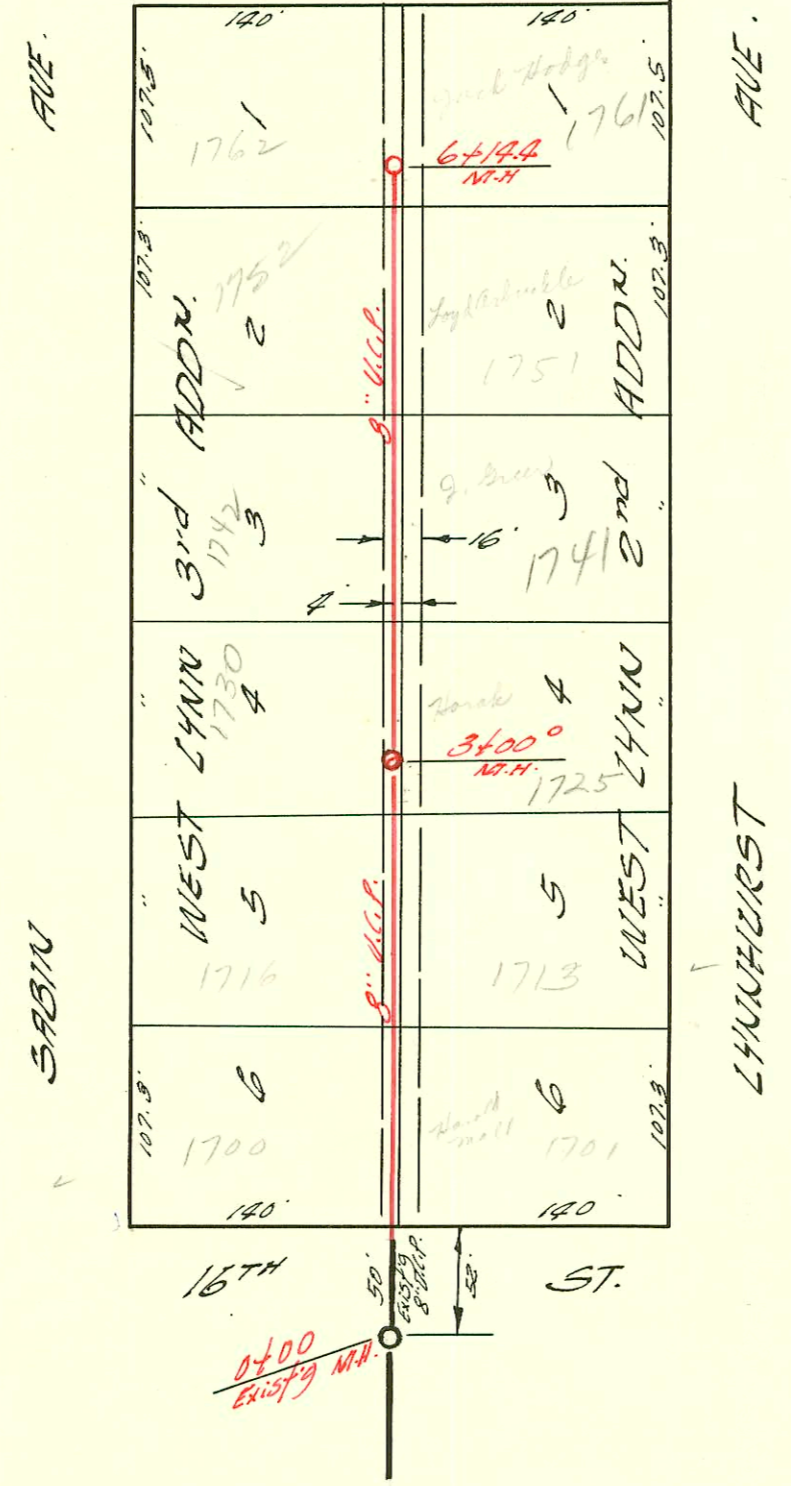

LATERAL 78 SUB. 5 S.S. 22  
 MID-STATES CONSTR. CO. MAY-27-60  
 BK. NO. K-46 PROJ. NO. C28-96

D 8577-1  
 D 8577



CONSTRUCTION RECORD						SERVICE RECORD						
STATION	ELEVATION		Depth	MANHOLE	4-INCH "Y" BRANCHES		No. of Permit		House Number		DATE OF PERMITS	
	Ground	Grade			North West	South East	North West	South East	North West	South East	North West	South East
0+00	119.2	113.75	5.4	Existing MH.								
	119.6	113.85	5.7	+50'								
1+00	118.8	114.05	4.7									
2+00	118.6	114.25	4.3									
	118.9	114.36	4.5	2+12.4								
3+00	119.7	114.55	5.1									
	120.0	114.64	5.4	3+44.3								
4+00	120.0	114.75	5.3									
	120.6	114.88	5.7	4+63.0								
5+00	120.7	114.96	5.7									
6+00	120.1	115.15	4.9									
7+00	119.9	115.35	4.5									
		115.35		7+01.3								
8+00	128.2	119.49	8.7	Existing MH.								
1+00	128.8	119.79	9.0									
2+00	129.9	120.09	9.8									
3+00	130.5	120.39	10.1	3+00.0								
4+00	132.0	120.69	11.3									
5+00	132.0	120.99	11.0									
6+00	131.8	121.29	10.5									
	131.6	121.34	10.3	6+14.4								

#12856 Tap - 439 N. West (front) Downer Alley, 5-31-60 (5+22.5)