

Turquoise Drive

Sta. 52+00

M.H. 46+86.7 H
= 44+19.0 BX

18" Tile

41+10 M.H.

18" Tile

39+00 M.H.

18" Tile


18" Tile

Sta. 31+00

67+39
M.H.

18" Tile

See Letter
att: 8.136

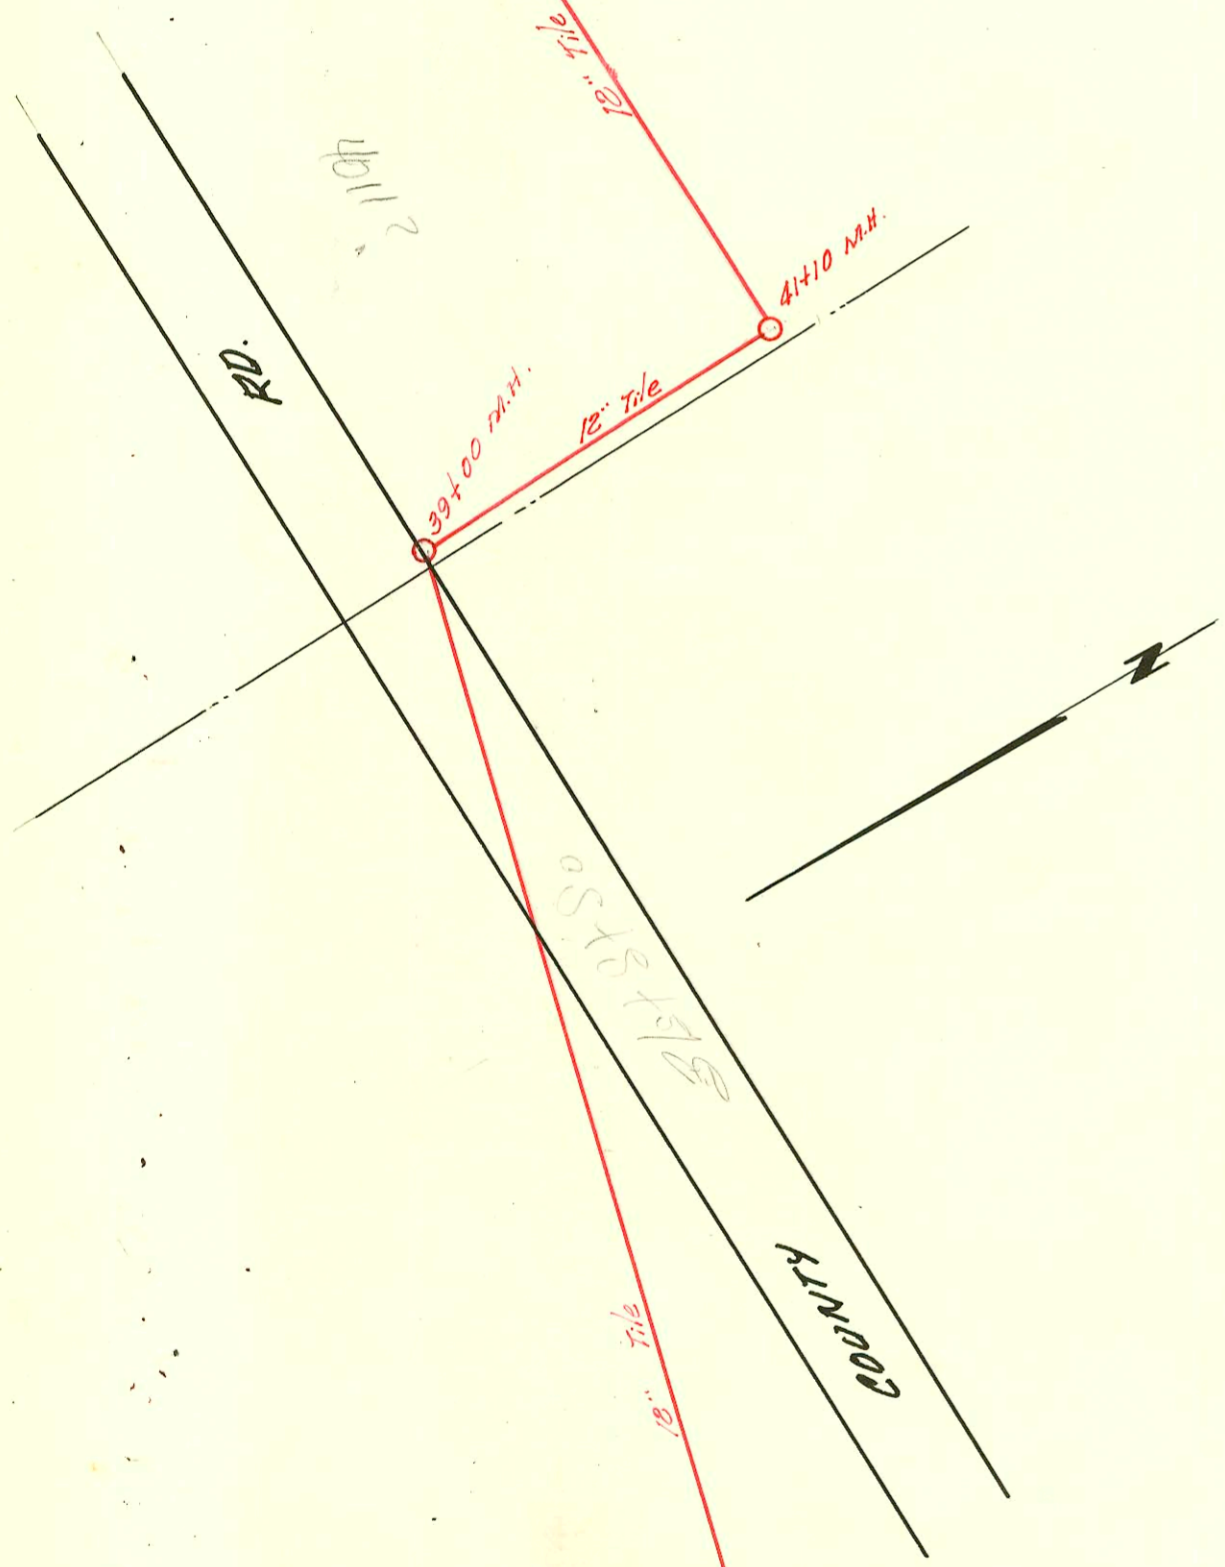

Boeing Commercial Airplane Group -
Muffin Monster - Plant 1
Project No. 790 PPS
Built By Eby Construction
Booked 3-24-99 As Built Plans

54+60 ±
M.H. TOP 1' DI
38' N & 10' E NE CORNER
Tool F26 Bldg.
Top 161.66
FL 155.13

52+40 ±
Vault with Sewage Grinder
Top 165.4 FL 153.70 OUT
FL 153.77 IN

52+25 ±
EXIST. M.H.

Sta. 52+00

CONSTRUCTION RECORD						SERVICE RECORD						
STATION	ELEVATION		Depth	MANHOLE	4-INCH "Y" BRANCHES		No. of Permit		House Number		DATE OF PERMITS	
	Ground	Grade			North West	South East	North West	South East	North West	South East	North West	South East
31+00	147.0	141.57	5.4									
32+00	148.0	142.17	5.8									
33+00	149.2	142.77	6.4									
34+00	150.8	143.37	7.4									
35+00	152.9	143.97	8.9									
36+00	155.2	144.57	10.6									
37+00	158.0	145.17	12.8									
38+00	160.8	145.77	15.0									
39+00	161.5	146.37	14.1	39+00								
40+00	162.3	146.97	15.3									
41+00	162.3	147.63	14.7	41+10								
42+00	162.2	148.23	14.0	<i>see permit?</i>			16462		HOLE 3125		6-13-86	
43+00	162.1	148.83	18.3									
44+00	160.5	149.48	11.0	44+19.0 = 3 Equations 46+86.7								
47+00	160.5	149.57	10.9									
48+00	160.2	150.16	10.0									
49+00	161.4	150.77	10.6									
50+00	161.4	151.36	10.4									
51+00	160.6	151.97	8.6									
52+00	160.1	152.57	7.5				23925		3552 S. TURNPIKE DR	(Being Enlargement)	9-21-89	
53+00	160.7	153.17	7.5									
54+00	162.2	153.77	8.4									
55+00	163.7	154.37	9.3									
56+00	165.2	154.97	10.2									
57+00	167.6	155.57	12.0									
58+00	166.9	156.17	10.7									
59+00	166.9	156.77	10.1									
60+00	166.1	157.37	8.7									
61+00	166.3	157.97	8.3									
62+00	168.2	158.56	9.6									
63+00	167.4	159.17	8.2									
64+00	169.4	159.77	9.6									
65+00	170.1	160.37	9.7									
66+00	170.1	160.97	9.1									
67+00	171.0	161.57	9.4									
68+00	171.4	161.71	9.7	67+89								
69+00	172.9											

91-018939-7
 # 27181 - 31191 - 3300 S. TURNPIKE DR - N/C - (131' N.W. of Hydrant or 103' SE. of center of road 4" C.I.)