



LATERAL 13 SUB. 5A W.I.S.  
W.B. CARTER CONSTR. CO. 8-17-60  
BK. NO. K-91 PROJ. NO. C 20-32

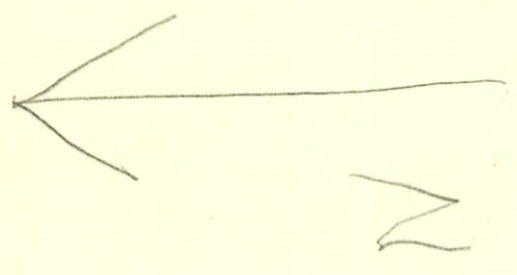

NO NEW CONN TO CITY SEWER  
BY MUST EXTEND PER CH. ENGS. FILE  
FOR MATHS ADD LOT 3

25' x 8' 6\"/>

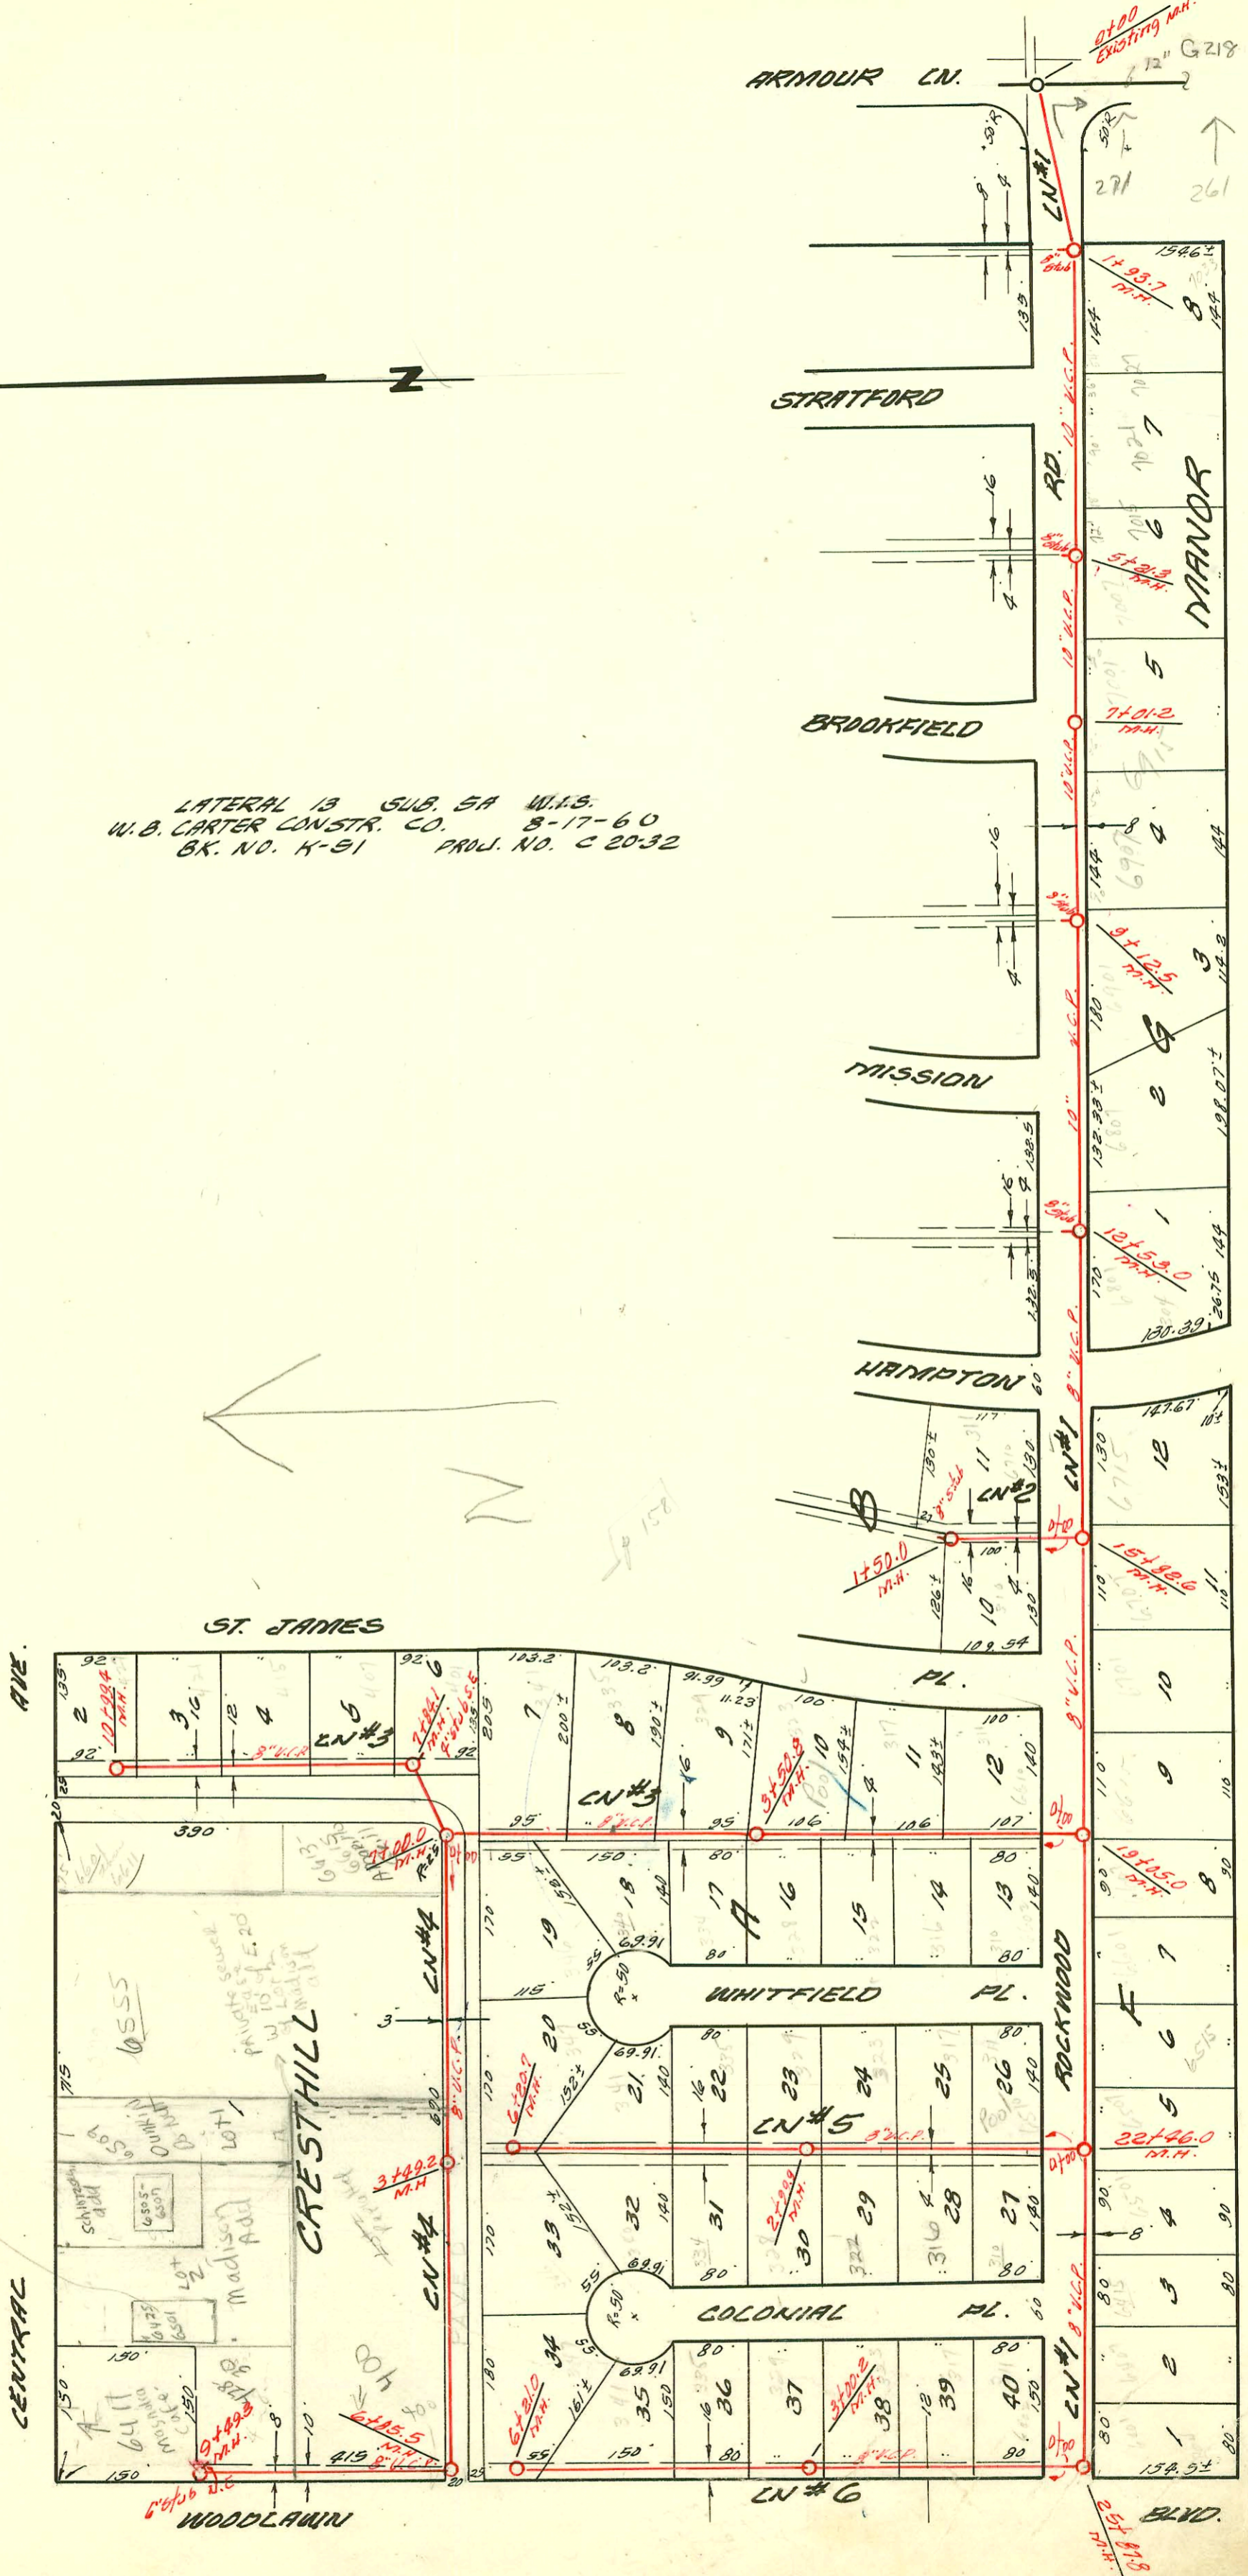

2001-00837-4/11/01 - 311 N Hampton Rd - Roto (Pipe Burst Repl) 4" SCH40 - Predco - 70' N of HH0+00 (0+70) 2V45