


E CENTRAL AVE.

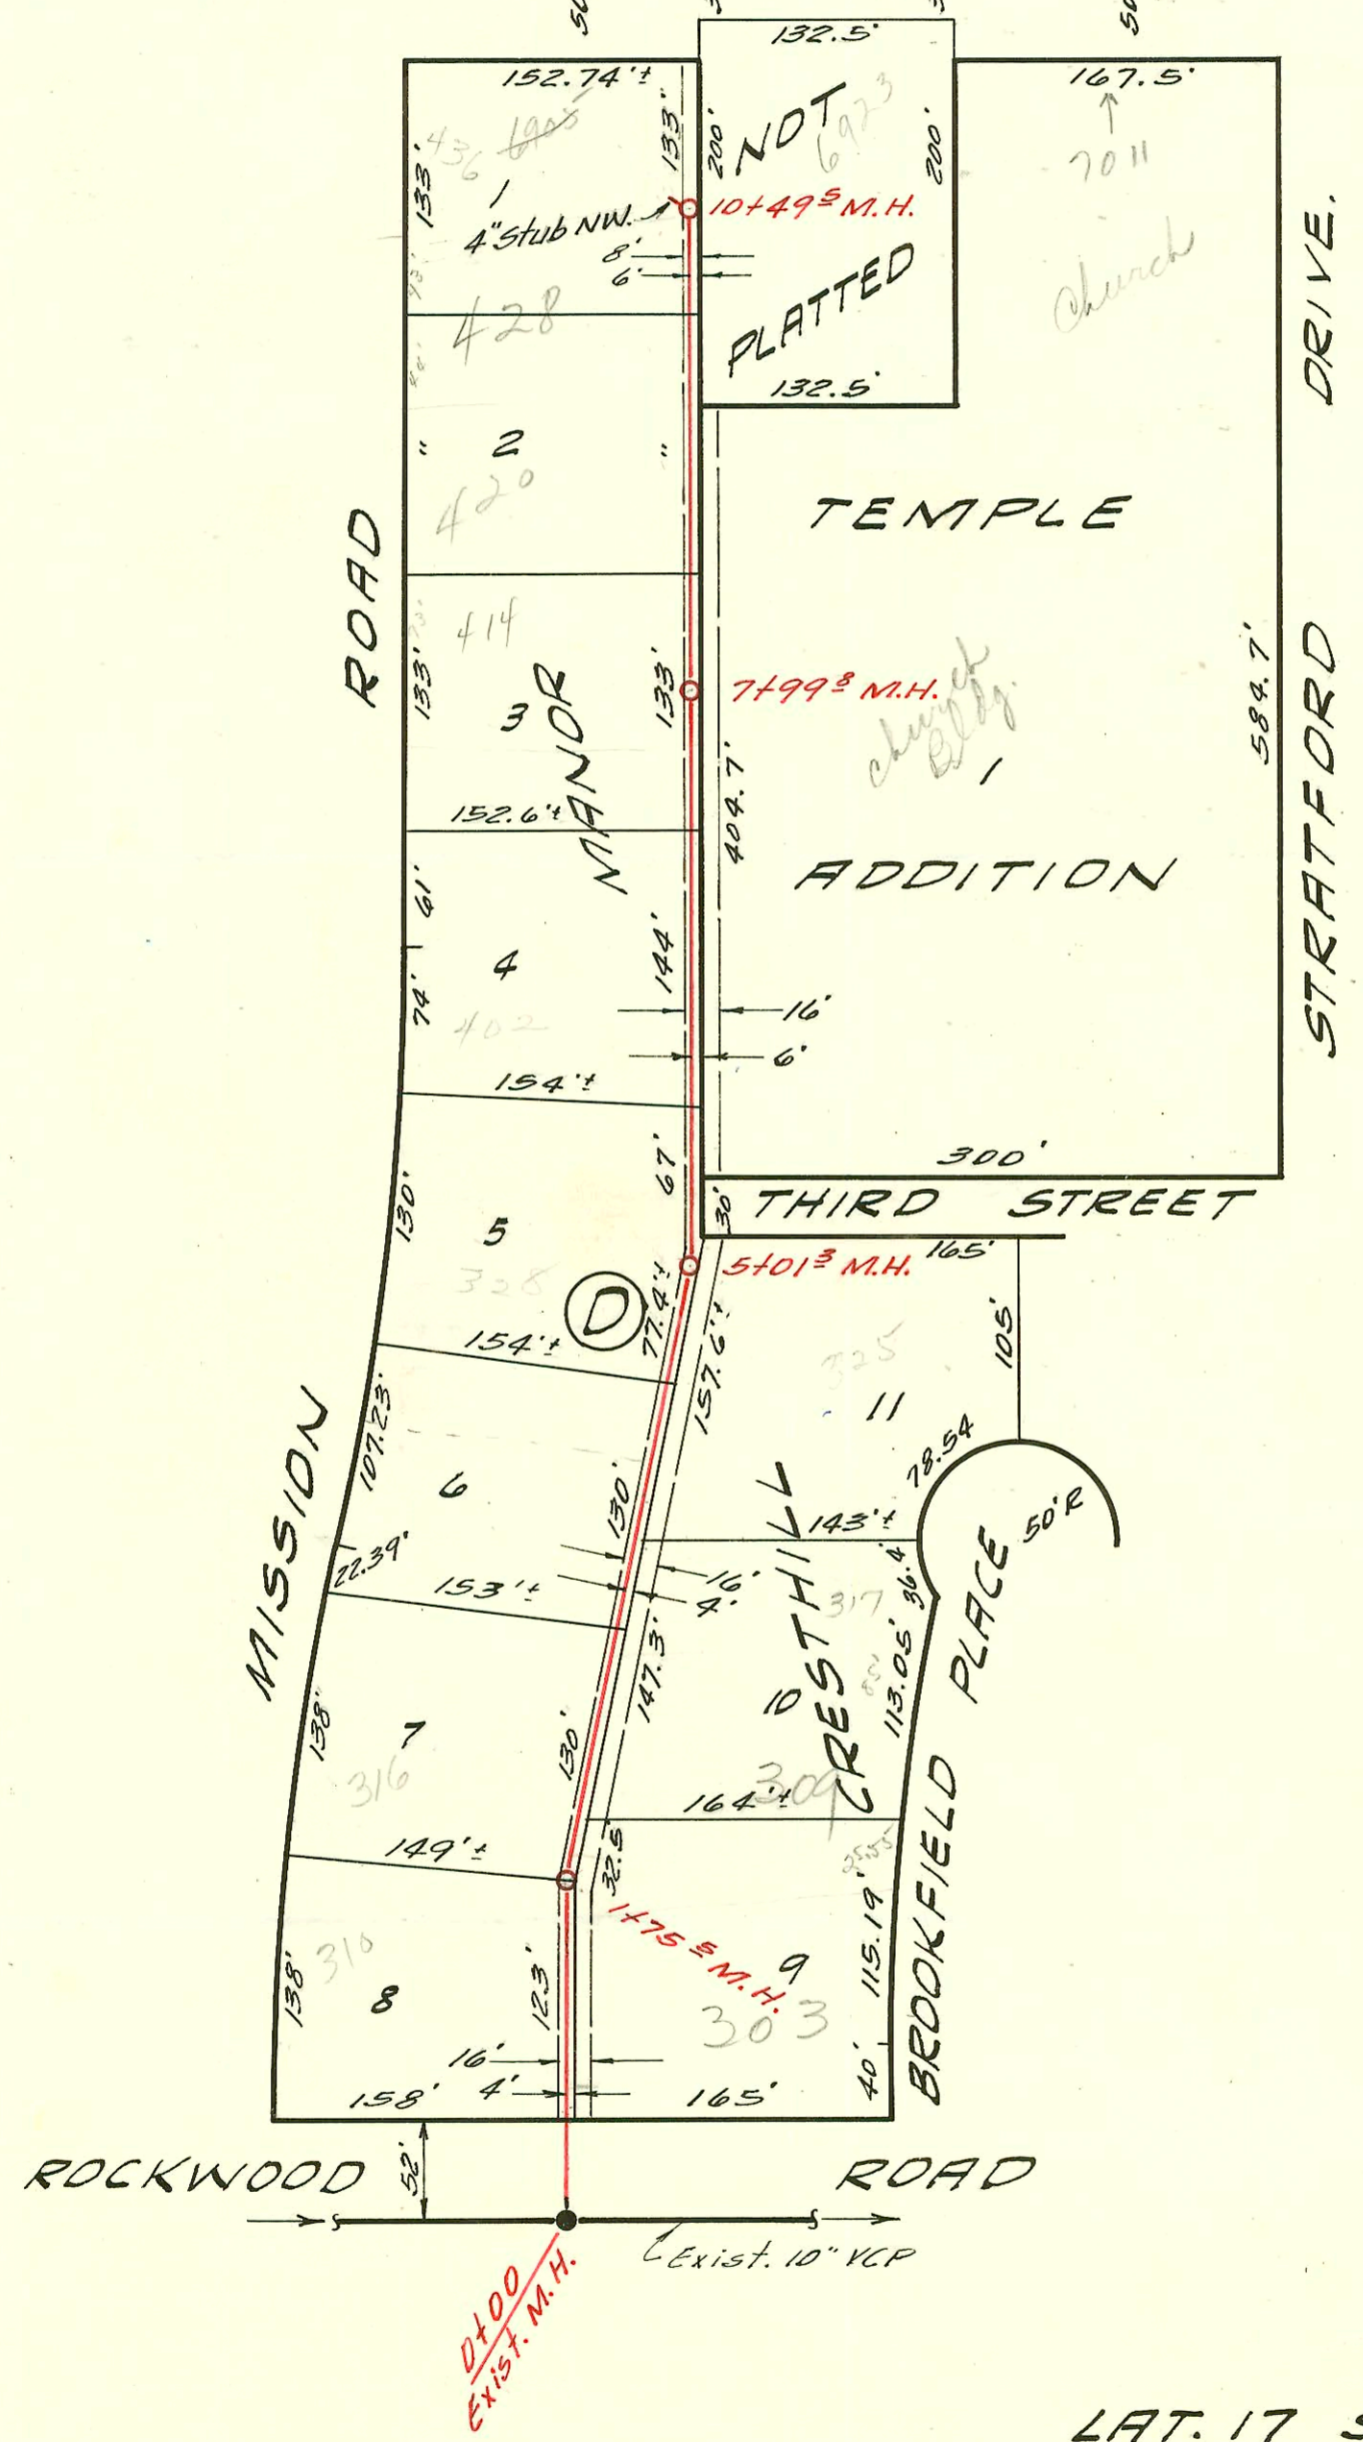

SCALE 1"=100'

LAT. 17 SUB. 5A W. I. S.  
 PROJ. NO. C20-36 NOV. 1960  
 UTILITY CONTRACTORS BK. K-47

CONSTRUCTION RECORD						SERVICE RECORD						
STATION	ELEVATION		Depth	MANHOLE	4-INCH "Y" BRANCHES		No. of Permit		House Number		DATE OF PERMITS	
	Ground	Grade			North West	South East	North West	South East	North West	South East	North West	South East
<b>LAT. 17 SUB. 5A W. I. S.</b>												
0+00	174.5	167.00	7.5	Exist.								
					0+61.3							
1+00	175.7	167.20	8.5		0+63.3		17352		310 N. Mission		7-2-63	
					1+26.0							
					1+44.0		122		309 Brookfield		9-10-63	
	175.8	167.35	8.4	1+75.5								
2+00	175.6	167.40	8.2									
					2+17.7							
					2+55.5		AB 3287		316 Mission		4-28-65	
					2+90.0		16709		317 Brookfield		4-5-63	
3+00	176.2	167.60	8.6		3+24.0		B1851		322 Mission		8-28-64	
					3+65.0							
					3+84.0							
4+00	177.3	167.80	9.5		4+44.6		B1520		325 Brookfield		6-16-64	
					4+46.6		B4299		328 Mission		10-7-65	
5+00	177.8	168.00	9.8		5+23.0		B2929		334 Mission		3-8-65	
	177.8	168.00	9.8	5+01.3	5+41.0							
					5+92.0							
					5+94.0							
6+00	177.6	168.20	9.4		6+63.4							
					7+135.0							
7+00	178.0	168.40	9.6		7+72.0		13881		704 E. Central (Quincy)		2-20-61	
	178.8	168.60	10.2	7+99.8								
8+00	178.8	168.60	10.2		8+08.2							
					8+62.8 top		13880		701 E. Central Church		2-20-61	
					8+64.0		81107		420 Mission		4-17-64	
9+00	179.9	168.80	11.1		9+38.5							
					9+85.5		13764		69235 Central		1-13-61	
10+00	180.4	169.00	11.4		10+06.0		B1509		428 N. Mission		6-15-64	
	180.7	169.10	11.6	10+49.5 (4" stub NW)			B2546		436 N. Mission		13-22-64	

#B-123 - top - 309 Brookfield - Kennedy 9-10-63 - (2+36.5)  
 #B-325 - top - 414 N. Mission - Reynolds Reg - 10-30-63 (7+83.8)  
 #B-1457 - top - 402 N. Mission - Reynolds Reg 4-9-64 (6+29.8)  
 #32958 - top - 408 N. Mission - Reynolds Reg 3-11-65 (7+19.1)