


Refer to  
Plat  
Larger  
ESM +  
Manstain  
Here  
36" ESM +  
in rear yard  
of Sedg.  
side  
BR  
11-17-09

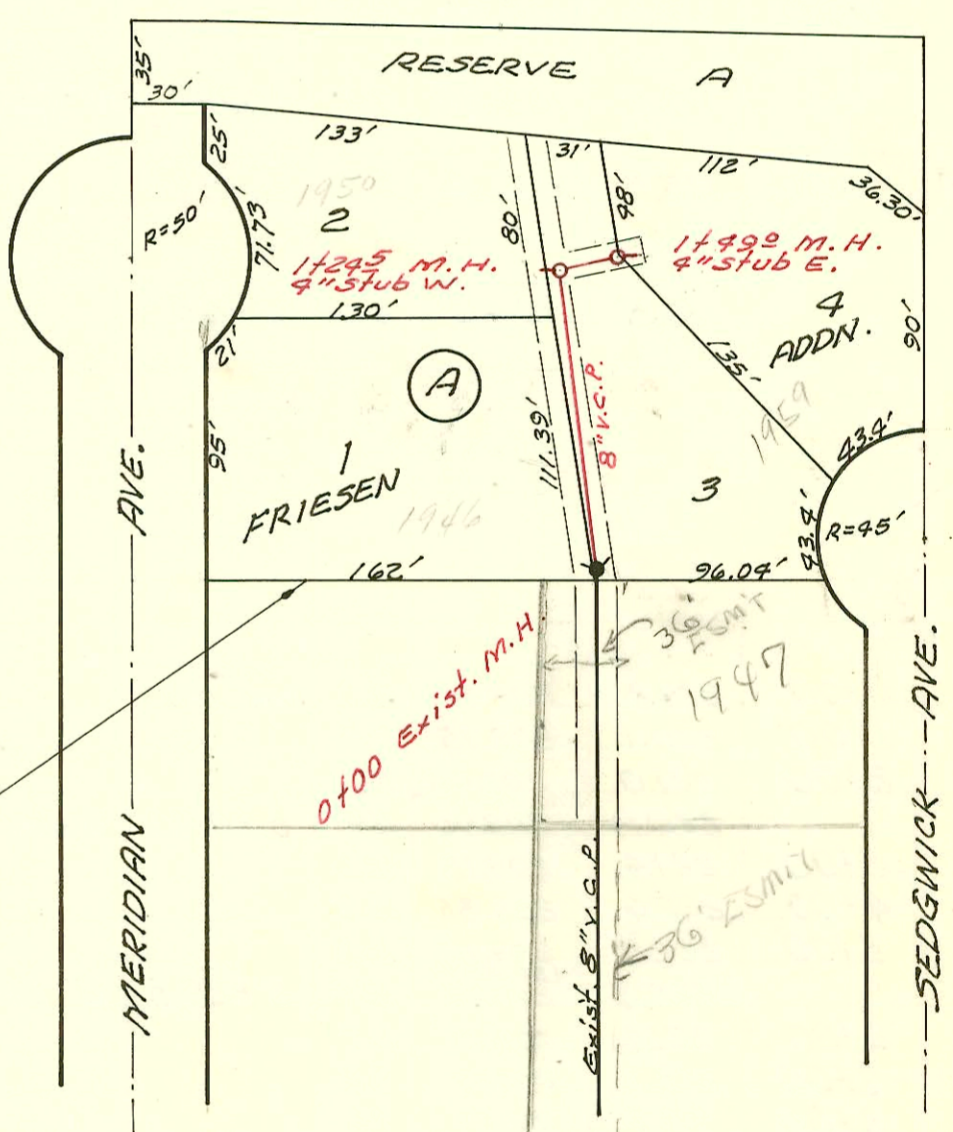

FRIESEN ADDN. SAN. SEWER  
MID STATES CONST. CO. INC. 1967  
PRIVATE PROJ. SEE INSP. CARD  
BOOKED 2-6-68  
SEE PLAN IN FILE 9-6-2-9

LATERAL 17, SUB. 13, SAN. SEWER 22  
UTILITY CONT. INC., FEB. 24, 1961  
BK. NO. K-51-A, PROJ. NO. C20-53

CONSTRUCTION RECORD						SERVICE RECORD						
STATION	ELEVATION		Depth	MANHOLE	4-INCH "Y" BRANCHES		No. of Permit		House Number		DATE OF PERMITS	
	Ground	Grade			North West	South East	North West	South East	North West	South East	North West	South East
0+00	123.6	114.00	9.6	Exist <sup>g</sup> MH								
1+00	124.3	114.20	10.1		0+86.5	0+84.5	15646	C4416	1804 N. Meridian	2404 W. Sedgwick	5-18-62	8-15-69
2+00	124.6	114.40	10.2		1+35.5	1+33.5						
					1+75.5	1+73.5						
2+00	124.6	114.40	10.2		2+48.5	1+94	17070	C15128	1816 N. Meridian	1809 N. Sedgwick	10-8-86	7-28-69
					2+36.0	2+34.0						4-5-72
3+00	124.2	114.59	9.6	2+94.3								4-5-72
					3+05.7	3+04.5	62961	C48222	1822 N. Meridian	1821 N. Sedgwick	9-18-77	1-28-75
4+00	125.0	114.80	10.2		3+76.5	3+74.5	14150	9610	Meridian	1809 N. Sedgwick	5-2-61	11-4-83
					4+46.0	4+44.0	14065	9609	1836 N. Meridian	1837 N. Sedgwick	4-12-61	11-4-83
5+00	124.5	115.00	9.5		5+13.5	5+13.5	C29037	C39355	1852 N. Meridian	1845 N. Sedgwick	11-16-71	6-5-73
	124.4	115.10	9.3	5+47.0	5+72.5	5+70.6	66107		1856 N. Meridian		5-10-77	
6+00	124.2	115.20	9.0		6+36.4	6+34.4	B658	10096	1903 N. Meridian	6853 Sedgwick	1-9-64	2-1-84
					6+55.0	Riser		8742		1901 Sedgwick		7-20-83
7+00	124.8	115.40	9.4		7+13.8							
					7+37.6	7+31.5	61158	C75465	1912 N. Meridian	1911 N. Sedgwick	5-16-77	11-26-79
8+00	123.9	115.60	8.3	8+05.5	8+34.5	8+32.5	14869	C47788	1922 N. Meridian	1921 N. Sedgwick	10-29-61	12-16-74
9+00	124.4	115.80	8.6		9+18.8							
					9+47.0	9+26.8	14295	C47445	1932 N. Meridian	1929 N. Sedgwick	6-14-61	11-20-74
10+00	124.6	116.00	8.6		10+13.0							
					10+35.7		14036	166477	1942 N. Meridian	1947 N. Sedgwick	12-11-60	5-23-78
11+00	124.7	116.20	8.5		4" stubs	NE & NW		13915		1946 N. Meridian		3-1-61
	125.0	116.22	8.8	11+07.7								
Friesen	Addr	S.S. Private	Proj.									
0+00	124.0	116.18	7.8	Exist. 0+00	0+78.5	0+38.0						
1+00	124.0	116.58	7.4									
	124.0	out 116.70 in 116.80	7.3	1+24.5	4" stub W.	1+45.5	66784	C51242	1950 N. Meridian	1949 N. Sedgwick	2-7-68	2-1-77
	124.0	117.00	7.0	1+49.0	4" stub E.							