


J163A

TAFT AVE.



RELOCATION OF
 LAT. 106, SUB. 5, S. S. NO. 22
 "PER PLAN"
 9-13-4-3
 DEC. 1967
 d.w.

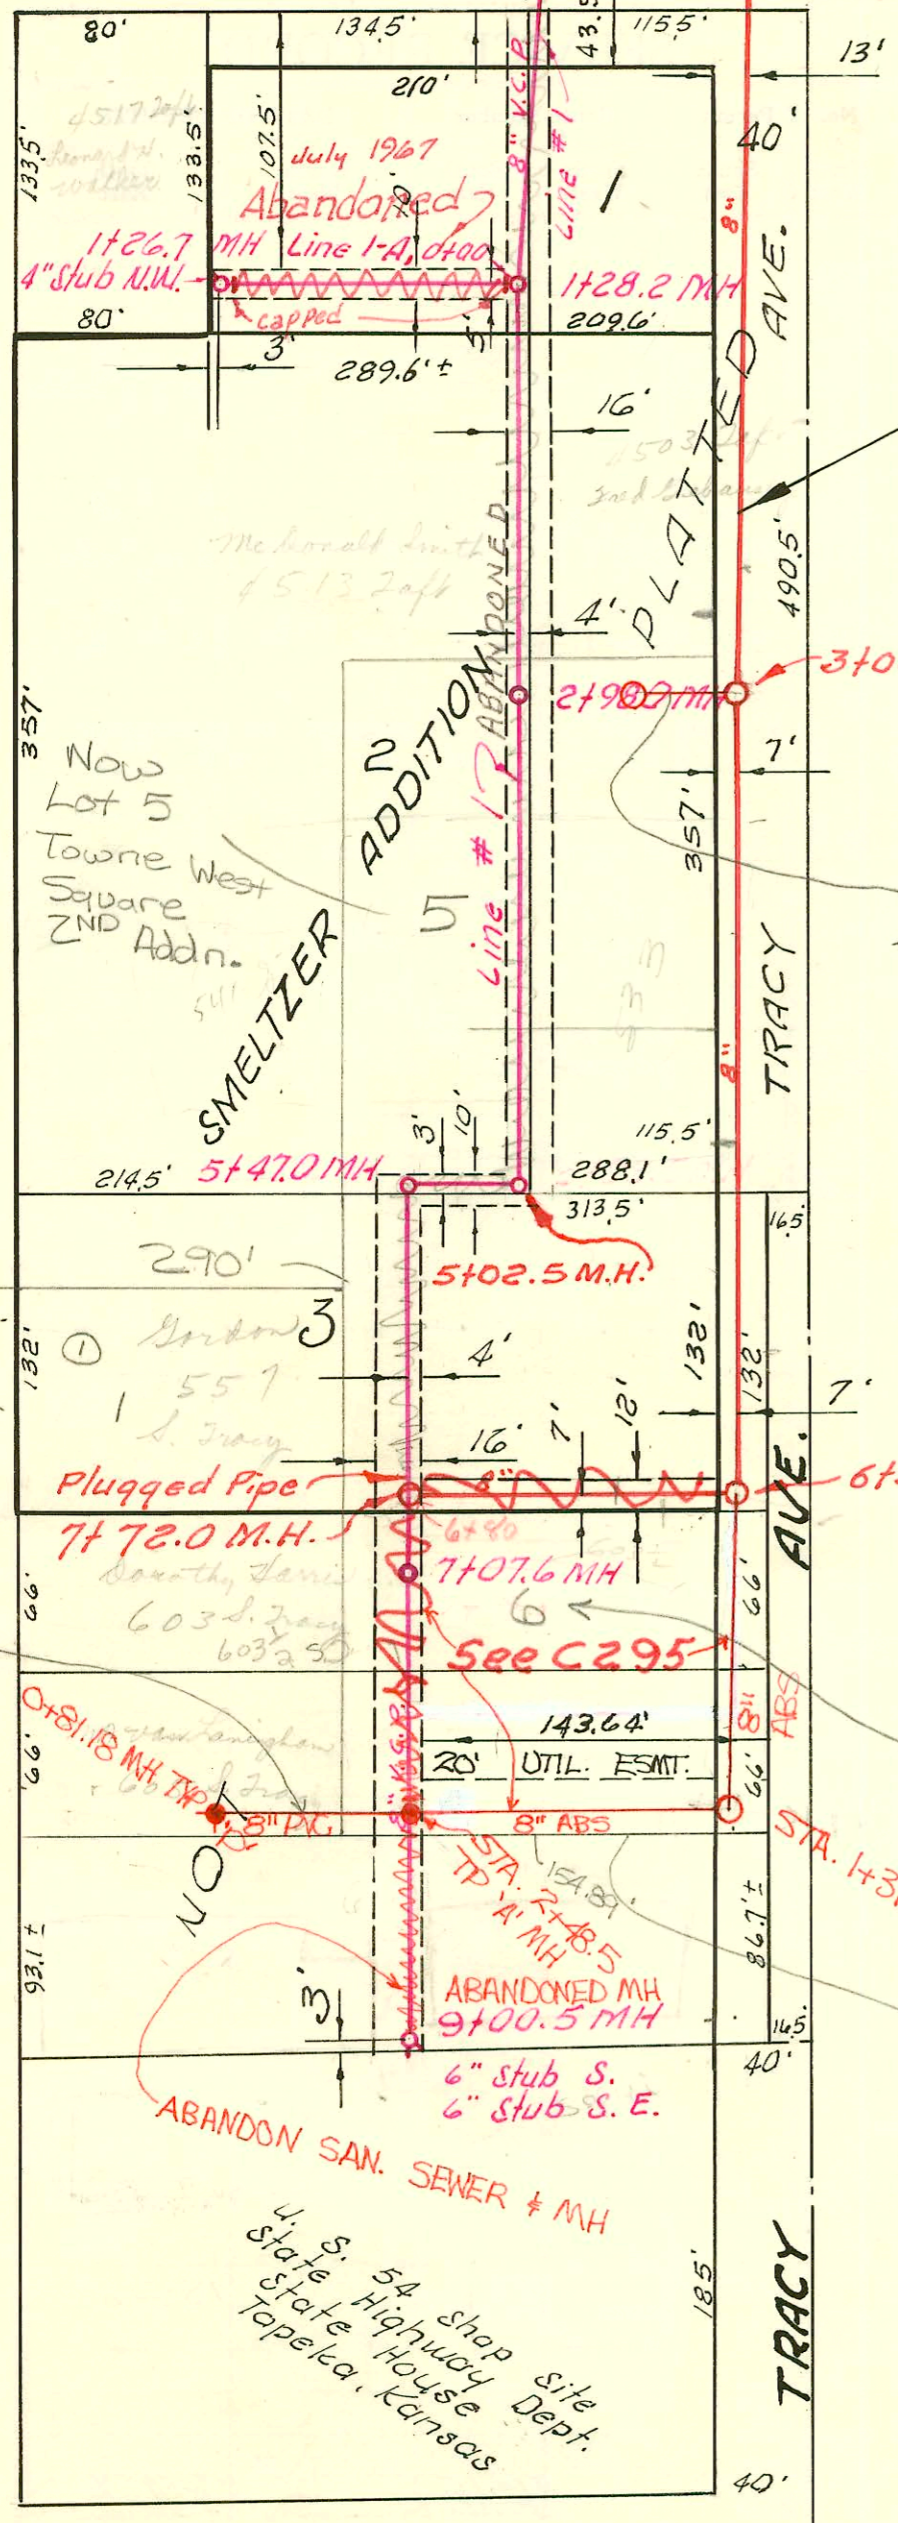

LAT. 106, SUB. 5, S. S. 22
 MID STATES CONST. CO. INC.
 BK. NO. K-59, PROJ. NO. C29-18
 JULY 12, 1961

Now Lot 1, Bk. 1
 Kellogg West
 Square Addn.
 See N-165
 San. Sew.
 Extension For
 Kellogg West
 Square!!

Now Lot 6
 Towne West Square 2ND Addn.
 Lot Dimension 154.89' x 210'
 South R. of Lot 6

U. S. 54 HIGHWAY

CONSTRUCTION RECORD

SERVICE RECORD

LINE # 1

Abandoned

LINE # 1-A

RELOCATION PART OF
LAT. 106. SUB. 5, S.S. NO. 22

STATION	ELEVATION		Depth	MANHOLE	4-INCH "Y" BRANCHES		No. of Permit		House Number		DATE OF PERMITS	
	Ground	Grade			North West	South East	North West	South East	North West	South East	North West	South East
0+00	117.2	108.50	8.7	0+00 Existg MH		0+47 ^s						
1+00	118.4	108.70	9.7									
	118.4	108.76	9.6	1+28 ^a								
2+00	117.9	108.90	9.0		1+85 ^o	1+83 ^o						
	116.8	109.10	7.7	2+98 ^o	2+56 ^o	2+54 ^o	16752				3-12-63	
3+00					3+09 ^o	3+07 ^o						
					3+58 ^s	3+56 ^s						
4+00	116.5	109.30	7.2		4+06 ^a	4+04 ^a						
					4+55 ^a	4+53 ^a						
5+00	116.8	109.50	7.3		5+67 ^o	5+65 ^o						
	116.7	109.51 out	7.2	5+02 ^s	6+32 ^s	6+30 ^s						
	116.4	109.61 in	7.1	5+47 ^o	6+83 ^s	6+80.0						
		109.70 out	6.7									
		109.80 in	6.6									
6+00	116.1	109.90	6.2		6+83 ^s	6+98 ^s						
7+00	116.9					7+00 ^s						
	116.9	110.10	6.8	7+07 ^a								
					7+66 ^s							
8+00	116.2	110.30	5.9		4" clay 8+12 ^s	7+73 ^o						
					8+28 ^o	8+26 ^o						
9+00	117.0	110.50	6.5		6" stub S.							
		110.51	6.5	9+00 ^s	6" stub S.E.							
0+00	117.2	110.00	7.2	0+00 = 1+28 ^a Line # 1								
1+00	118.5	110.20	8.3			0+13 ^o						
	118.1	110.26	7.8	1+26 ^a	4" stub NW	1+06 ^a						
0+00	116.8	101.2 out	15.6	0+00.0								
1+00	118.0	104.7 in	12.1									
2+00	117.5	105.1	13.9									
		105.5	12.0									
3+00	117.4	105.9 out	11.5	3+00		2+55 ^o						
		107.97 in	9.4									
4+00	117.4	108.37	9.0									
5+00	117.7	108.77	8.9									
6+00	117.5	109.17	8.3									
	117.7	109.31 out	8.4									
		109.41 in	8.3									
7+00	116.5	109.67	6.8									
	116.7	109.96	6.7									

94-8014-7 4448 w Kellogg - Mr. Cullah 5-24-94 = Seal off in MH.
 94-010930-7 4448 w Kellogg (Blockbuster music) - United - 7/25/94