



LAT. 27 - WAR INDUSTRIES SAN SEWER  
 W. B. CARTER CONSTRUCTION CO. - 2-19-62  
 BOOK NO. K-69 PROJ. NO. C21-32

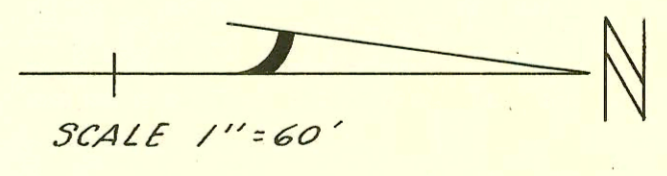

LAT. 22, DIST. 7, S.S. NO. 20  
 MID-STATES CONSTRUCTION CO., INC. 3-6-62  
 BOOK NO. K-56 PROJ. NO. C21-22

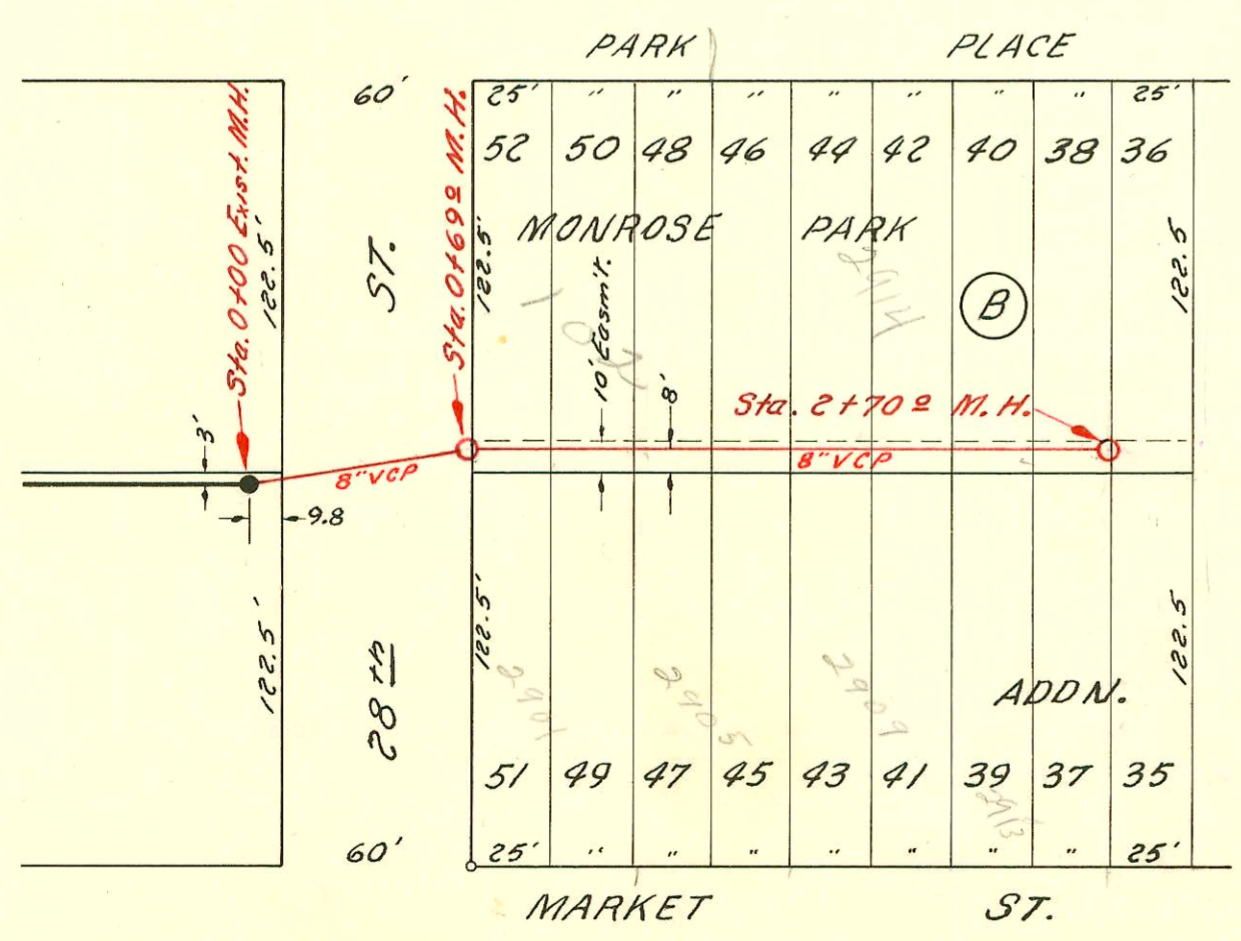