


MORGANTOWN AVE.

S.E. COR. SE 1/4 SEC 9-275-1W.

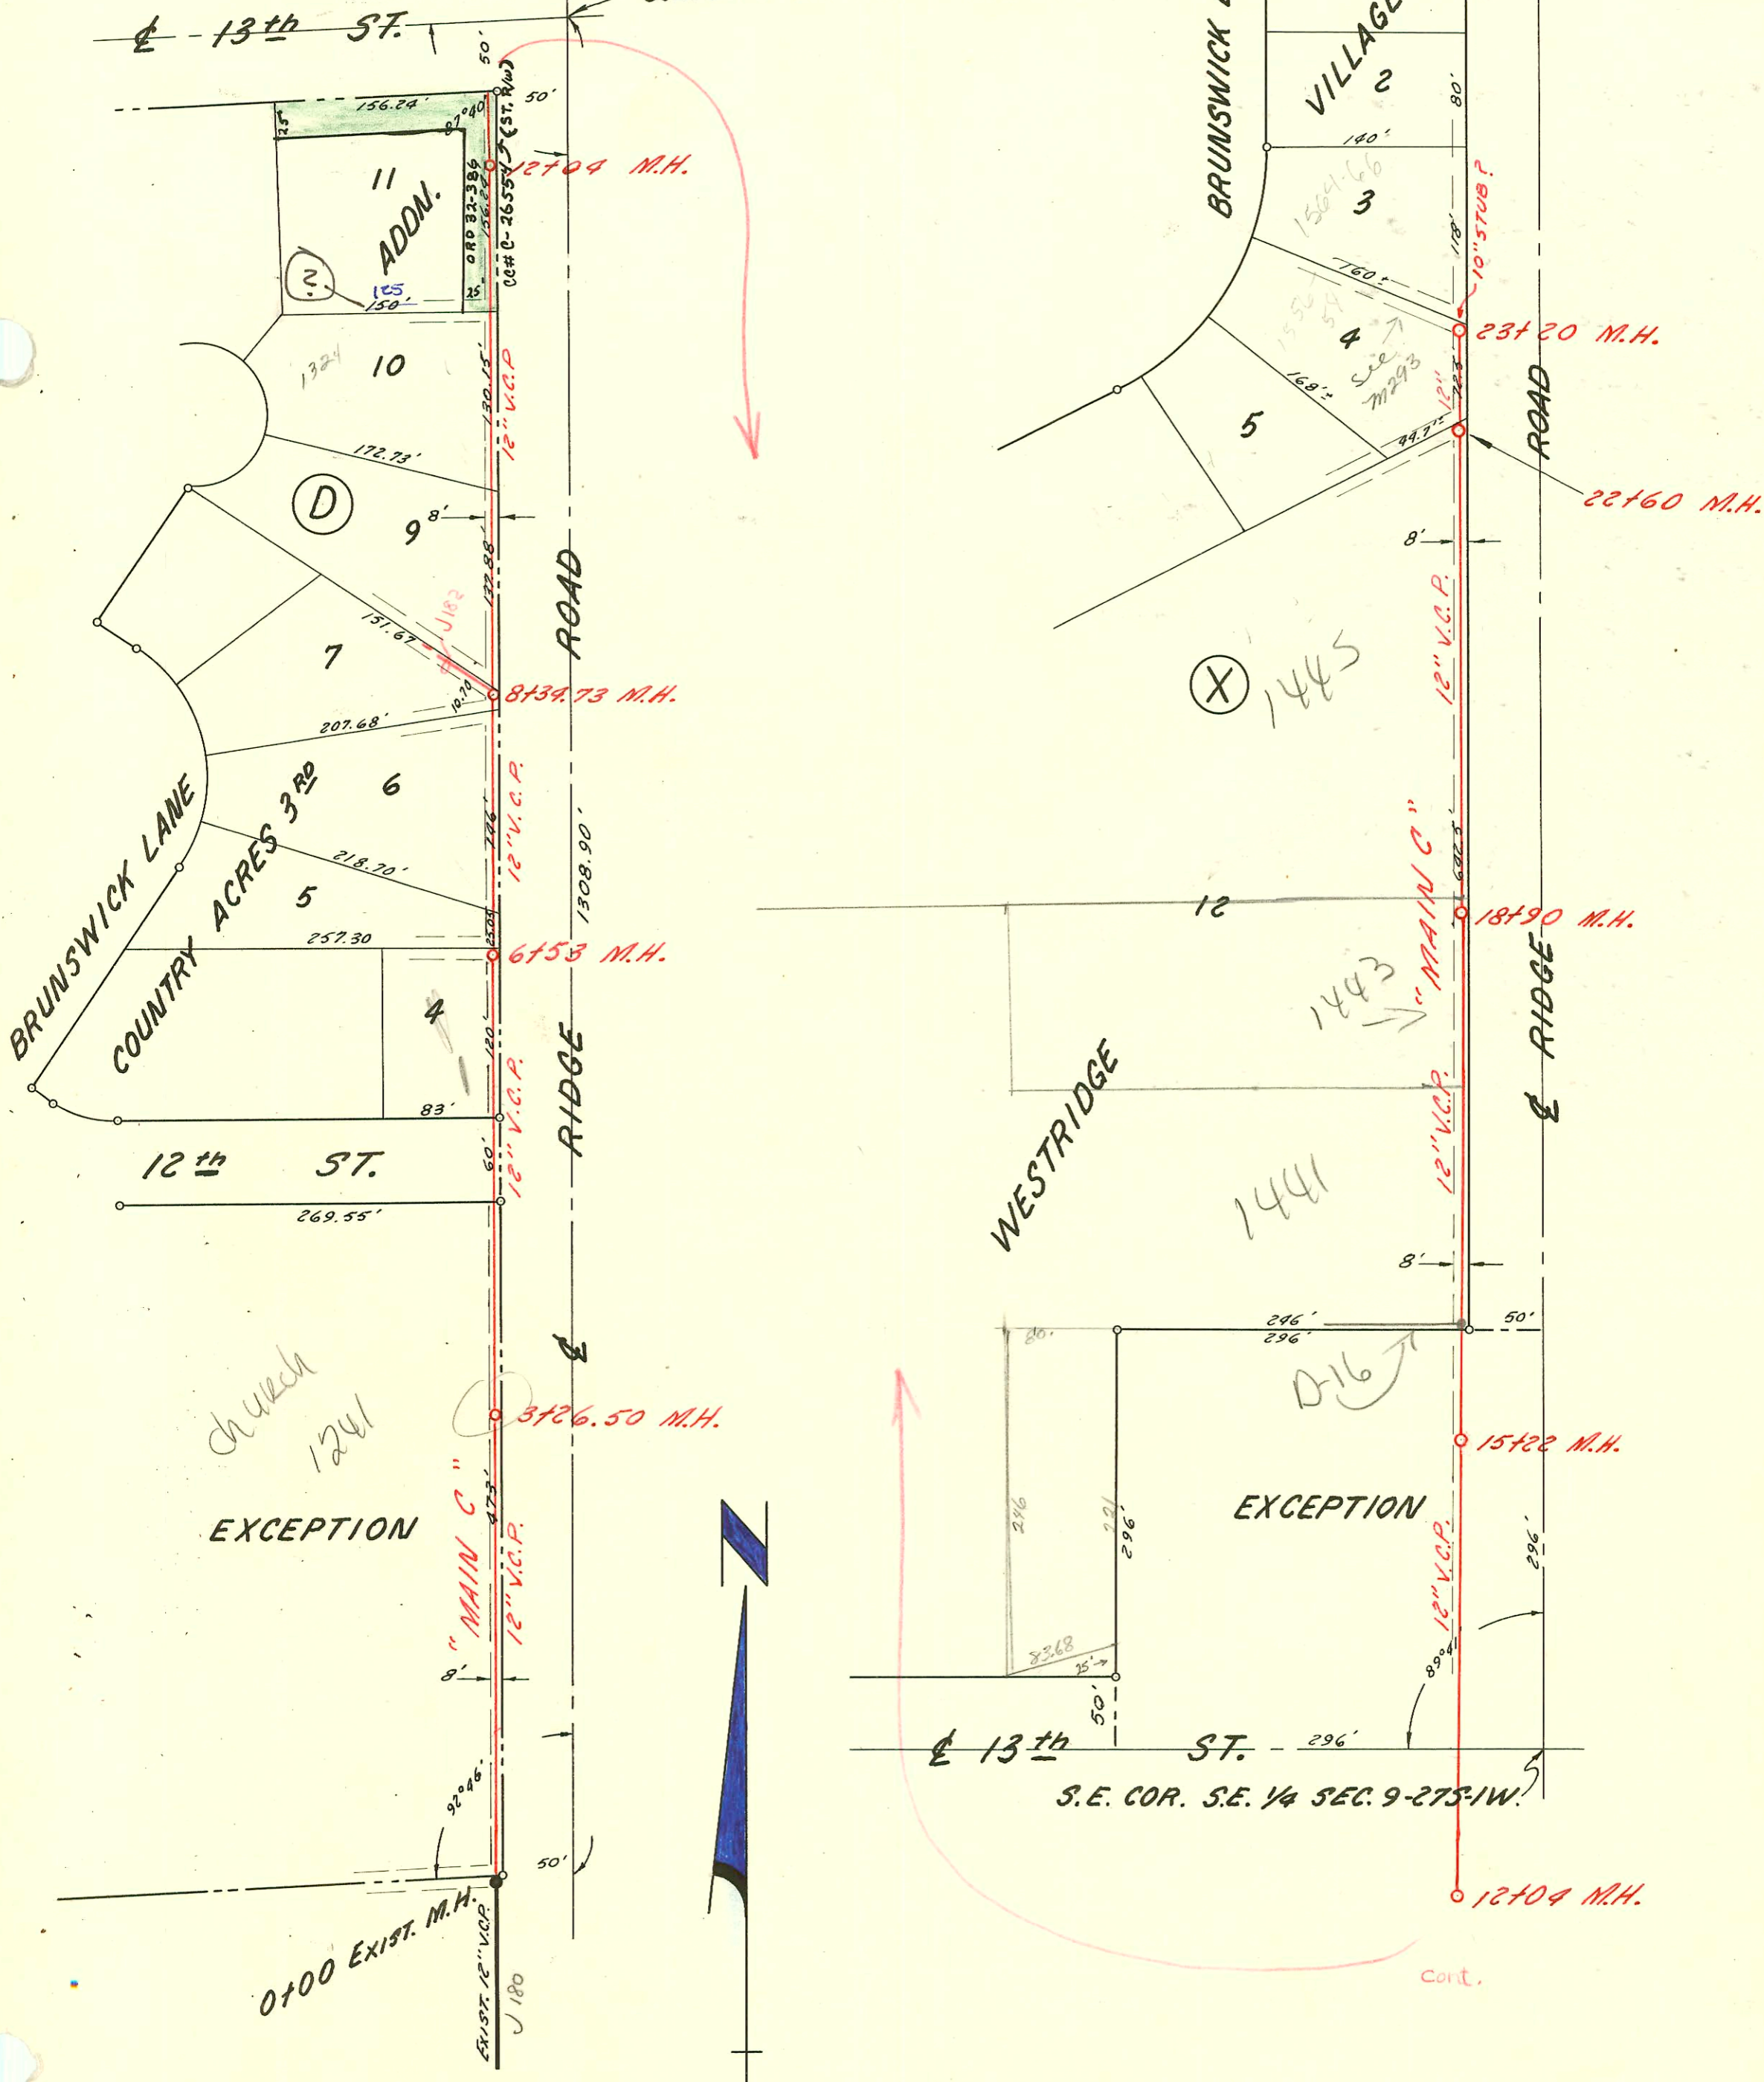

SCALE 1"=100'

MAIN "C" WEST LINK S.S.  
 COUNTRY ACRES IMPROVEMENT DISTRICT  
 FLOYD B. DEVLIN ENGR. - UTILITY CONTRACTORS, INC.  
 CONSTRUCTION DATE 1956 - BOOKED 9-12-1962

CONSTRUCTION RECORD

SERVICE RECORD

STATION	ELEVATION		Depth	MANHOLE	4-INCH "Y" BRANCHES		No. of Permit		House Number		DATE OF PERMITS	
	Ground	Grade			North West	South East	North West	South East	North West	South East	North West	South East
MAIN C				EXISTING								
0+00	33.6	12.97	20.6	0+00								
1+00	33.8	13.21	20.6									
2+00	34.1	13.45	20.6									
3+00	34.3	13.69	20.6									
	34.4	13.75	20.6	3+26.50	mt tap			2001 1967	1241 N Ridge Rd	sep before	8/10/01	
4+00	34.4	13.93	20.5									
5+00	34.6	14.17	20.4									
6+00	34.7	14.41	20.3									
	34.8	14.53	20.1	DR. 6+53								
7+00	34.8	14.65	20.1									
8+00	35.0	14.89	20.1									
	35.0	14.97	20.0	DR. 8+34.73								
9+00	35.0	15.13	19.9									
10+00	35.0	15.37	19.6		10+97.0			#5	1324 Brunswick Ct		4-7-80	
11+00	35.0	15.61	19.4									
12+00	35.0	15.85	19.1									
	35.0	15.86	19.1	12+04	mt tap			06/24	1337 N. Ridge		5-23-77	
13+00	34.8	16.09	18.7									
14+00	34.6	16.33	18.3									
15+00	34.4	16.57	17.8									
	34.4	16.62	17.8	15+22	tap 15+50.9			C63379	1409 N Ridge Road		10-6-77	
16+00	34.2	16.81	17.4									
17+00	34.0	17.05	16.9									
18+00	33.4	17.29	16.1					2002 01875	1443 Aldse Rd		7-9-02	
	32.4	17.50	14.9	18+90								
19+00	32.2	17.53	14.7									
20+00	32.4	17.77	14.6									
21+00	31.0	18.01	13.0									
22+00	26.8	18.25	8.5									
	25.9	18.39	7.5	22+60								
23+00	25.2	18.49	6.7									
	25.0	18.66	6.3	23+20	END 12" V.C.P.							

→ NO CRIS RECORD OF CUMM

2001-01967-810101-1241 N Ridge- Overnight- 10' of 6" PVC Pipe at MH stub for addition to Messah E. King  
 Per R Young- 60' from Bldg to MH replaced by Bob Barnes. 1-6x4 WYE, 1U22, 1H22  
 NOTE from Bldg out 55' Brand installed new grease interceptor- No insp was made to date