

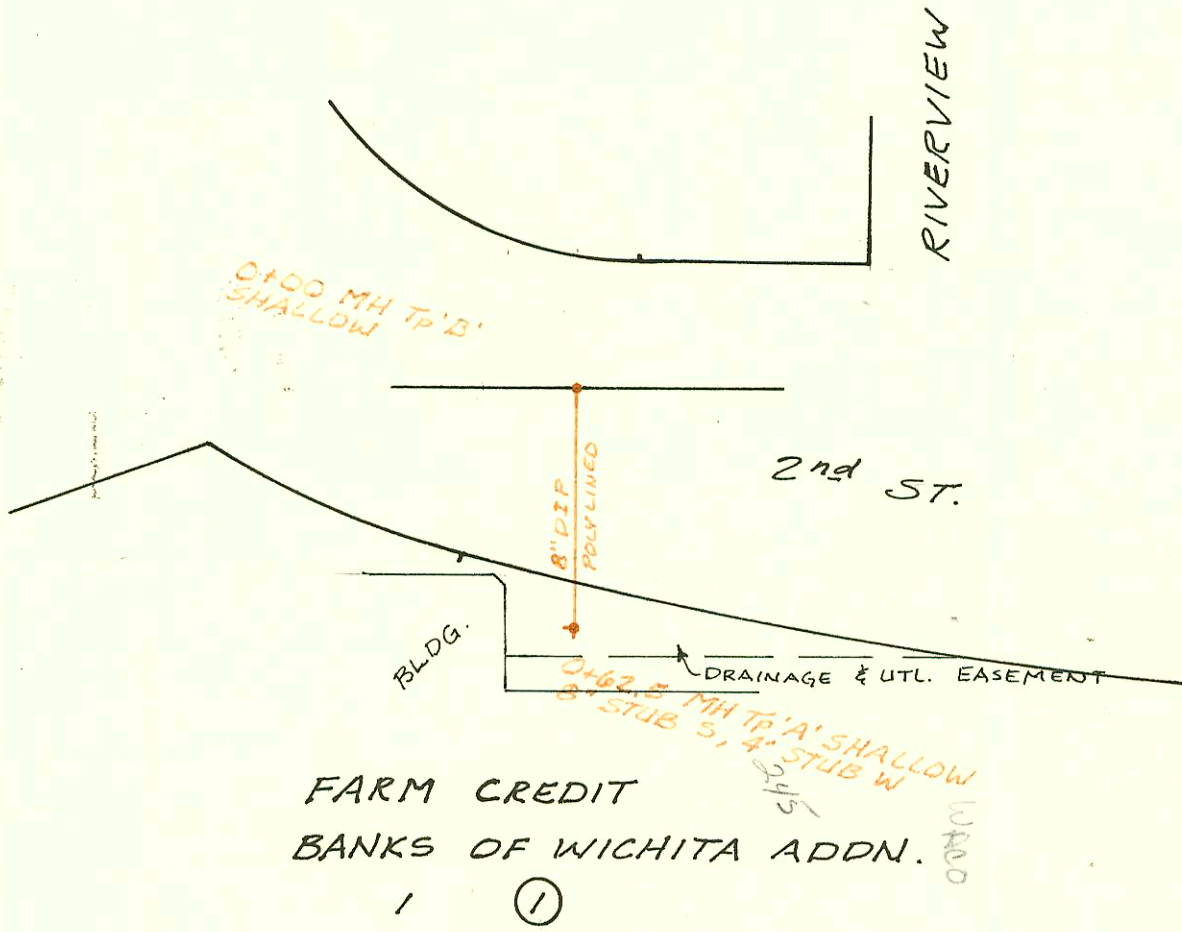
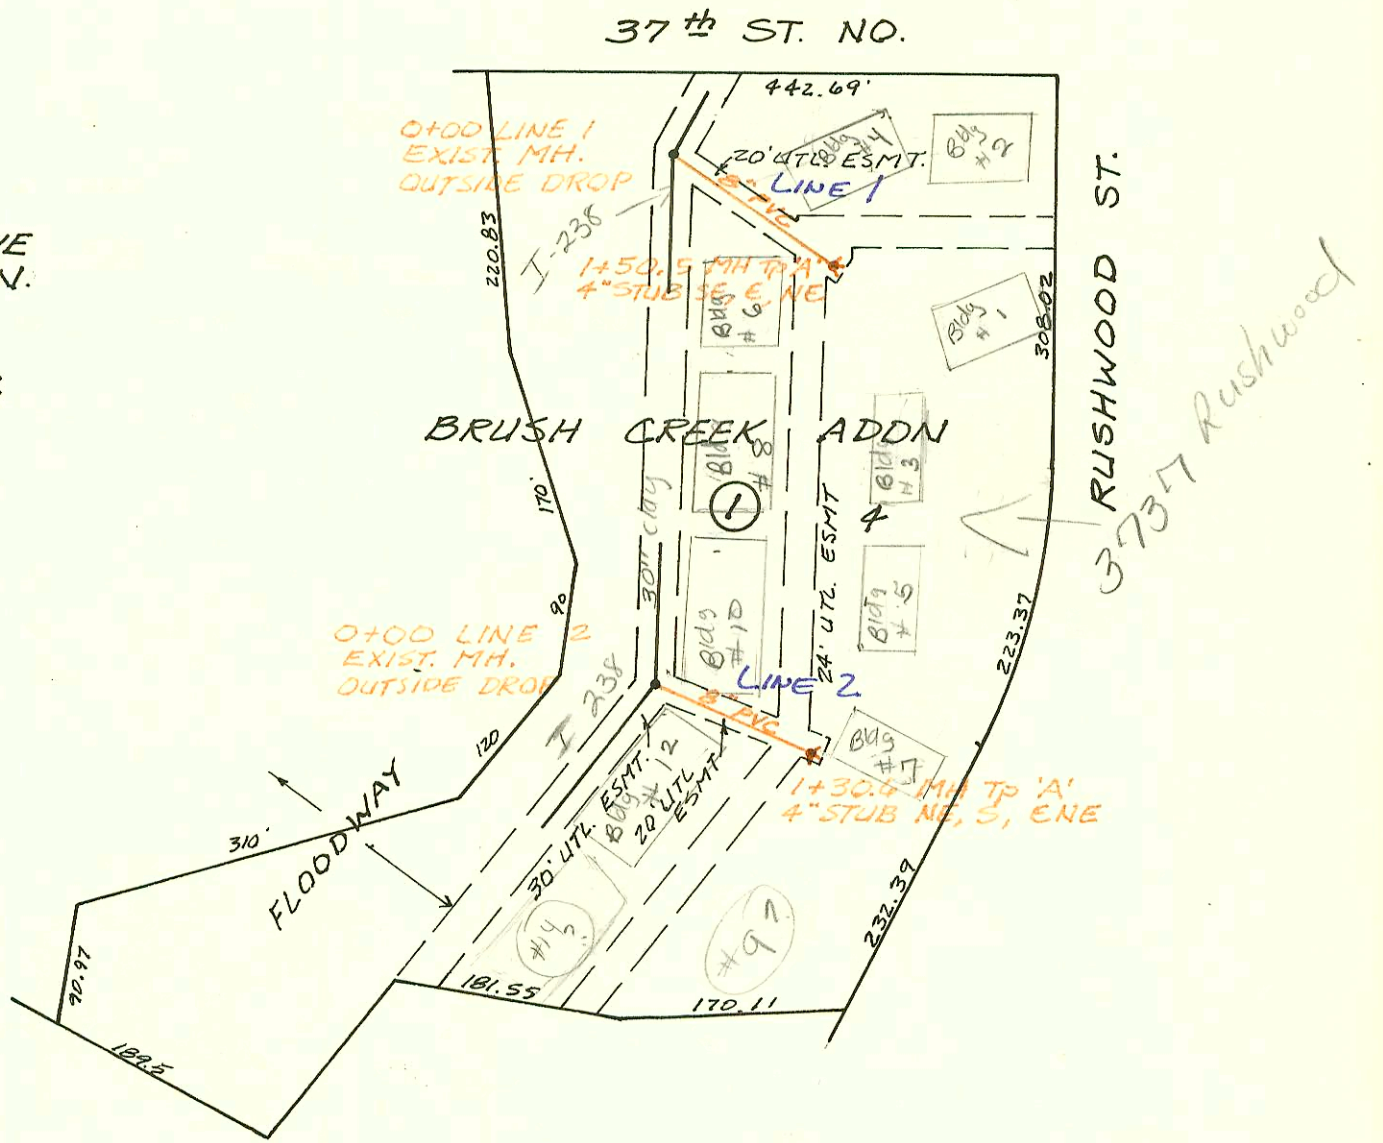
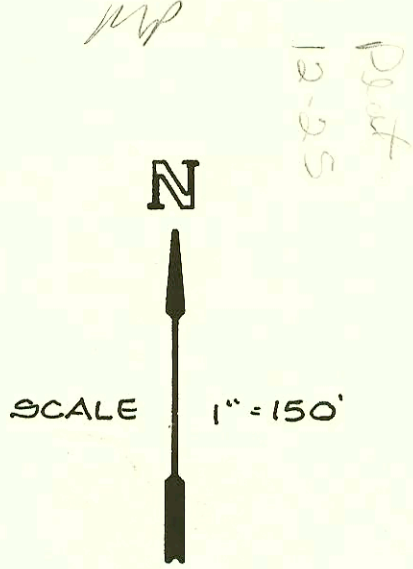



PRIVATE SAN. SEWER EXT. TO SERVE
 LOT 4, BLK. 1 BRUSH CREEK ADDN.
 468-76-245-80000-000-000-008
 BUILT BY
 BOOKED 12-5-84 FROM TCD-52

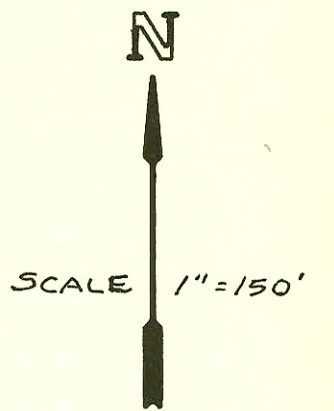



SANITARY SEWER EXT. TO SERVE PART
 LOT 1, BLK 1, FARM CREDIT BANKS OF WICHITA ADDN.
 468-76-245-80000-000-000-008
 BUILT BY
 BOOKED 12-5-84 FROM 13-A

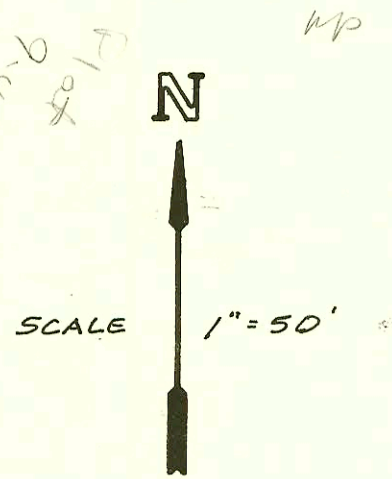

PRIV. SAN. SEWER EXT. LOT 1, FREEMANS ADDN.
 468-76-245-80000-000-000-008
 BUILT BY W.B. CARTER
 BOOKED 12-6-84 FROM DLK-373

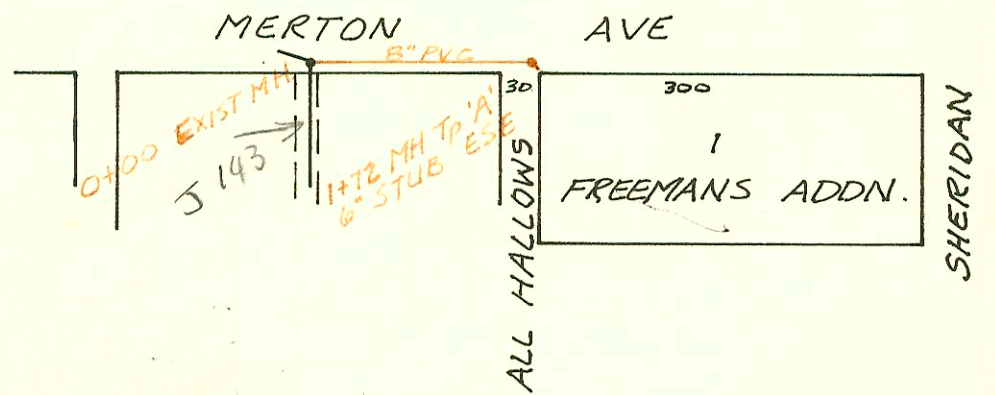

RELOCATION SAN. SEWER FOR
 LOT 1, LOW'S ADDN.
 468-76-245-80000-000-000-008
 Built By
 Booked 12-6-84 From 13-D

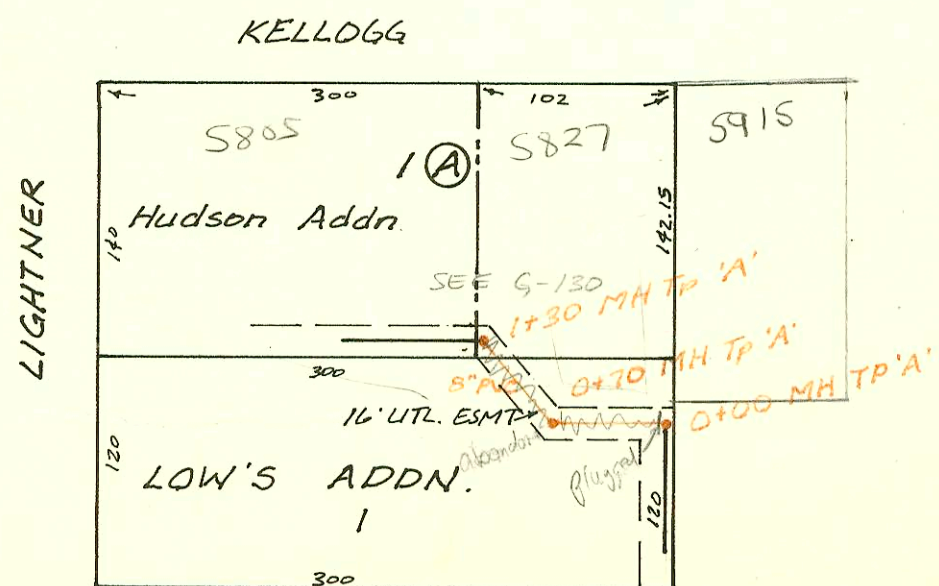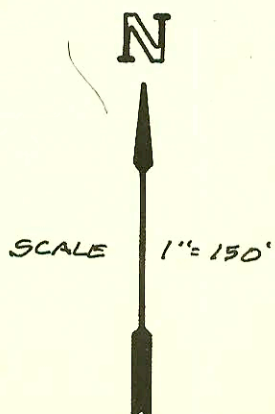

CONSTRUCTION RECORD						SERVICE RECORD							
STATION	ELEVATION		Depth	MANHOLE	4-INCH "Y" BRANCHES		No. of Permit		House Number		DATE OF PERMITS		
	Ground	Grade			North West	South East	North West	South East	North West	South East	North West	South East	
PRIV. S.S. EXT. TO SERVE LOT 4, BLK 1, BRUSH CREEK ADDN.													
LINE 1	0+00	174.1	165.50	8.6	0+00 OUTSIDE DROP								
						0+59.0	0+61.0	12467	12468	3737 #4 Rushwood	3737 #6 Rushwood	11-6-84	11-6-84
	1+00	177.0	168.80	8.2				17500		3737 #300 Rushwood	3737 #300 Rushwood	12-19-86	
		176.8	170.46	6.3	1+50.5	4" STUB NE	4" STUB SE	11700	11699	3737 #2 Rushwood	3737 #100 Rushwood	8-7-84	8-7-84
LINE 2	0+00	172.9	164.50	8.4	0+00 OUTSIDE DROP								
						0+20.0	0+11.0	14830	23088	3737 #8 Rushwood	3737 #14 Rushwood	10-9-88	4-26-89
						0+30.0	0+31.0	21535	21536	3737 #10 Rushwood	3737 #12 Rushwood	9-19-88	9-19-88
	1+00	175.2	167.50	7.7				23155		3737 #9 Rushwood	3737 #9 Rushwood	5-15-89	
		175.5	168.42	7.1	1+30.7	4" STUB NE	4" STUB ENE	19465	20492	3737 #4S Rushwood	3737 #14 Rushwood	10/22/87	4/12-88
PRIV. SAN. SEWER EXT. LOT 1, BLK 1, FARM CREDIT BANKS OF WICHITA ADDN.													
	0+00	111.25	108.83	2.4	0+00								
								12631		245 N Wichita		11-20-84	
		112.91	110.02	2.9	0+62.5	4" STUB W.		12260		245 N Wichita		10-17-84	
PRIV. SAN. SEWER LOT 1, FREEMANS ADDN.													
	0+00	108.23	103.00	5.2	0+00								
	1+00	109.6	103.40	6.2									
		110.00	103.69	6.3	1+72			14922		1703 SW. Abert		10-29-85	
RELOCATION SAN. SEWER FOR Lot 1, LOW'S ADDN.													
	0+00	128.2	159.84	8.4	0+00			2003	1233			5-7-83	
								10485		5915 R50 Rushwood		3-16-84	
	1+00	168.0	160.26 160.36	7.6	0+70	Line plugged just w. of mt 0+00 and line west from mt 0+00 abandoned							
		168.5	160.70	7.8	1+30								