
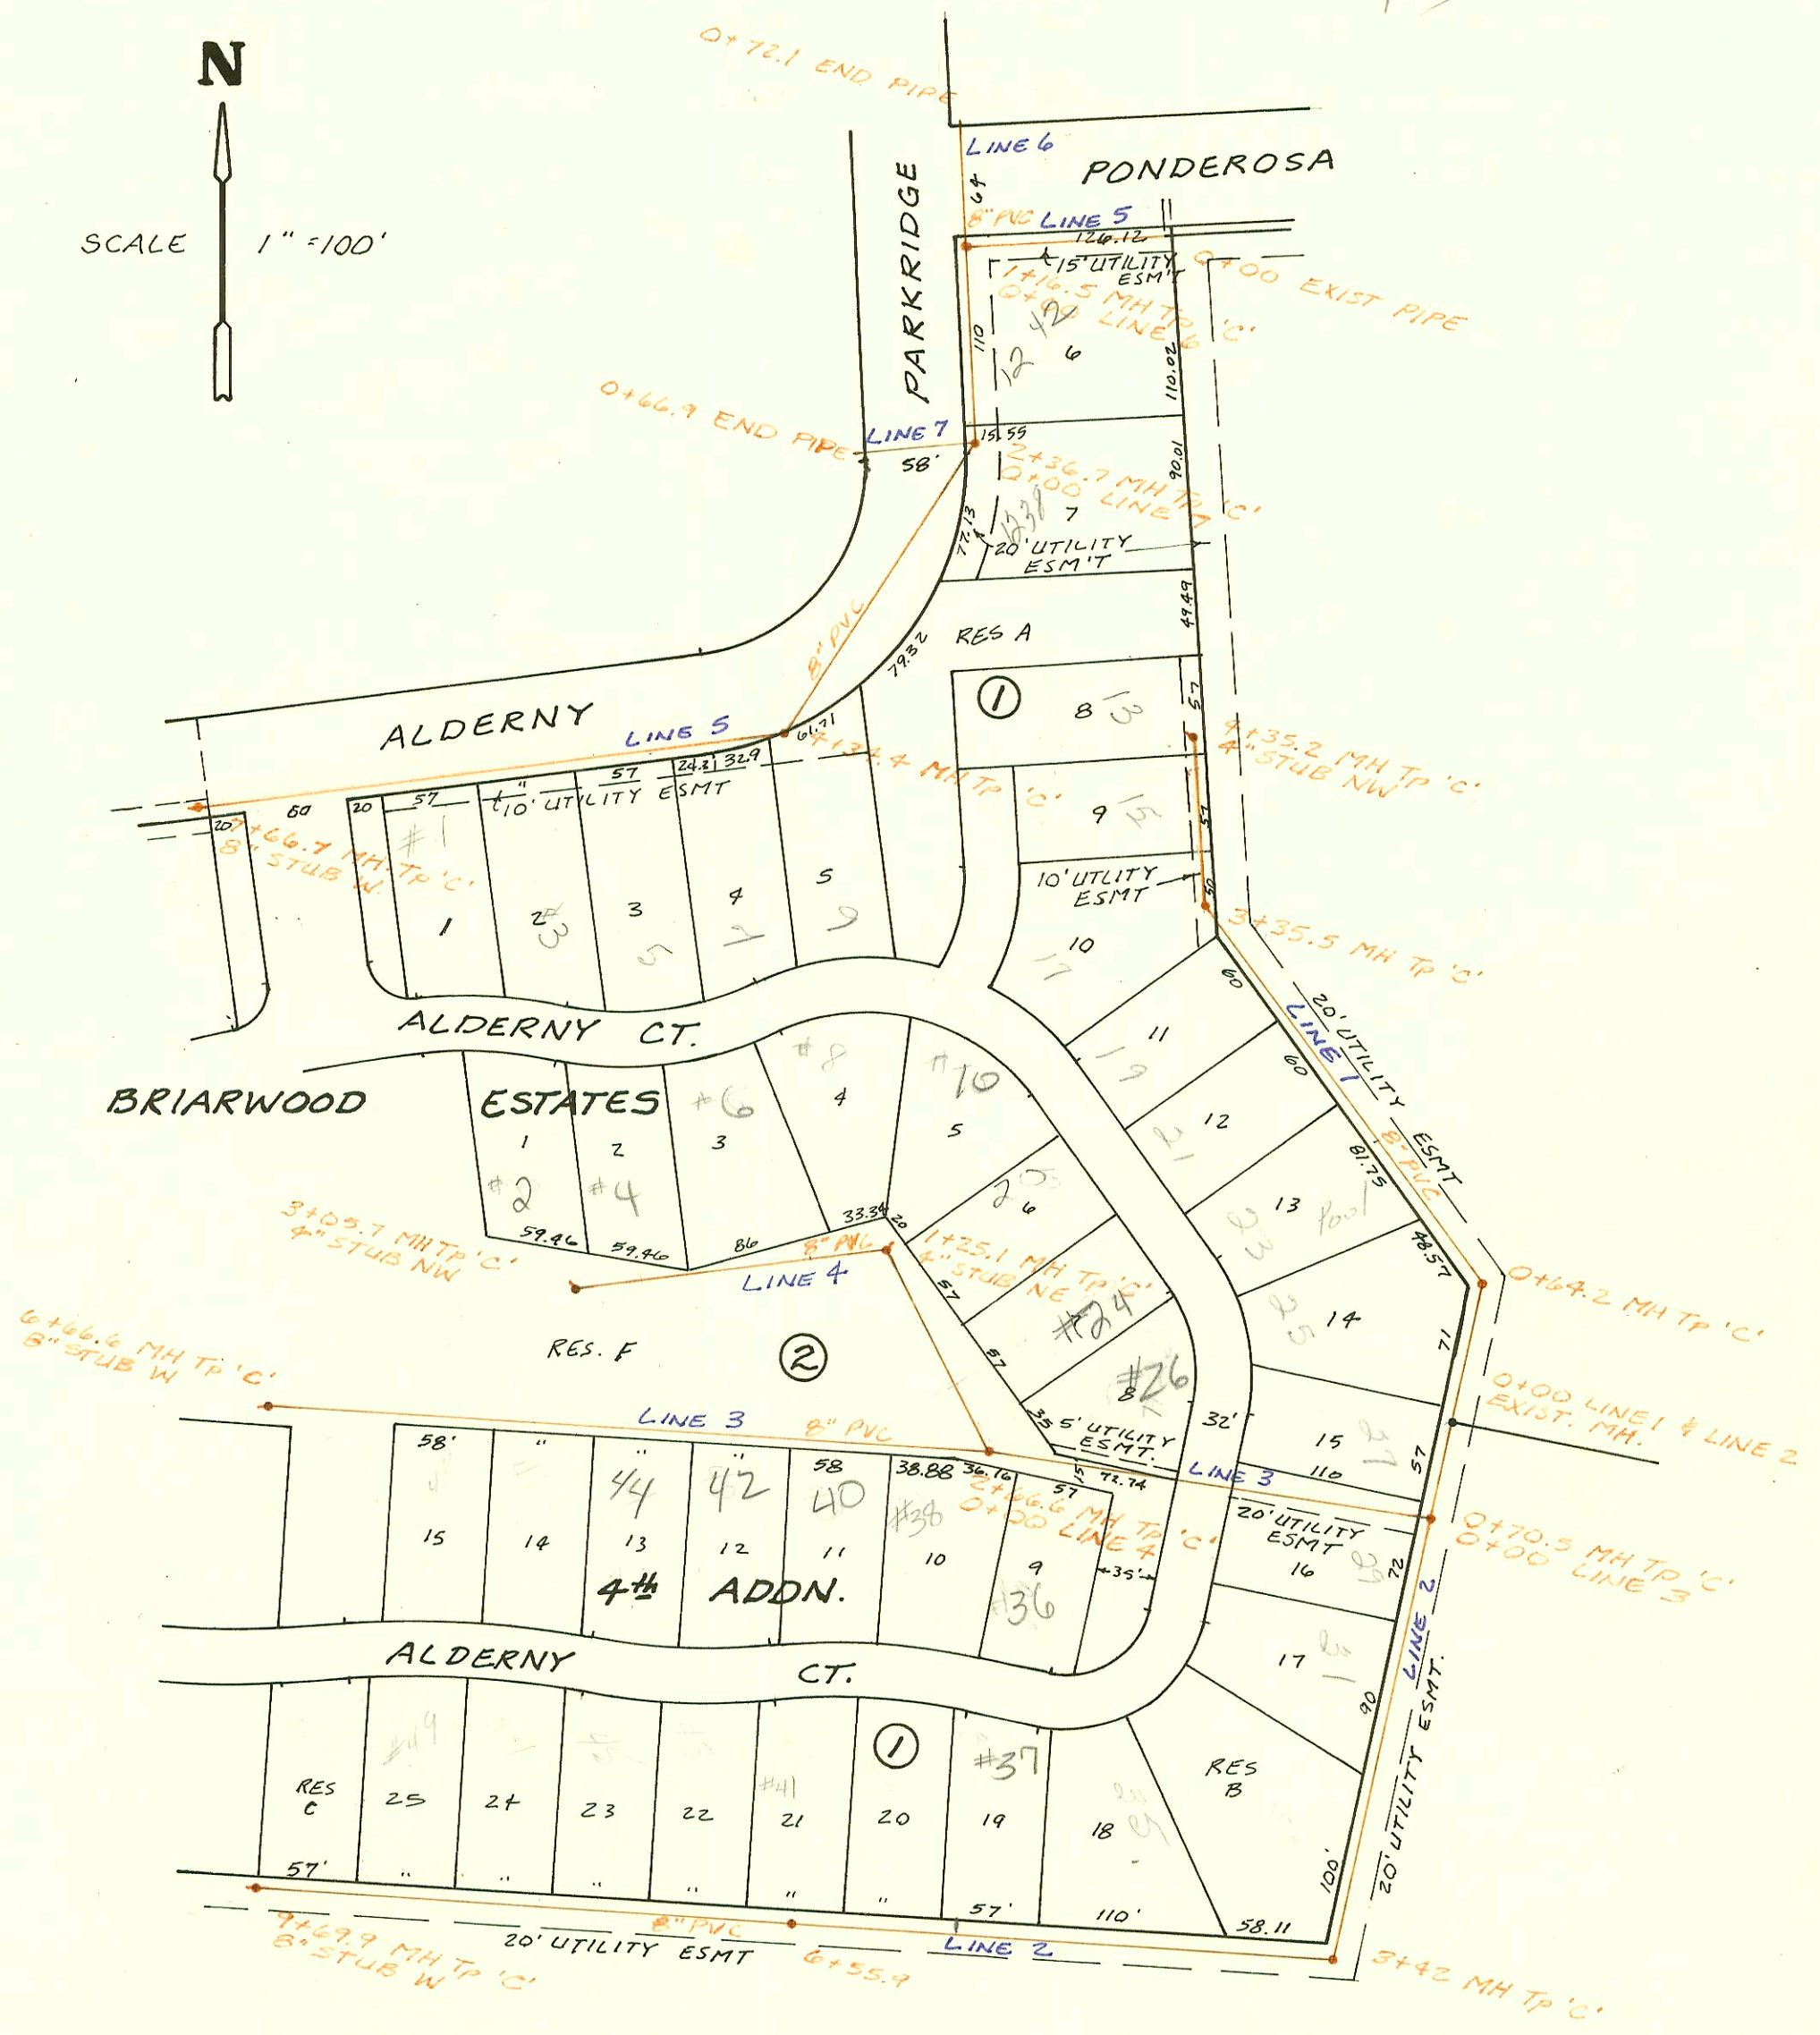


LAT 15, MAIN 12, SW. INTERCEPTOR  
468-76-245-81354-000-000-001  
BUILT BY: DULING CONSTRUCTION CO. INC.  
BOOKED 1-17-85 FROM DCD-200

MP  
4-43  
Plat

11725 Alderney Ct

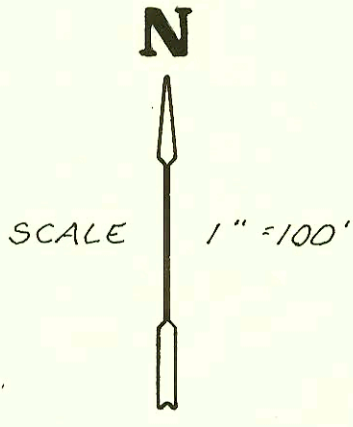

(Above lots addressed as 11725 w Alderney Ct plus a Bldg #)

CONSTRUCTION RECORD						SERVICE RECORD						
STATION	ELEVATION		Depth	MANHOLE	4-INCH "Y" BRANCHES		No. of Permit		House Number		DATE OF PERMITS	
	Ground	Grade			North West	South East	North West	South East	North West	South East	North West	South East
LAT 15, MAIN 12, SW. INTERCEPTOR												
LIN 1	0+00	146.45	137.99	8.5	0+00 EXIST	(11725 W)	Alderney Ct					
		146.53	138.27	8.3	0+64.2	6+88.2 tap	12799	11725 #5 Alderney			12-12-84	
	1+00	146.5	138.39	8.1								
	2+00	146.8	138.73	8.1		1+69.3 tap	12798	11725 #6 Alderney			12-12-84	
						2+29.5 tap	17034	11725 #21 Alderney			9-26-86	
	3+00	145.8	139.06	6.7		2+99.5 tap	25387	11725 Alderney #9			5-29-90	
		148.47	139.18	9.3	3+35.5	3+55.5 tap	12797	11725 Alderney #17			12-12-84	
	4+00	145.6	139.43	6.2		4+01.2 tap	12796	11725 Alderney #15			12-12-84	
		146.10	139.56	6.5	4+35.2	4" STUB NW	12795	11725 Alderney #13			12-12-84	
LIN 2	0+00	146.45	137.99	8.5	0+00 EXIST	0+20.5 tap	13923	11725 Alderney #7			5-30-85	
		146.44	138.23	8.2	0+70.5	0+94.8 tap	16522	11725 Alderney #29			6-24-86	
	1+00	146.5	138.33	8.2								
						1+61.5 tap	12800	11725 Alderney #51			12-12-84	
	2+00	146.4	138.66	7.7								
	3+00	146.1	138.99	7.1								
		146.26	139.13	7.1	3+42.0							
	4+00	146.1	139.31	6.8								
						4+62.5 tap	15442	#55			1-12-86	
	5+00	146.3	139.61	6.7								
						4" SDR 35 5+60.9	23-31177	#37			12-20-93	
	6+00	146.4	139.92	6.5		6+03.9 tap	15613	#39			2-6-86	
		145.95	140.09	5.9	6+55.9	4" SDR 35 6+168.9 tap	23-223677	Alderney #41			8-16-93	
	7+00	146.5	140.21	6.3		7+87.9 tap	18222	11725 Alderney #43			4-27-87	
						7+87.9 tap	26355	Alderney #45			10-22-90	
	8+00	146.7	140.50	6.2		NO MENS. TAKEN	17033	11725 Alderney #44			9-26-86	
						8+82.9 tap	14933	11725 Alderney #42			10-22-85	
	9+00	146.8	140.78	6.0								
		146.97	140.98	6.0	9+69.9	8" STUB W						
LIN 3	0+00	146.44	138.27	8.2	0+00 EXIST	0+70.5 L2						
	1+00	147.5	138.62	8.9								
	2+00	148.4	138.96	9.4		2+04.6	18557	11725 Alderney #26			6-23-87	
		148.98	139.19	9.8	0+00 L4	2+66.6	94-144537	11725 Alderney #36			8-25-94	
	3+00	149.0	139.28	9.7		4" SDR 35 3+39.6 tap	73-17505-7	11725 Alderney #40			7-1-93	
							26-1172-7	11725 Alderney #42			7-29-86	
	4+00	148.7	139.55	9.2			25-104587	11725 Alderney #44			6-27-95	
						4" SDR 35 4+77.6 tap	92-17945	Alderney			1-26-93	
	5+00	148.5	139.83	8.7								
						5+77.6 tap	15974	11725 Alderney #44			6-31-85	
	6+00	148.4	140.10	8.3								
		148.27	140.28	8.0	6+66.6	8" STUB W						
LIN 4	0+00	148.98	139.19	9.8	0+00 EXIST	2+66.6 L3		11725 W Alderney				
	1+00	149.6	139.57	10.0			200-01242	#24			5-19-80	
		149.77	139.66	10.1	1+25.1	4" STUB NE	96-62707	#20			1-30-86	
	2+00	149.5	139.90	9.6		1+60.7 tap	20444	#10			1-13-86	
						1+68.7 tap	19208	#8			10/02/87	
	3+00	149.0	140.21	8.8		2+87.7 tap	19207	#6			10/02/87	
		148.92	140.23	8.7	3+05.7	4" STUB NW	16059	#4			4-11-86	
LIN 5	0+00	148.0	137.82	10.2			16058	#2			4-4-86	
						0+23.5 tap	19212	1242 Park Ridge			10/02/87	
	1+00	148.5	138.03	10.9								
		148.71	138.07	10.6	0+00 L6	1+16.5						
	2+00	148.1	138.42	9.7								
		148.01	138.58	9.4	2+36.7		13964	1231 Alderney			6-22-85	
	3+00	148.0	138.82	9.2								
	4+00	148.4	139.20	9.2			12794	11725 Alderney #9			12-12-84	
		147.85	139.33	8.5	4+34.4	4" SDR 35 4+67.0 tap	23-15231	11725 Alderney #19			6-14-93	
	5+00	148.8	139.54	9.3		5+13.4 tap	12793	11725 Alderney #5			12-12-84	
							96-63979	11725 Alderney #3			4-19-86	
	6+00	149.0	139.85	9.2		6+19.9 tap	21870	11725 Alderney #1			8-9-88	
	7+00	149.0	140.17	8.8								
		148.94	140.38	8.6	7+66.7	8" STUB W						
LIN 6	0+00	148.71	138.19	10.5	0+00 EXIST	1+16.5 L5						
	0+72.1	148.5	138.41	10.1								
LIN 7	0+00	148.01	138.67	9.3	0+00 EXIST	2+36.7 L5						