



LAT 65. WAR INDUSTRIES SEWER  
 468-76-245-80976-000-000-001  
 BUILT BY WILDCAT CONSTRUCTION.  
 BOOKED 7-5-85 FROM JLA #32

12-59

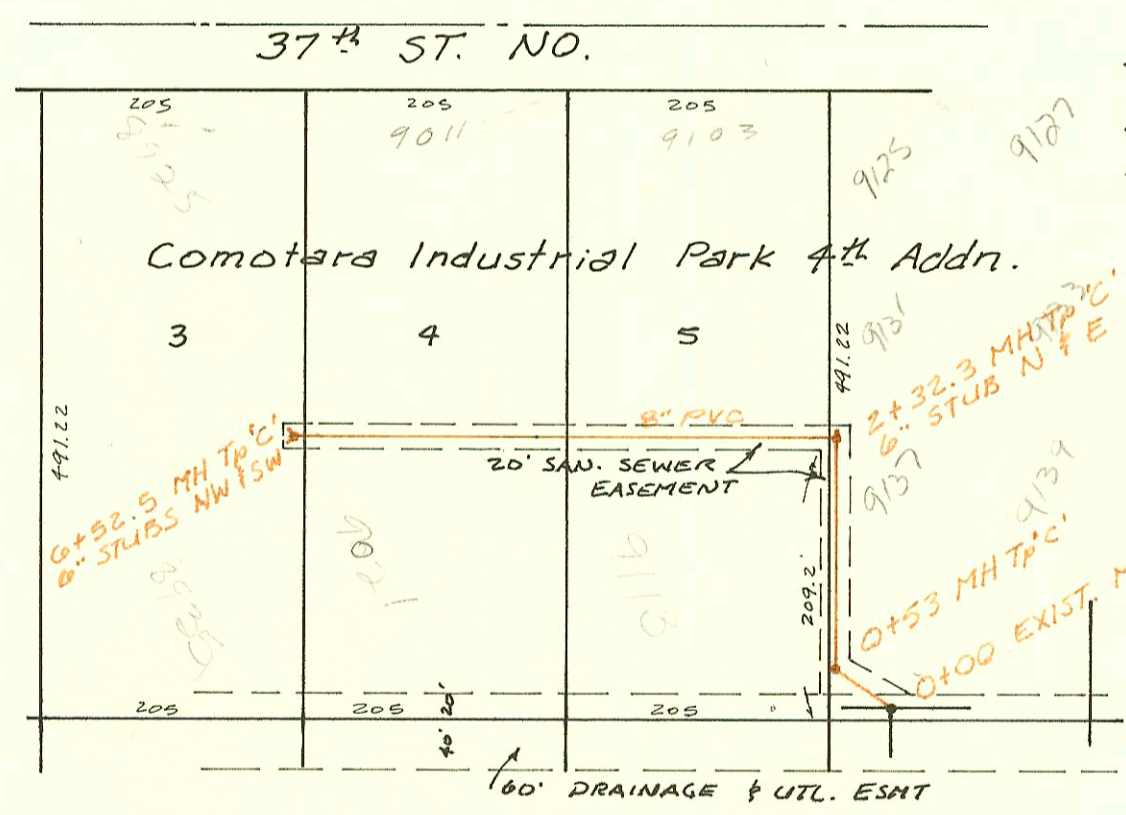


Priv. S.S. to serve Lots 3, 4, 5 Comotara  
 Industrial Park 4th Addition  
 468-76-245-80000-000-000-008  
 BUILT BY LA CUESTA CORP.  
 BOOKED 7-10-1985 FROM MGP-22

12-59

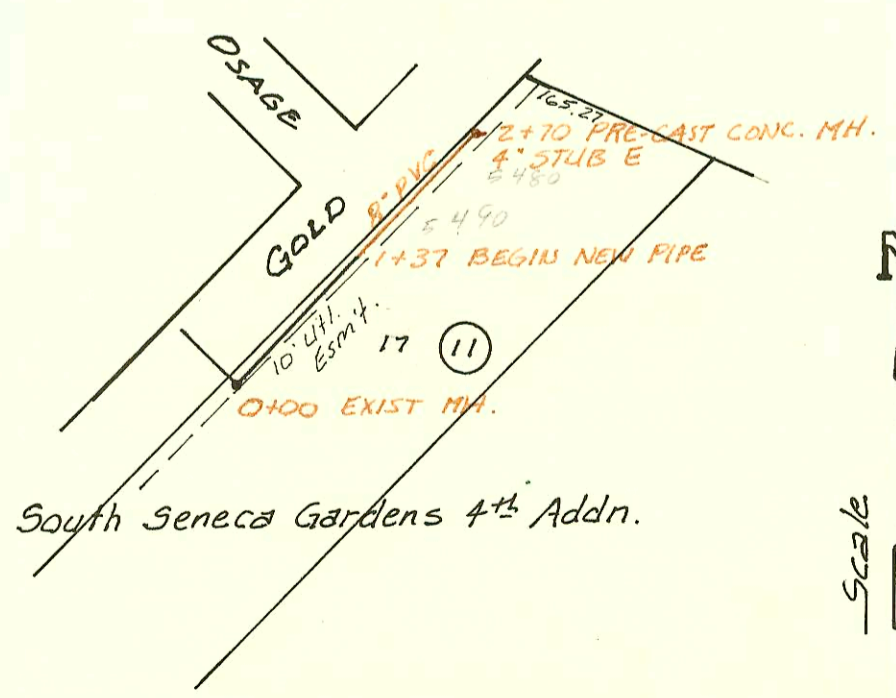

Priv. S.S. Ext. for Part of Lot 17, Blk 11  
 South Seneca Gardens 4th Addition  
 468-76-245-80001-000-000-018  
 BUILT BY GERALD'S SEWER SERVICE  
 BOOKED 7-11-85 FROM TCD-1

8-90

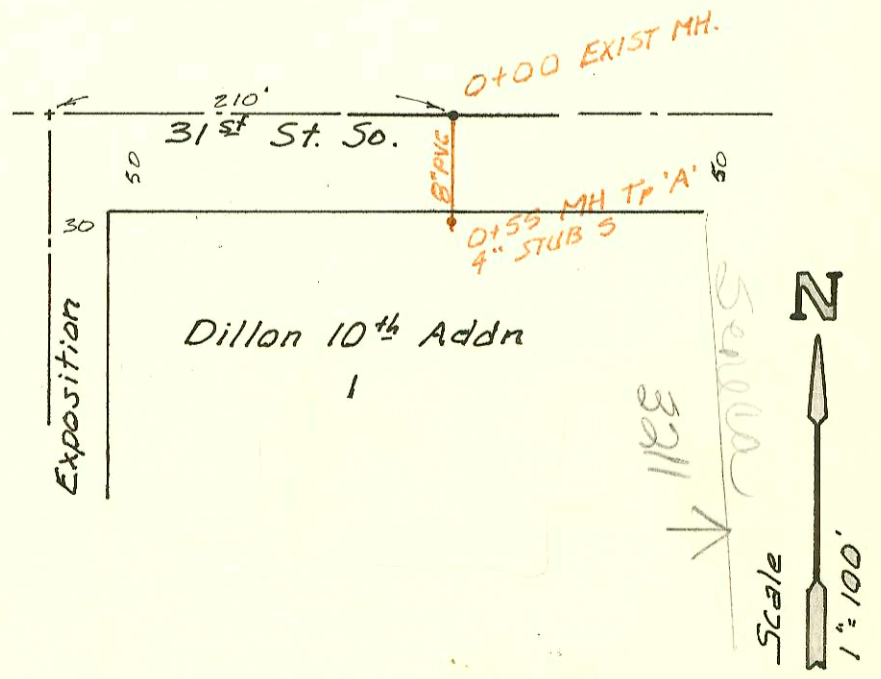

Priv. S.S. Ext. for Dillon's at 31st St. So. & Exposition  
 468-76-245-80001-000-000-022  
 BUILT BY WILDCAT CONST.  
 BOOKED 7-12-85 FROM CG-24

8-77

CONSTRUCTION RECORD							SERVICE RECORD					
STATION	ELEVATION		Depth	MANHOLE	4-INCH "Y" BRANCHES		No. of Permit		House Number		DATE OF PERMITS	
	Ground	Grade			North West	South East	North West	South East	North West	South East	North West	South East
LAT 65												
W/IS.												
0+00	135.18	118.30	16.9	0+00 EXIST								
1+00	136.6	120.90	15.7									
	137.82	121.52 OUT	16.3									
2+00	137.1	128.26 IN	9.6	1+24.0								
		128.49	8.6				22017		1236	HARRY		11-21-88
3+00	137.2	128.79	8.4									
4+00	137.4	129.09	8.3									
	137.89	129.38 OUT	8.6	4+74.4								
5+00	137.7	129.54 IN	8.6									
		129.85	7.9									
					5+55.4 TAP		22018		1236	HARRY		11-21-88
6+00	138.8	131.08	7.7									
	140.06	131.92 OUT	8.1	6+68.8								
7+00	138.4	132.26 IN	8.1									
	140.09	132.63	5.8									
		133.23 OUT	6.9	7+49.9	M.H. 4x6 SW		14123		7160 E	HARRY # 192		6-27-85
Priv. S.S. for Lots 3, 4, 5 Comotara Industrial Park 4th Addition												
0+00	238.8	225.50	13.3	0+00 EXIST.								
	235.9	225.71 OUT	10.2	0+53								
1+00	238.7	225.81 IN	10.2									
		225.99	12.7									
2+00	238.7	226.39	12.3									
	237.6	226.53 OUT	11.1	2+32.2	6" STUB N	6" STUB E		2000-00936		9131 E	37th ST N	4-12-04
3+00	237.0	226.63 IN	11.1									
		226.90	10.1									
4+00	237.4	227.30	10.1									
5+00	236.2	227.70	8.5									
6+00	234.6	228.10	6.5									
	234.9	228.31	6.6	6+52.2	6" STUB NW	6" STUB SW				90' E	37th N	4-1-85
Priv. S.S. Ext. for Part of Lot 17, Blk 11 South Seneca Gardens 4th Addn.												
0+00	82.1	72.94	9.2	0+00 EXIST MH								
1+37	81.5	73.09	8.4									
2+00	81.5	73.15	8.4									
	82.00	73.23	8.8	2+70								
Priv. S.S. Ext. for DILLON'S at 31st St. So of Exposition												
0+00	95.48	90.23	5.3	0+00 EXIST								
	96.41	91.47	4.9	0+55								