



LAT 142 SANITARY SEWER # 22
 468-76-245-81315-000-000-001
 BUILT BY STANNARD CONST.
 Booked 8-20-85 From DLK 449



7-58

LAT 4, MAIN 4, WESTLINK SEWER
 468-76-245-81408-000-000-001
 Built By MID-STATES CONST.
 Booked 8-27-85 From JLA-35

HP
 5-37

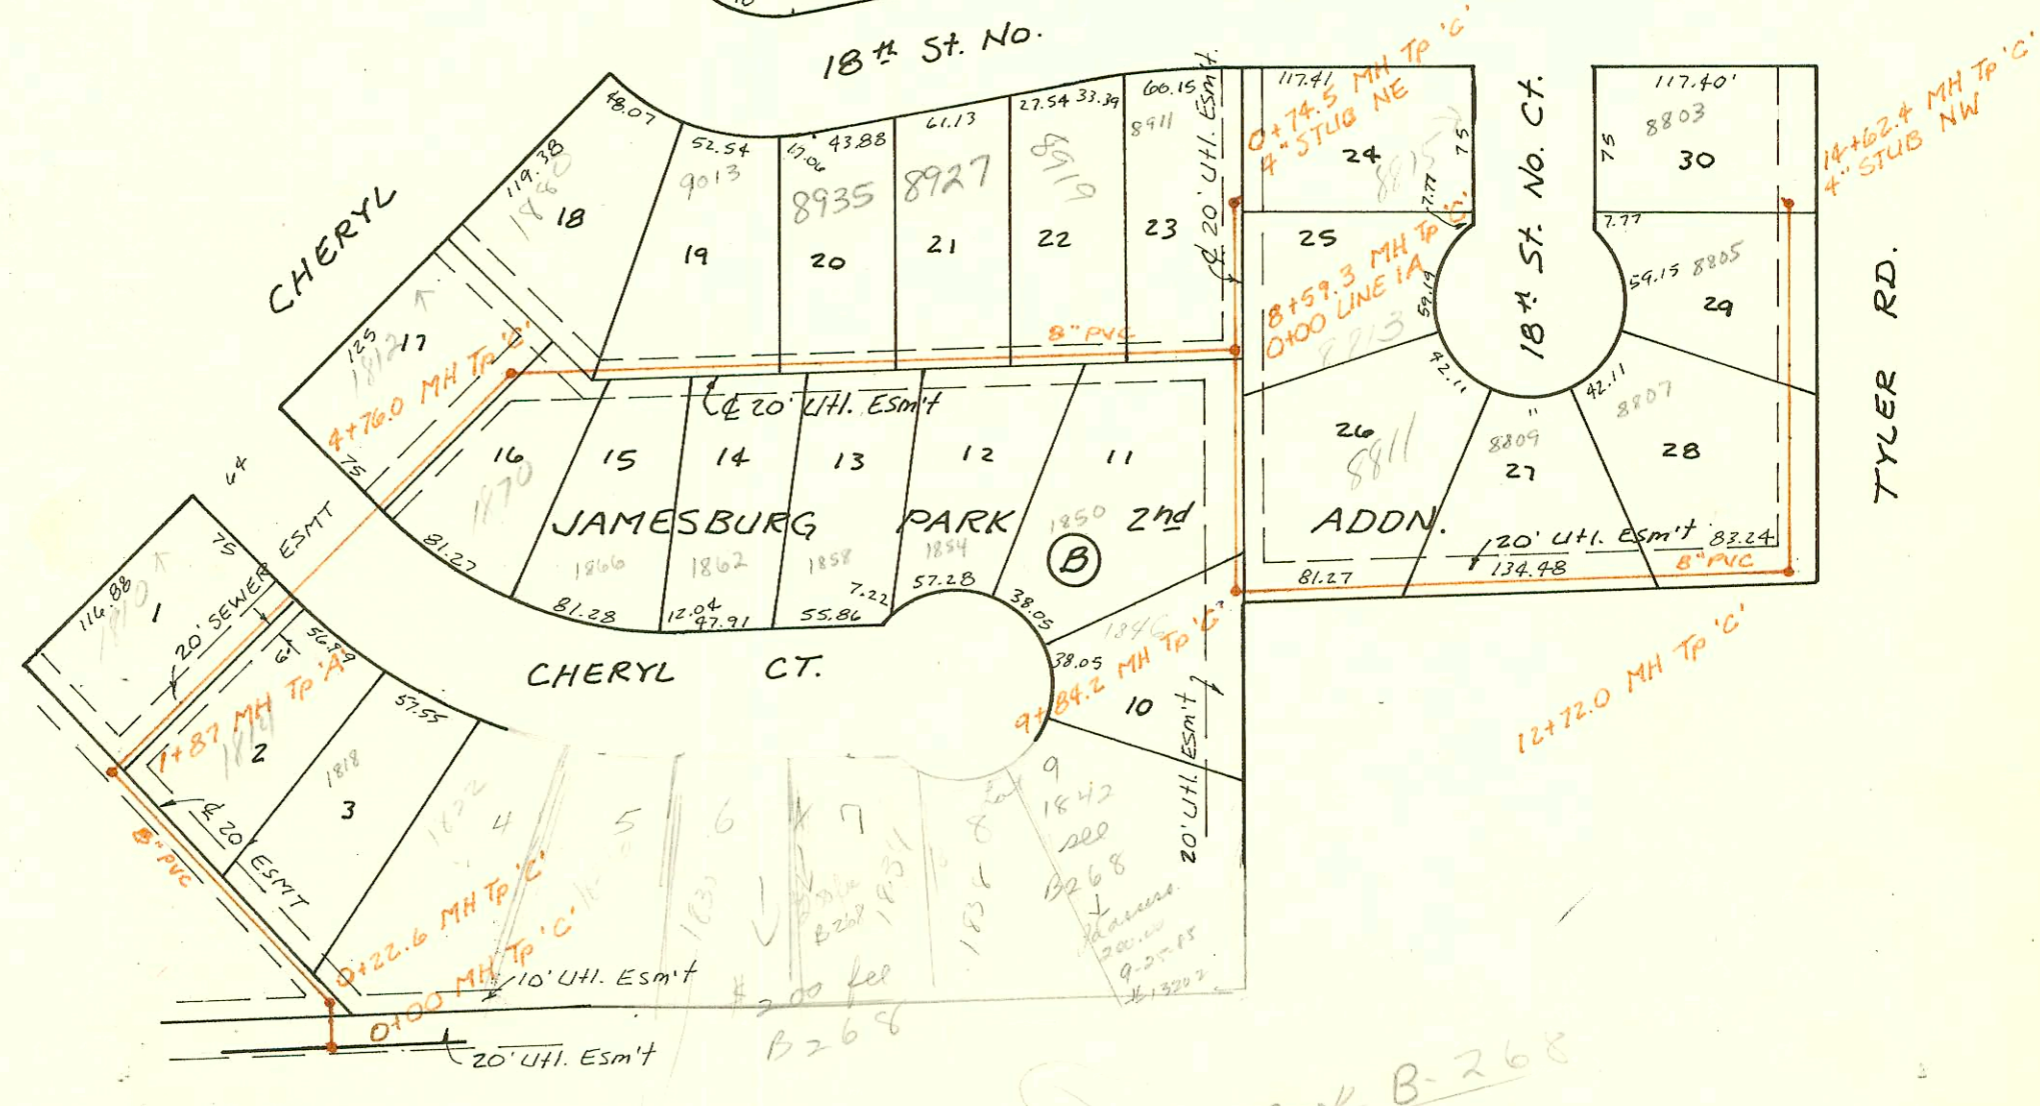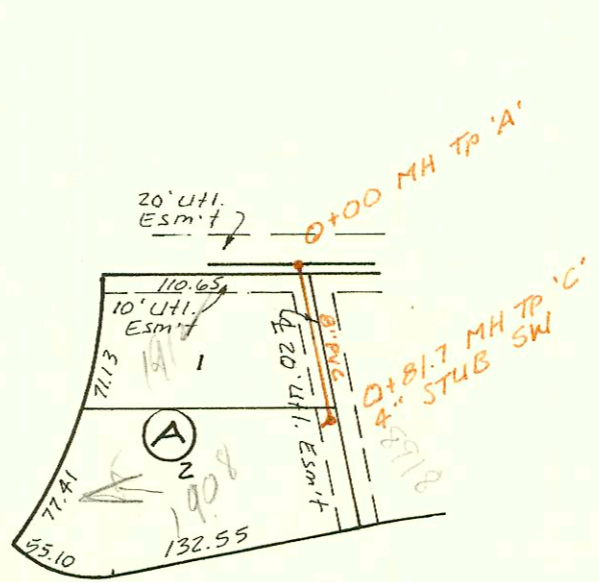

Refer to Book B-268

1830 added
 2nd 23 87

