


HARRY



MAIN 14, SW INTERCEPTOR
 46B-76-245-81193-000-000-001
 BUILT BY WILDCAT CONST.
 Booked 5-86 From DLK-463

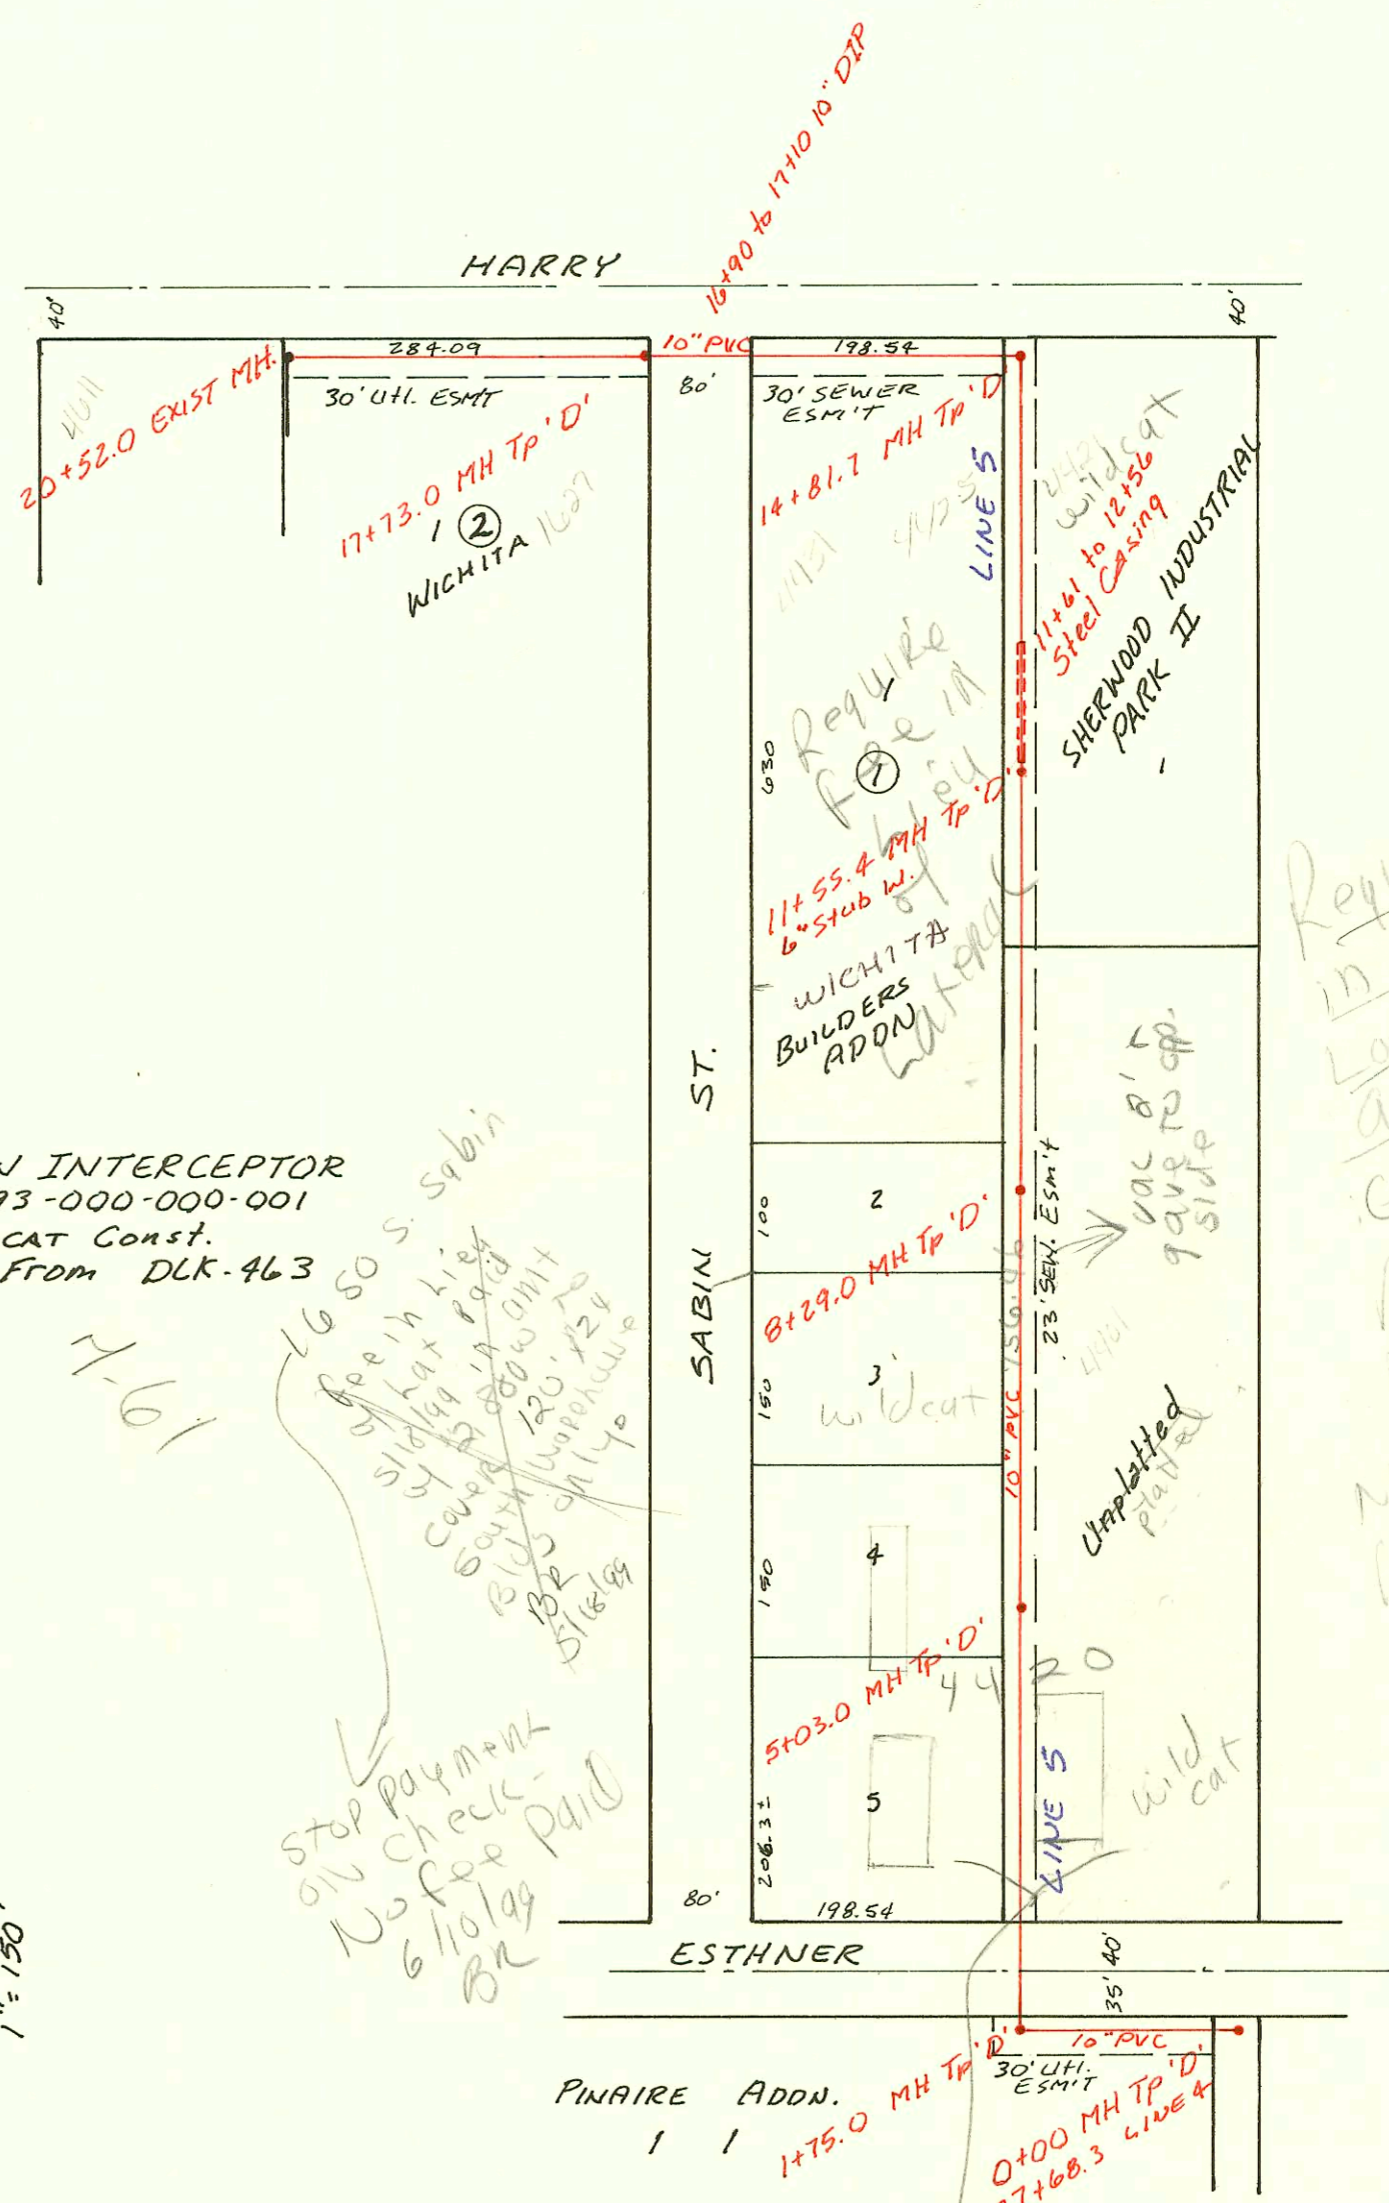

7-61
 1650 S. Sabin
 Stop payment
 oil check
 No fee paid
 6/10/99
 BR

Require a fee
 in lieu of
 lateral
 assess. if a
 connection to
 Main 14 is
 requested and
 no such lateral
 fee has been
 paid. see
 volume 5
 1073-94

wildcat const
 4420 w ESTHNER
 City Engineer had
 wildcat sign Petition
 that they will be incl
 in a lateral B/D
 when formed
 1073-94

