


Addresses that are underlined have Building Permits on them as of 5-28-87

LAT 34, MAIN 7, S.S. #23
46B-76-245-B1432-000-000-001
Built By Wildcat Const.
Booked 7-31-86 From MGP-21

12-31

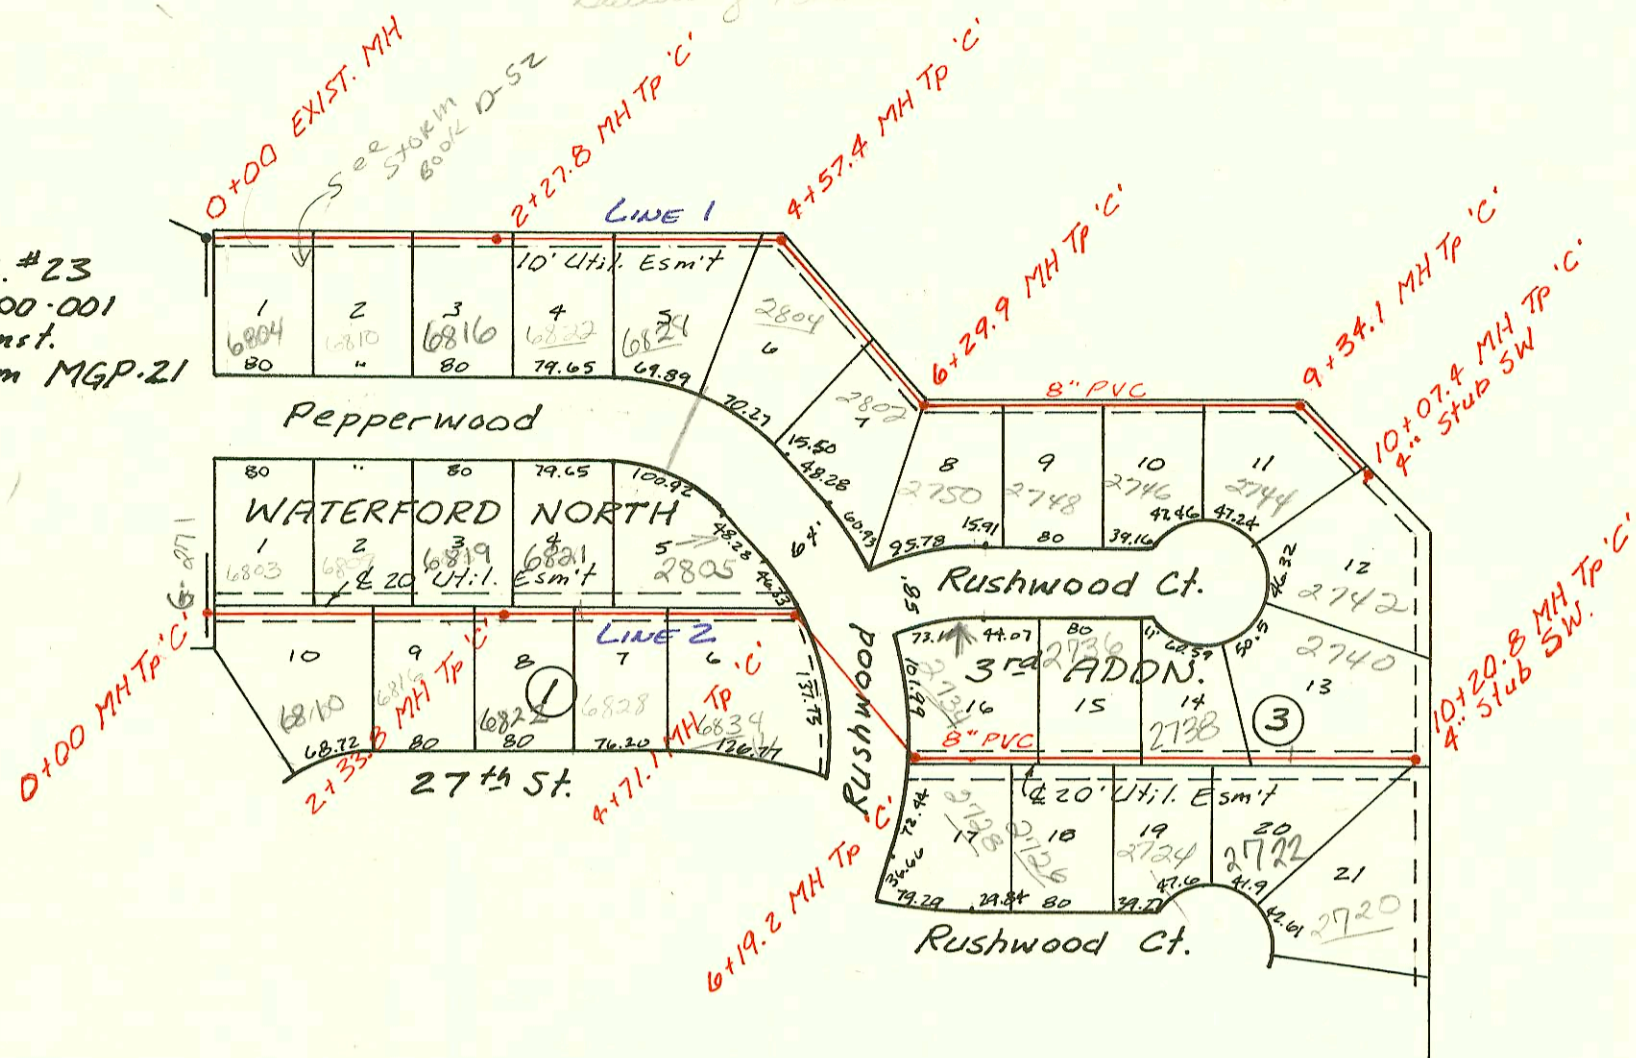

Gouverneur

CONSTRUCTION RECORD						SERVICE RECORD							
STATION	ELEVATION		Depth	MANHOLE	4-INCH "Y" BRANCHES		No. of Permit		House Number		DATE OF PERMITS		
	Ground	Grade			North West	South East	North West	South East	North West	South East	North West	South East	
LAT 34, LINE 1	Main 7, S.S. # 23												
	0+00	176.43	166.25	10.5	EXIST. 0+00	4" SDR 35 56.0 tap		93-19898-7	6854 Pepperwood			7-23-93	
	1+00	179.4	167.92	11.7		4" ABS 1+91.0 tap		92-17113-7	6810 Pepperwood			7-21-92	
	2+00	181.0	169.60	11.4		2+10.8 TAP		24256	6816 Pepperwood			11-8-89	
		181.34	170.06	11.3	2+27.8	2+92.8 TAP		28108	6822 Pepperwood			5-28-87	
	3+00	182.2	170.80	11.4									
						3+94.4 TAP		18180	6828 Pepperwood				4-22-87
	4+00	182.8	171.82	12.0									
		182.83	172.40 OUT 172.46 IN	10.4	4+57.4	4+49.4 TAP		18438	2804 N. Rushwood				6-3-87
	5+00	183.5	172.89	10.6									
6+00	184.1	173.90	10.2		6+08.9 TAP		22453	7802 Rushwood				1-20-89	
	184.55	174.20	10.4	6+29.9	6+58.9 TAP		20864	7150 Rushwood				6-13-88	
7+00	184.4	174.78	9.6		7+39.9 TAP		23594	2448 Rushwood				7-24-89	
					7+83.9 TAP		20648	8146 Rushwood				5-6-88	
8+00	185.6	175.61	10.0										
					8+96.0 TAP		21131	2144 Rushwood				7-21-88	
9+00	186.6	176.44	10.2										
	186.90	176.72	10.2	9+34.1									
10+00	187.8	177.28	10.5										
	187.94	177.34	10.6	10+07.4	4" stub SW		19605	2192 N. Rushwood				11/10/87	
LINE 2	0+00	178.73	167.11	11.6	EXIST. 0+00	4" SDR 35 1+04 tap		76-14922-7	6853 Pepperwood			9-9-96	
	1+00	181.3	169.23	12.1		4" SDR 35 1+73.0 tap		228132-7	6807 Pepperwood	6810 E. 27th N		9-11-92	
								22866	6810 Pepperwood			4-6-89	
	2+00	182.2	171.35	10.9				229210-7	6819 Pepperwood			6-4-92	
		182.80	172.07 OUT 172.14 IN	10.7	2+33.8	4" SDR 4" SCH 40 PVC 2+92.8 Saddle	4" SDR 1+91.8 tap	2001 00476	22428-7	6821 Pepperwood	6816 E. 27th N		3-5-01
	3+00	182.5	172.41	10.1				9-3852-7	6822 E. 27th N			12-4-91	
								00388	6828 E. 27th N				5-27-91
	4+00	183.8	172.82	11.0		4+21.1 TAP	4+41.1 TAP	24175	17931	2805 Rushwood	6834 E. 27th N		10-27-84
		184.00	173.11 OUT 173.15 IN	10.9	4+71.1								3-2-87
	5+00	183.4	173.45	10.0									
6+00	184.4	174.48	9.9										
	185.66	174.68 OUT 174.71 IN	11.0	6+19.2	6+64.2 TAP	6+74.2 TAP	17024	17023	2734 Rushwood	2782 Rushwood		9-24-86	
7+00	185.2	175.16	10.0										
					7+63.2 TAP	7+46.2 TAP	24174	17022	2736 Rushwood	2726 Rushwood		10-27-89	
8+00	185.9	175.72	10.2										
								22865	2724 Rushwood			4-6-87	
9+00	187.0	176.28	10.7		9+84.8 TAP		19442		2738 Rushwood			1-12-88	
								96957	2740 Rushwood			4-25-96	
10+00	187.5	176.84	10.7										
	187.52	176.96	10.6	10+20.8	4" stub SW		17793		2720 N. Rushwood			2-10-87	
LAT 19, MAIN 9, S.S. # 23	33+00	207.5	195.59	11.9									
		208.21	195.70 195.79	12.5	33+27.3	6" SDR 35 TAP 35' E Tap 2' ATT				8200 (addition) Kent A. Centek		7-23-93	
	34+00	208.4	196.09	12.3				93-19274-7					
	35+00	209.2	196.50	12.7									
	36+00	210.0	196.91	13.1									
	37+00		197.32					94960-7		8200 (addition) Kent A. Centek		6-15-94	
		210.98	197.34	13.6	37+03.8								
	38+00	211.0	197.75	13.3									
	39+00	211.5	198.18	13.3									
	40+00	210.8	198.61	12.2									
41+00	210.0	199.04	11.0										
42+00	210.2	199.47	10.7										
	210.54	199.56	11.0	42+21.6	8" STUB NC								