
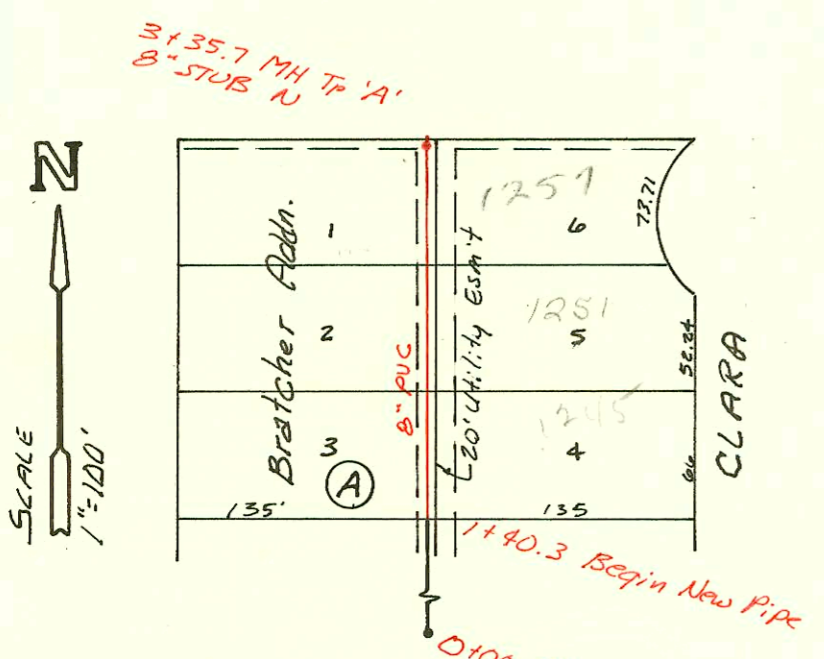


LAT 2, MAIN 14, SW INTERCEPTOR
 468-76-245-81542-000-000-001
 Built By Stannard Const.
 Booked 9-18-86 From BR-123


LAT 90 WAR INDUSTRIES SEWER
 468-76-245-81549-000-000-001
 Built By Triple 'C'
 Booked 9-25-86 From AG-11

CLEAR

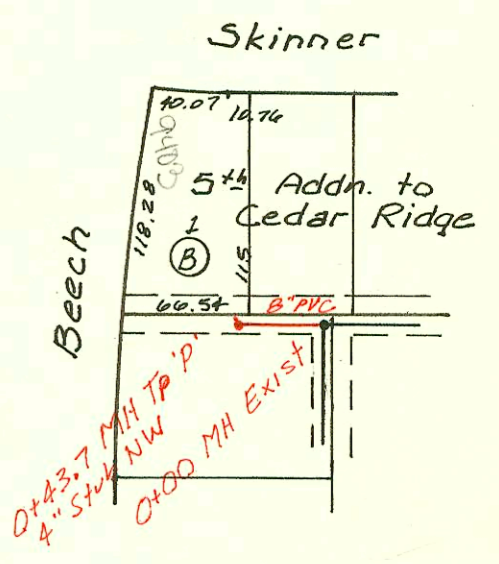

Priv. S.S. Ext. to Serve Blk A, Bratcher Addn.
 468-76-245-80001-000-000-034
 Built By Triple 'C'
 Booked 11-6-86 From MGP 4

CLEAR 6-4/86

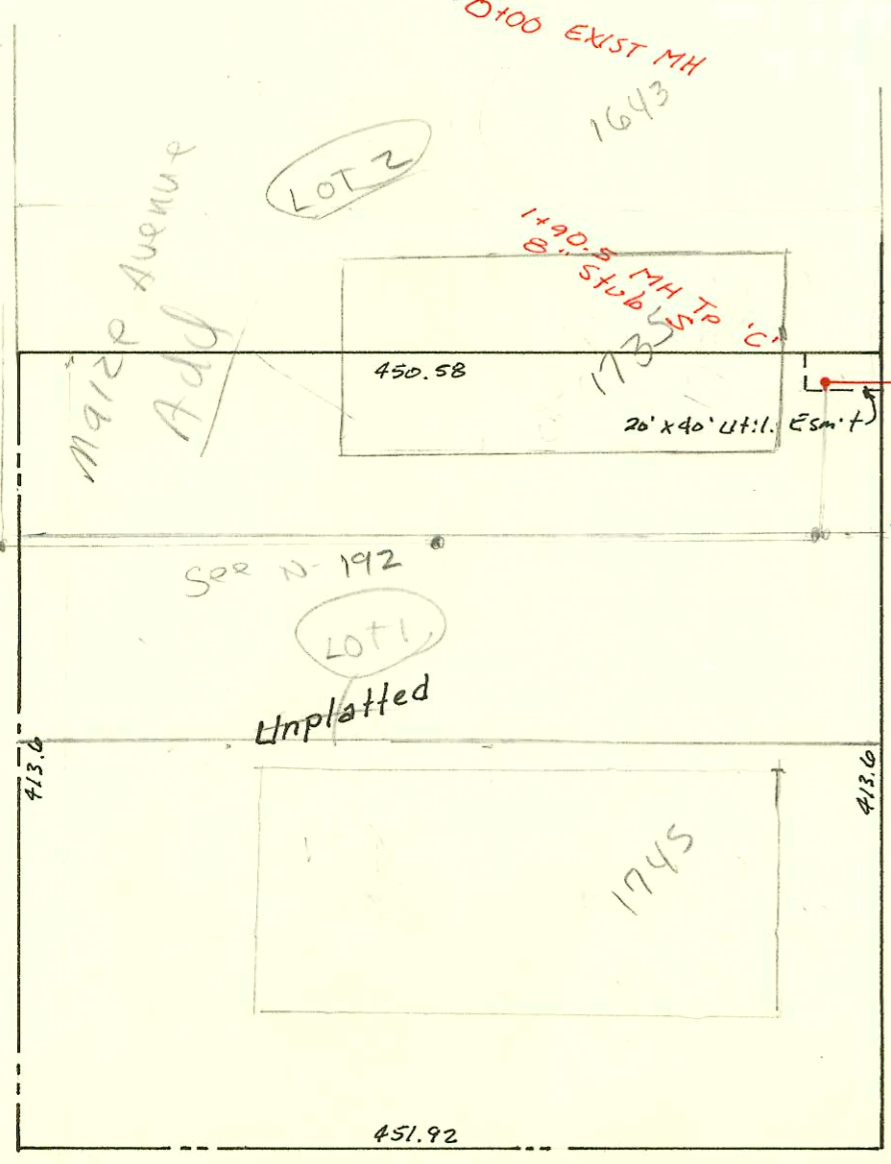

LAT 217 SW. Interceptor
 468-76-245-81543-000-000-001
 Built By Mid-states Const.
 Booked 11-5-86 From JLA-35



630

