
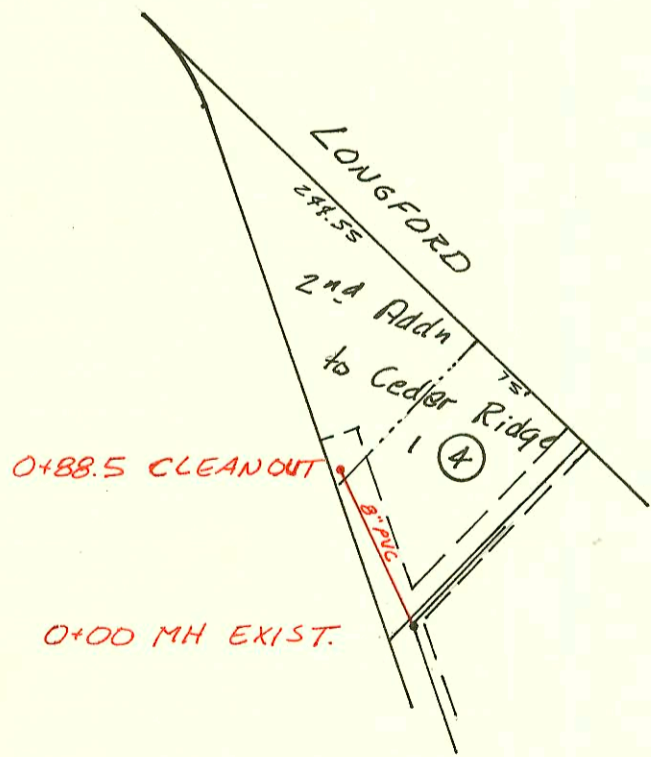


LAT B4, WAR INDUSTRIES SEWER
468-76-245-81531-000-000-001
Built By Mid-States
Booked 11-17-86 From DCD-250

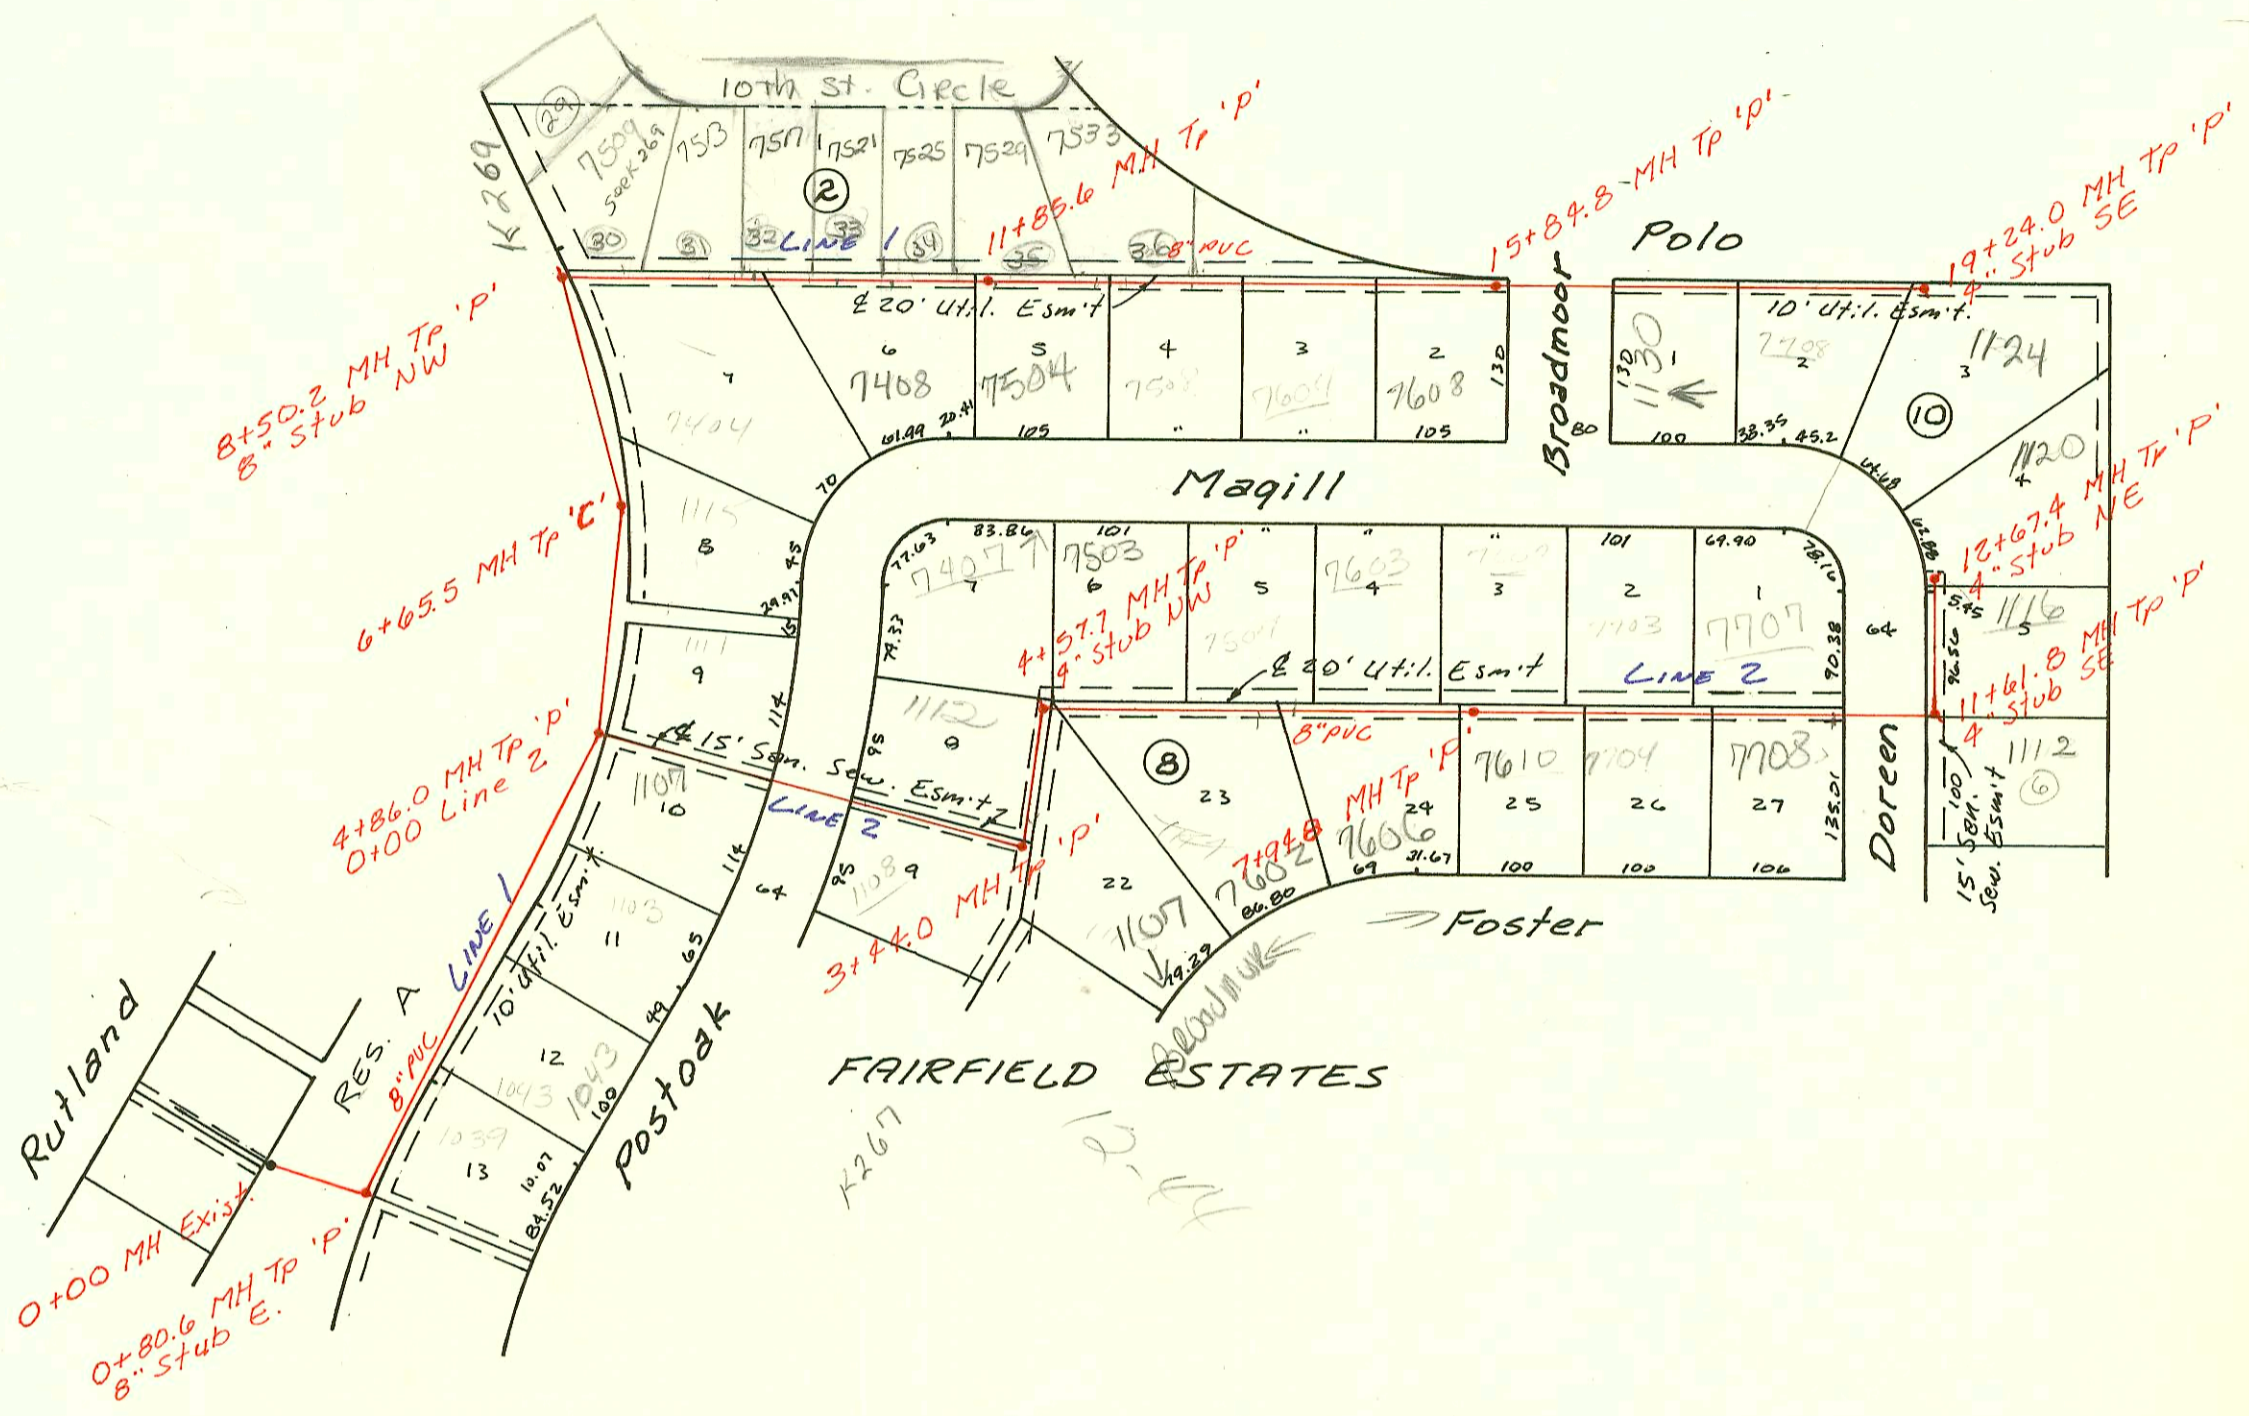

Priv. San. Sewer for Lot 1, Blk 4, 2nd Addn to Cedar Ridge
448-76-245-80001-000-000-083
Built By TRIANA CONST. Co.
Booked 6-25-87 From LES-17

CONSTRUCTION RECORD

SERVICE RECORD

LAT 84, W.I.S.
LINE 1

STATION	ELEVATION		Depth	MANHOLE	4-INCH "Y" BRANCHES		No. of Permit		House Number		DATE OF PERMITS	
	Ground	Grade			North West	South East	North West	South East	North West	South East	North West	South East
0+00	176.60	166.60	10.0	EXIST. MH								
1+00	176.3	167.19	9.1	0+80.6		8" stub E	93-19117		1039 W Post Oak			4-30-93
2+00	176.8	167.55	9.3			4" SOR 35 2+56.6	94-1433-7		1043 Post Oak			1-25-94
3+00	177.1	167.92	9.2			4" SOR 35 3+28.0 TAP	94-19899-5		1103 Post Oak			4-9-94
4+00	177.5	168.28	9.2	0+00 L-2		4+39.0 TAP	20828		1107 Post Oak			6-8-92
5+00	178.3	168.73	9.6	4+86.0								
6+00	178.1	169.04	9.1			6+41.0 TAP	19379		11510 Post Oak			10/23/87
7+00	179.0	169.74	9.1	6+65.5								
8+00	181.5	170.22	11.3									
9+00	182.4	172.84	9.8	8+50.2		8" stub NW	21762		7504 E 10th CL			10-24-88
10+00	183.9	173.21	10.7			9+18.2 TAP	23256		7513 E 10th CL			8-01-88
11+00	185.0	173.58	11.4			10+01.6 TAP	20456	19954	7511 E 10th CL	7404 Magill		4-13-88
12+00	186.2	174.02	12.2	11+85.6		10+63.9 TAP	20455		7501 E 10th CL			4-13-88
13+00	187.1	174.43	12.7			11+09.6 TAP	20501	7452577	7523 E 10th CL	7408 Magill		4-19-88
14+00	187.9	174.84	13.1			11+74.6 TAP	20505		7529 E 10th CL			4-19-88
15+00	187.5	175.25	12.3			12+68.6 TAP	20506	2000-01179	7533 E 10th CL	7504 E Magill		5-10-00
16+00	186.8	175.70	11.1									
17+00	187.0	176.06	10.9			13+45.6 TAP	25994		7508 Magill			8-22-90
18+00	187.1	176.43	10.7			13+96.4" RIS	17001		7601 Z Magill			3-10-87
19+00	187.5	176.79	10.7			5+176.39						
0+00	178.69	169.03	9.7	0+00		15+06.3 TAP	21502		7608 E Magill			9-19-88
1+00	182.4	169.78	12.7			15+01.9" RIS						
2+00	183.5	170.54	13.0			5 176.20						
3+00	184.5	171.29	13.2			17+12.8 TAP	23767		7608 E Magill			8-16-89
4+00	185.2	172.23	13.0			18+42.0 TAP	19523		7708 E Magill			6-22-87
5+00	185.6	172.64	13.0			4" stub SE	94-3127		7708 E Magill (Post Oak)			3-1-91
6+00	186.0	172.96	13.0			19+24.0	20597		7724 Dorsey			4-29-88
7+00	185.8	173.28	12.5			0+82.0 TAP	19362		1111 W Post Oak			10/20/87
8+00	185.6	173.62	12.0			2+17.5 4" RIS						
9+00	185.2	173.91	11.3			3+10.0 TAP	19143	25759	1118 W Post Oak	1108 Post Oak		9/24/87
10+00	184.5	174.19	10.3			3+10.0 TAP	2001	22872		1107 Broadmead		9-11-01
11+00	183.5	174.47	9.0			3+10.0 TAP						
12+00	184.0	175.44	8.6			3+10.0 TAP						
13+00	184.87	176.33	8.5			3+10.0 TAP						
0+00	165.3	154.71	10.6	0+00		4" stub NW	18354		7404 E Magill			5-18-87
1+00	166.0	155.13	10.9	CLEANOUT		4" stub NW	20395		7503 Magill			4-4-88
2+00						4" stub NW	20481		7507 Magill			4-15-88
3+00						6+31.2 4" RIS	93-11017		7602 E Foster			5-7-93
4+00						6+51.2 4" RIS	18353	98-20707	7606 E Foster			5-5-96
5+00						7+78.2 4" RIS	19195		7607 E Foster			10/01/87
6+00						8+39.9	93-29806		7610 Foster			10-26-93
7+00						9+22.8 TAP	18215	94-751-7	7703 Magill	7704 Foster		8-3-87
8+00						10+15.3 TAP	18312	2001	7707 Magill	7708 Foster		5-12-87
9+00						11+61.8						
10+00						12+27.4 TAP	19367		1121 Broadmead			10/19/87
11+00						12+27.4 TAP	20589		1116 W Dorsey			4-29-88
12+00						4" stub NE	23120		1120 W Dorsey			5-10-89

LINE 2

Priv. San. Sewer for Lot 1, Blk 4, 2nd Addn. to Cedar Ridge