

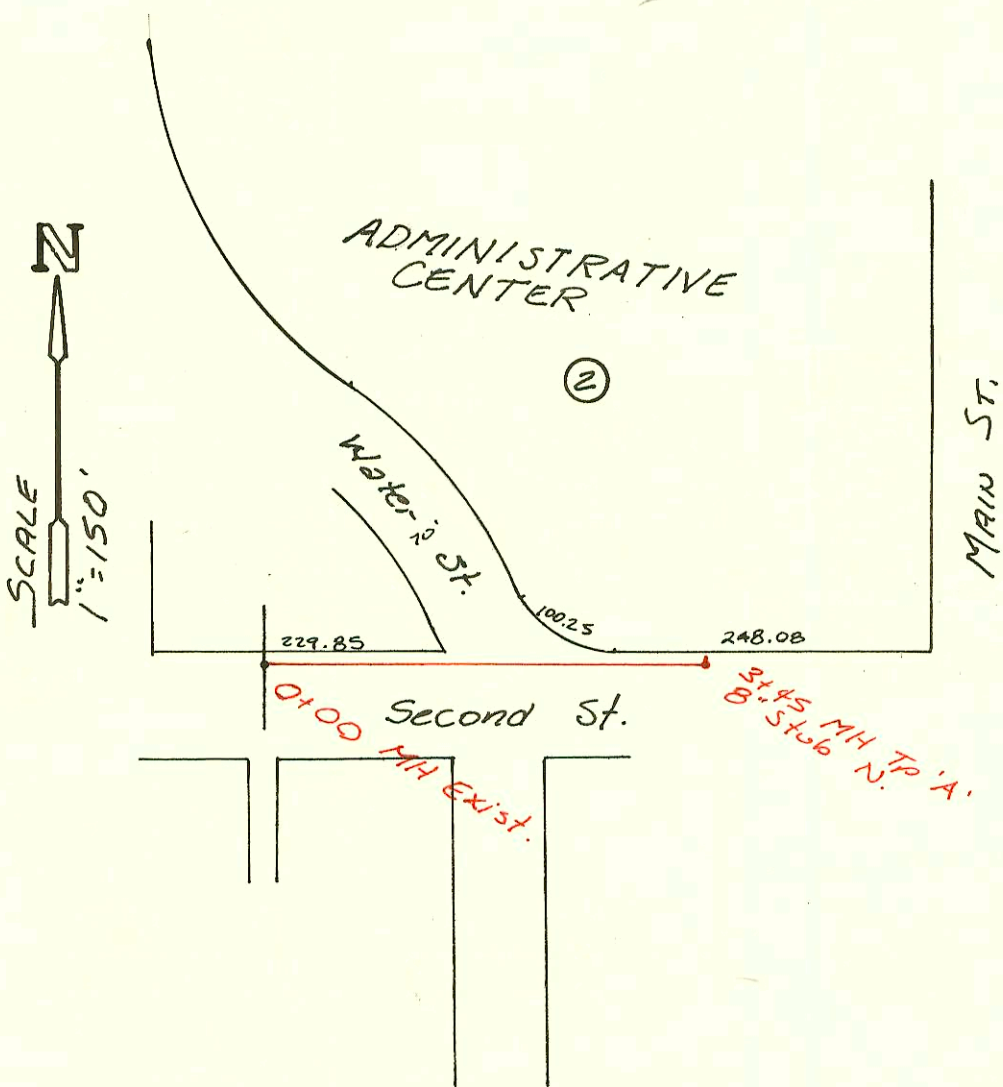


LAT 119, SW INTERCEPTOR
46B-76-245-80491-000-000-001
Built By Stannard Const.
Booked 11-24-86 From DGD-226

LAT 225 SW INTERCEPTOR
46B-76-245-81595-000-000-001
Built By Wildcat Const.
Booked 11-24-86 From 10-W

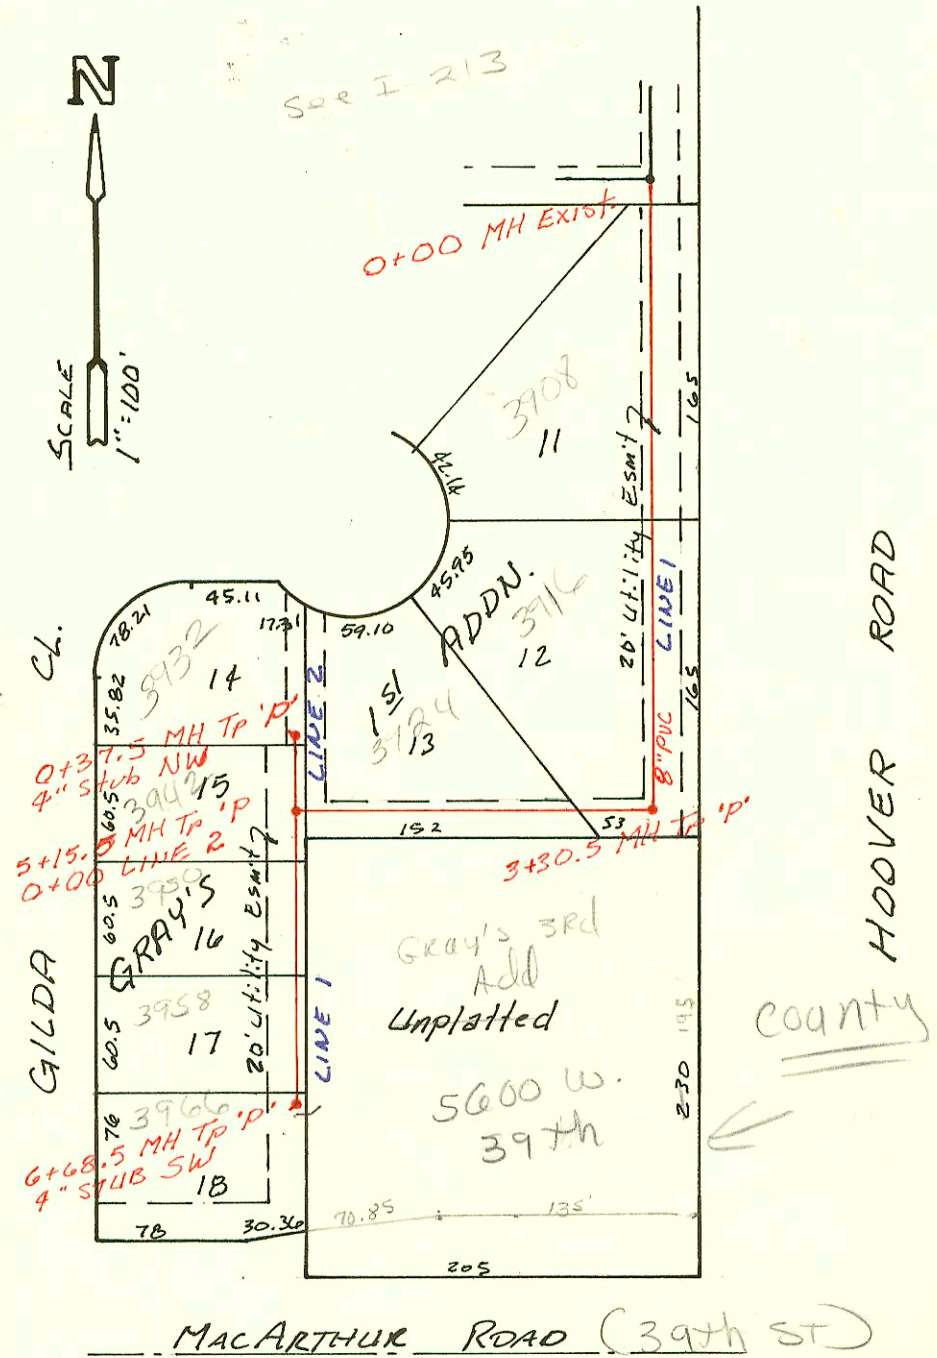

Priv. San. Sewer to Serve THE EPIL CENTER
at 2nd St. & Water
46B-76-245-80001-000-000-043
Built By Mid-States
Booked 6-26-87 From TCO-51A

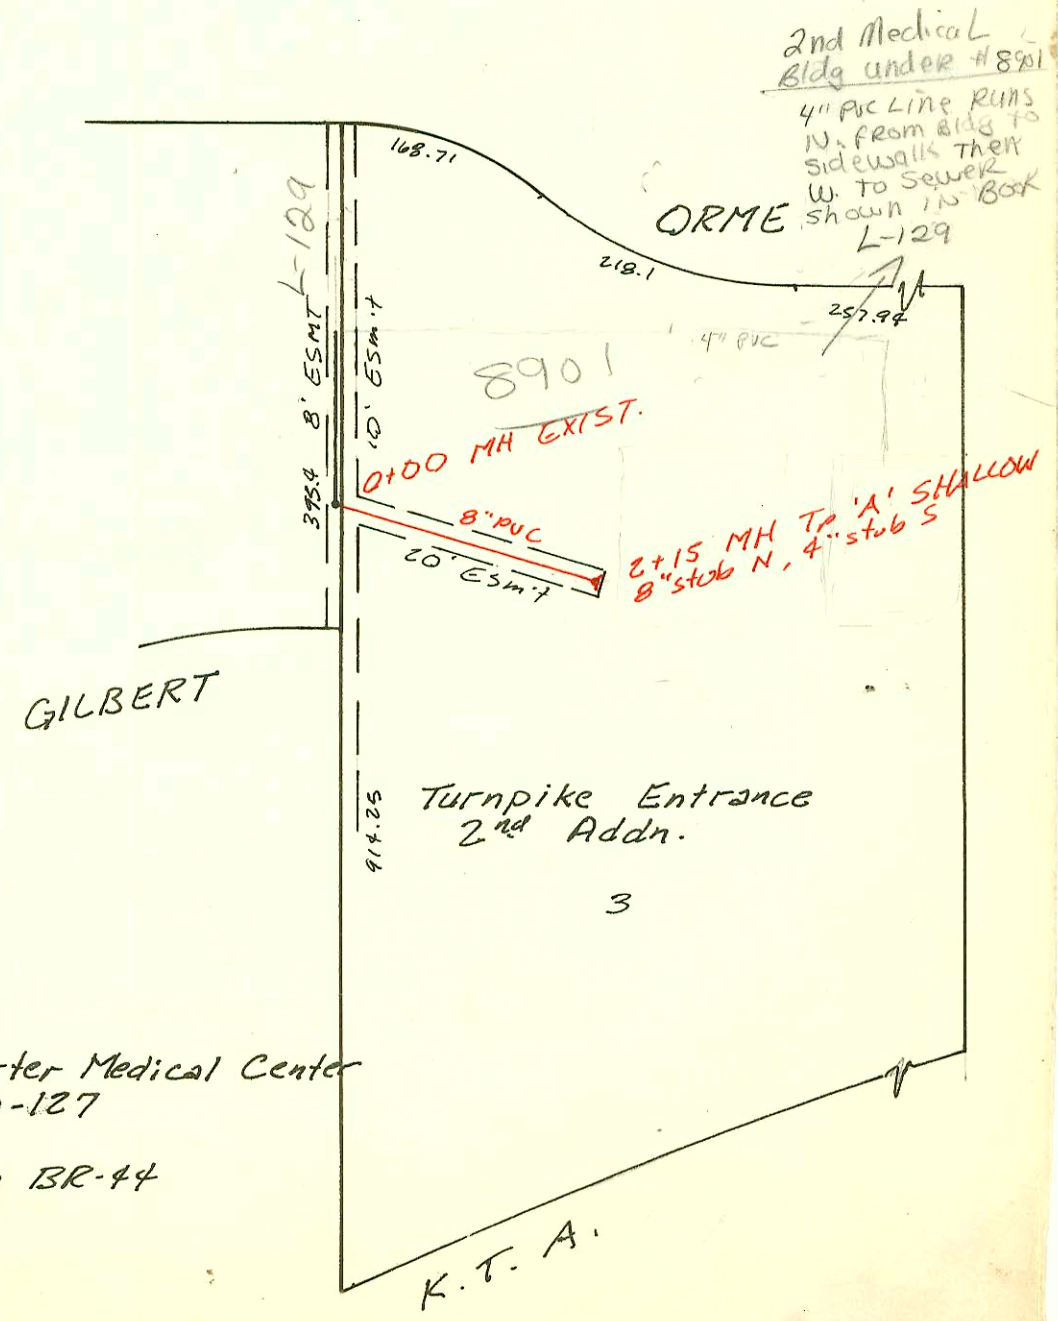

Priv. San. Sewer for Charter Medical Center
44B-76-245-80001-000-000-127
Built By L.A. Knebler
Booked 6-26-87 From BR-44

CONSTRUCTION RECORD						SERVICE RECORD						
STATION	ELEVATION		Depth	MANHOLE	4-INCH "Y" BRANCHES		No. of Permit		House Number		DATE OF PERMITS	
	Ground	Grade			North West	South East	North West	South East	North West	South East	North West	South East
LAT 19, SW	INTERCEPTOR											
0+00	154.95	141.90	13.1	EXIST. 0+00								
1+00	155.4	142.17	13.2			1+44.0 TAP	19582	18427	7784	7630	11/05/87	6-10-87
2+00	155.3	142.43	12.9			2+01.0 TAP		20384	7700	7710		4-1-88
3+00	155.6	142.70	12.9			2+99.0 TAP	21255	21164	7761	7710	8-4-88	7-27-88
	155.64	142.83	12.8	3+48.0		3+40.0 TAP		20289	7720	7720		12-27-88
4+00	155.9	142.96	12.9			3+60.6 TAP	20856		7771	7800	6-13-88	
						4+50.0 TAP	19822	23232	7801	7800	12/04/87	5-25-89
5+00	156.0	143.21	12.8			4+51.3 TAP	21926	23734	7811	7810	11/14/88	8-10-89
						5+17.7 TAP						
6+00	156.6	143.46	13.1			5+69.0 TAP	22394	23527	7652	7820	1-12-89	6-5-91
	157.23	143.70	13.5	6+94.0		8" stub SW						
LAT 25 SW	LINE 1											
0+00	121.25	109.07	12.2	EXIST. 0+00								
1+00	121.1	109.47	11.6			1+43 TAP			3708 S.	Gilda Cir		3-23-87
2+00	121.0	109.86	11.1									
						2+53.5 TAP		17985	3916 S.	Gilda Cir		3-23-87
3+00	121.5	110.26	11.2									
	121.88	110.38 OUT	11.5	3+30.5								
4+00	122.0	110.76	11.2			4+66.5 TAP		17937	3924 S.	Gilda Cir		3-13-87
5+00	122.4	111.16	11.2			5+20.5 TAP		17649	3942 S.	Gilda Cir		1-5-87
	122.74	111.22 OUT	11.5	5+15.5		5+88.5 TAP	17413	2474	3950 S.	Gilda Cir	5000 W	12-22-86
6+00	122.5	111.65	10.9			6+49.5 TAP		17412	3958 S.	Gilda Cir	39th	3-17-93
	122.68	111.95	10.7	6+68.5		4" stub SW		17717	3968 S.	Gilda Cir		12-8-86
LWE 2	0+00	122.74	111.30	11.4	5+50.5							
		122.57	111.53	11.0	0+32.5			17984	3982 S.	Gilda Cir		3-23-87
4" stub NW												
Priv. S.S.	FOR THE EPIC CENTER											
0+00	113.07	108.01	5.1	EXIST. 0+00								
1+00	112.2	108.31	3.9									
2+00	110.8	108.61	2.2									
3+00	111.8	108.91	2.9									
	112.00	109.04	3.0	3+45		8" stub N						
Priv. S.S.	FOR Charter Medical Center											
0+00	155.3	144.60	10.7	EXIST. 0+00								
1+00	154.0	147.11	6.9									
2+00	155.7	149.62	6.1									
	156.75	150.0	6.8	2+15.0		8" stub N	15882	15811	8401	8401	3-18-86	3-18-86
						4" stub S						
Line 10 (CONT)	4+00	170.40	162.60 OUT	7.8	3+43.4							
		170.7	162.79 IN	7.5								
						4+67.1 TAP	19620	20500	5214	5218	11-19-87	9-5-88
	5+00	172.0	164.04	8.0								
		173.09	164.67	8.4	5+78.1			18909	5219	5219		8-20-87
Line 11	0+00	177.20	163.08	14.1	0+00							
						1+03.0 TAP		21414	5211	5211		9-8-88
	1+00	176.0	164.30	11.7								
		177.12	165.14	12.0	1+71.0		20659		5215	5215		2-5-88
						4" stub NE						