


LAT 220 SW. INTERCEPTOR SEWER
 468-76-245-81560-000-000-001
 Built By Stannard Const. Co.
 Booked 12-30-86 From KW #18

Priv. S.S. for Manor Care, Inc.
 Nursing Center
 468-76-245-80001-000-000-085
 Built By Stannard Const.
 Booked 10-11-88 from Plan

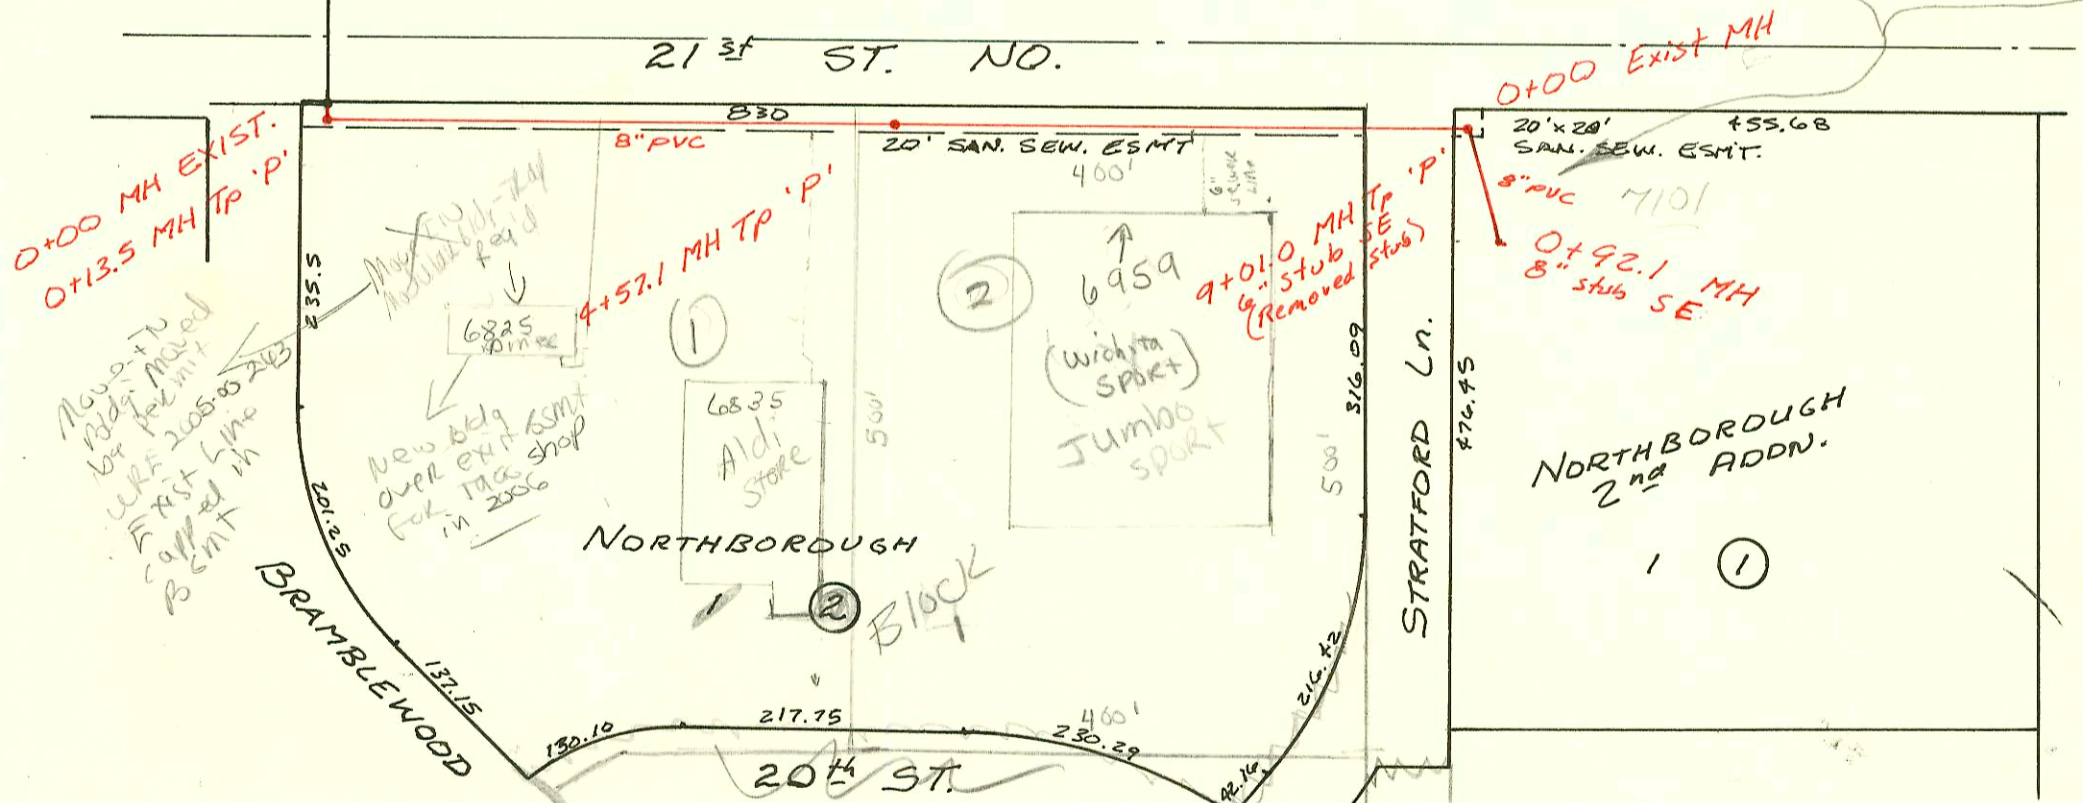

LAT 19. MAIN 20, WAR INDUSTRIES SEWER
 468-76-245-81598-000-000-001
 Built By Stannard Const.
 Booked 12-31-86 From AG-14A

12-37

12-87

CONSTRUCTION RECORD							SERVICE RECORD					
STATION	ELEVATION		Depth	MANHOLE	4-INCH "Y" BRANCHES		No. of Permit		House Number		DATE OF PERMITS	
	Ground	Grade			North West	South East	North West	South East	North West	South East	North West	South East
LAT 220, SW I												
LIN 1	2+98.8	154.6	144.17	10.4								
	3+00											
		155.63	144.33 OUT 144.48 IN	11.3	3+12.1							
	4+00	155.8	144.82	11.0	4+19.1 TAP							
		156.27	145.17 OUT 145.32 IN	11.1	4+90.0							
	5+00	156.2	145.36	10.8	5+34 TAP							
	6+00	156.4	145.75	10.7	6+23 TAP							
	7+00	156.2	146.14	10.1	7+33.8 TAP							
	8+00	156.2	146.53	9.7								
		156.35	146.63 OUT 146.70 IN	9.7	8+24.3							
		156.07	147.03 OUT 147.12 IN	9.9	8+61.3							
	9+00	155.7	147.27	8.4								
	10+00	155.0	147.65	7.4								
	10+39.5	155.7	147.80	7.9								
LIN 2	0+00	156.35	146.76	9.6	0+00 8+24.3 L-1							
	1+00	156.8	147.15	9.7								
	2+00	158.3	147.53	10.8								
		159.67	147.85 OUT 147.97 IN	11.8	2+82.5							
	3+00	159.3	148.04	11.3								
	4+00	160.0	148.43	11.6								
	5+00											
		162.46	148.84 OUT 149.03 IN	13.6	5+03.5							
		162.44	149.32	13.1	5+67.8							
LIN 3	0+00	159.67	147.99	11.7	0+00 2+82.5 L-2							
	1+00	158.0	148.38	9.6								
	2+00	157.0	148.77	8.2								
		157.09	148.80 OUT 148.95 IN	8.3	2+06.6							
		157.03	149.09	7.9	2+42.8							
LAT 19, MAIN 20, W I S												
	0+00	201.07	186.77	14.3	0+00 EXIST							
		201.42	187.02 187.104	14.4 10.4	0+13.5							
	1+00	203.3	191.44	11.9								
	2+00	204.5	191.91	12.6								
	3+00	205.5	192.37	13.1								
	4+00	206.5	192.83	13.7								
		207.15	193.10	14.1	4+57.1							
	5+00	207.8	193.31	14.5								
	6+00	208.9	193.80	15.1								
	7+00	210.0	194.29	15.7								
	8+00	210.3	194.78	15.5								
	9+00											
		210.65	195.27	15.4	9+01.0							
Priv. S. S. for MANOR CARE INC. Nursing Center.												
	0+00	210.6	195.06	15.5	0+00 EXIST							
		209.4	195.98	13.4	0+92.1							