
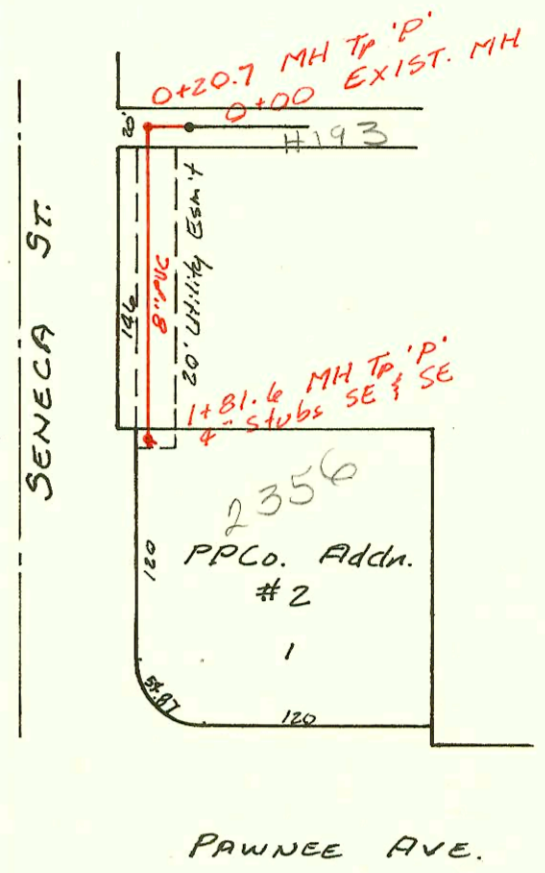


CENTRAL




LAT 223, SW INTERCEPTOR SEWER
468-76-245-81585-000-000-001
BUILT BY WILDCAT CONST.
BOOKED 1-6-87 From DRH-16

PLAT 450

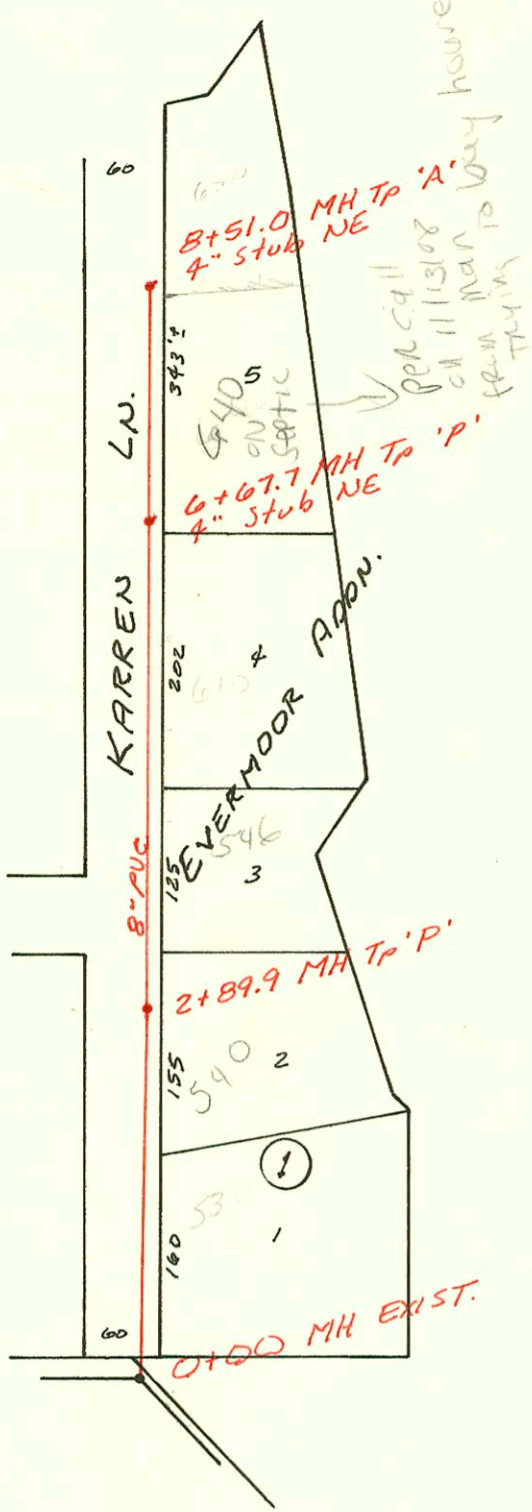

LAT 4B, MAIN 2, S.S. # 22
468-76-245-81587-000-000-001
Built By Triple "C"
Booked 1-16-87 From TCD-16

LAT B, MAIN 9, S.S. # 23
468-76-245-81336-000-000-001
Built By Triple 'C'
Booked 1-21-87 From AG-22

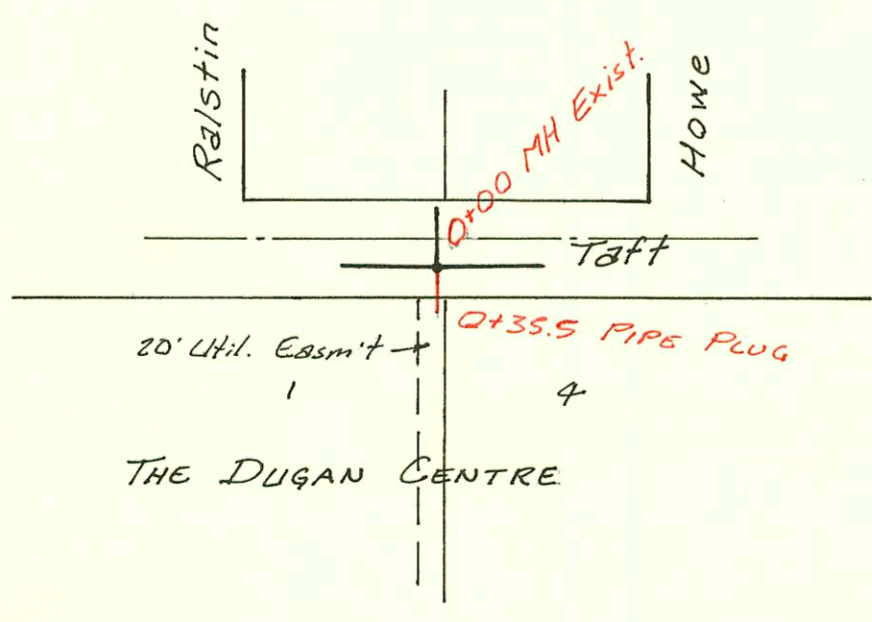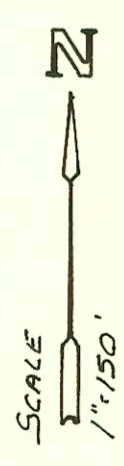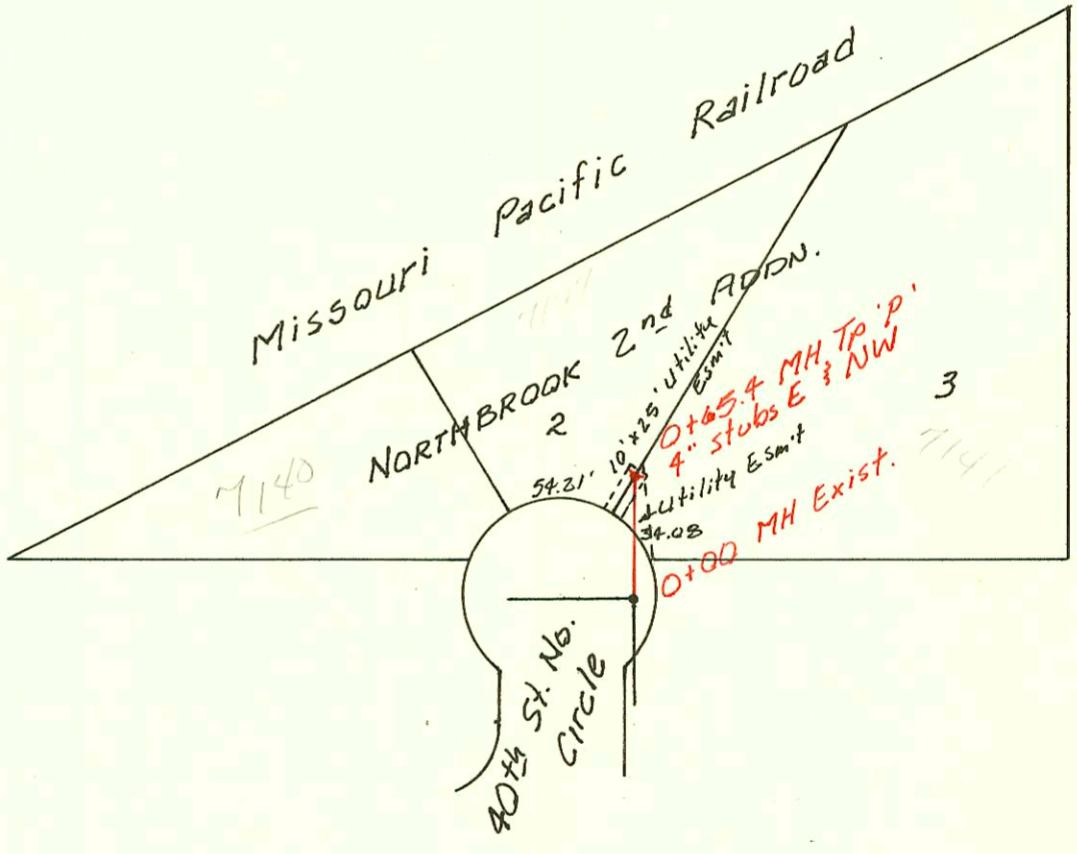

LAT 40, MAIN 4, SW INTERCEPTOR
468-76-245-81593-000-000-001
Built By STARR CONSTRUCTION
Booked 1-27-87 From TCD-28

9-5-87

CONSTRUCTION RECORD						SERVICE RECORD						
STATION	ELEVATION		Depth	MANHOLE	4-INCH "Y" BRANCHES		No. of Permit		House Number		DATE OF PERMITS	
	Ground	Grade			North West	South East	North West	South East	North West	South East	North West	South East
LAT 223, SWI												
0+00	137.29	129.49	7.8	0+00 EXIST								
1+00	137.9	129.89	8.0									
2+00	136.9	130.29	6.6									
	137.66	130.65	7.0	2+89.9								
3+00	137.4	130.69	6.7									
4+00	137.1	131.10	6.0									
5+00	137.5	131.51	6.0									
6+00	137.6	131.92	5.7									
	137.84	132.20	5.6	6+67.7								
7+00	137.6	132.35	5.3									
8+00	137.4	132.81	4.6									
	137.46	133.05	4.4	8+51.0								
LAT 48, MAIN 2, SS #22												
0+00	103.46	95.83	7.5	0+00 EXIST.								
	103.44	95.98 OUT	7.5	0+20.7								
1+00	103.6	96.43	7.2									
	103.91	96.79	7.1	1+81.6								
LAT 8, MAIN 9, S.S. #23												
0+00	182.85	173.46	9.4	EXIST. 0+00								
	183.58	173.75	9.8	0+65.4								
LAT 40, MAIN 4, SW INTERCEPTOR												
0+00	129.56	115.96	13.6	0+00 EXIST.								
0+35.5	129.4	116.03	13.4									