


CITY MAIN EXT
TO SERVE
LOTS 1, 2
NOT REL AS
OF 6/26/60



LAT 221, SW INTERCEPTOR
468-76-245-81577-000-001
Built By MID-STATES CONST.
Booked 2-3-87 From BR-119

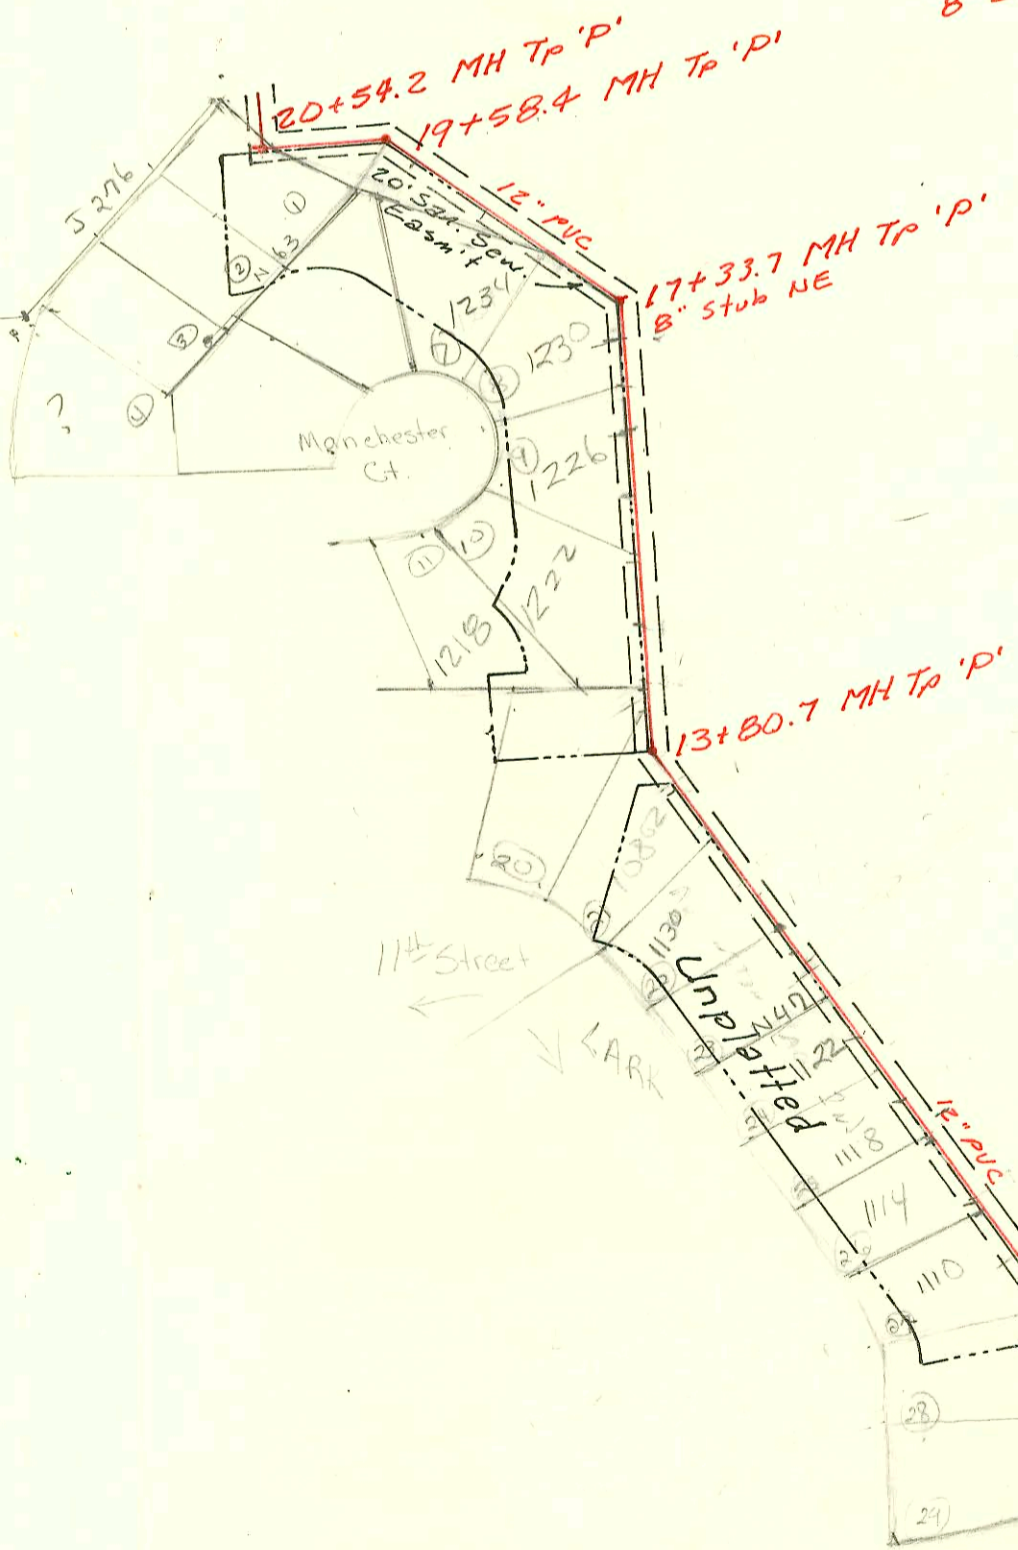

NO SPECIAL
Fee Req
11/23/31

0+00 MH EXIST.

LAT 22

CONSTRUCTION RECORD						SERVICE RECORD						
STATION	ELEVATION		Depth	MANHOLE	4-INCH "Y" BRANCHES		No. of Permit		House Number		DATE OF PERMITS	
	Ground	Grade			North West	South East	North West	South East	North West	South East	North West	South East
0+00	149.09	134.34	14.8	EXIST. 0+00								
1+00	151.8	134.67	17.1	0+90.4								
2+00	150.0	135.05	15.0	1+96.6								
3+00	151.0	135.33	15.7									
4+00	150.5	135.62	14.9									
5+00	150.7	135.98	14.7	4+95.6								
6+00	151.2	136.15	15.1									
7+00	152.0	136.33	15.7									
8+00	152.9	136.50	16.4									
9+00	153.3	136.80	16.5	8+51.1								
10+00	153.3	136.93	16.4									
11+00	152.9	137.05	15.9									
12+00	152.6	137.18	15.4									
13+00	153.0	137.31	15.7									
14+00	153.0	137.43	15.6	13+80.7								
15+00	153.4	137.52	15.9									
16+00	153.6	137.62	16.0									
17+00	153.8	137.71	16.1	17+33.7								
18+00	153.9	137.95	16.0									
19+00	154.0	138.05	16.0									
20+00	153.7	138.18	15.5	20+54.2								
21+00	153.9	138.35	15.6									
22+00	153.8	138.47	15.3									
23+00	154.2	138.58	15.6									
24+00	154.0	138.83	15.2	23+49.6								
25+00	154.1	138.92	15.2									
26+00	154.2	139.11	15.1									
27+00	154.2	139.29	15.0	27+80.9								
28+00	154.4	139.37	15.0									
29+00	154.5	139.46	15.0									
30+00	155.0	139.63	15.4	30+16.7								
31+00	155.4	139.82	15.6									
32+00	156.5	140.02	16.5									
33+00	156.9	140.21	16.7									
	156.62	140.24	16.4	33+14.0								

93-373-7 12-30-92 1114 N LARK