


LAT 18, MAIN 12, SW INTERCEPTOR
468-76-245-81550-000-000-001
BUILT BY STANNARD CONST.
BOOKED 3-10-87 FROM DCD-169

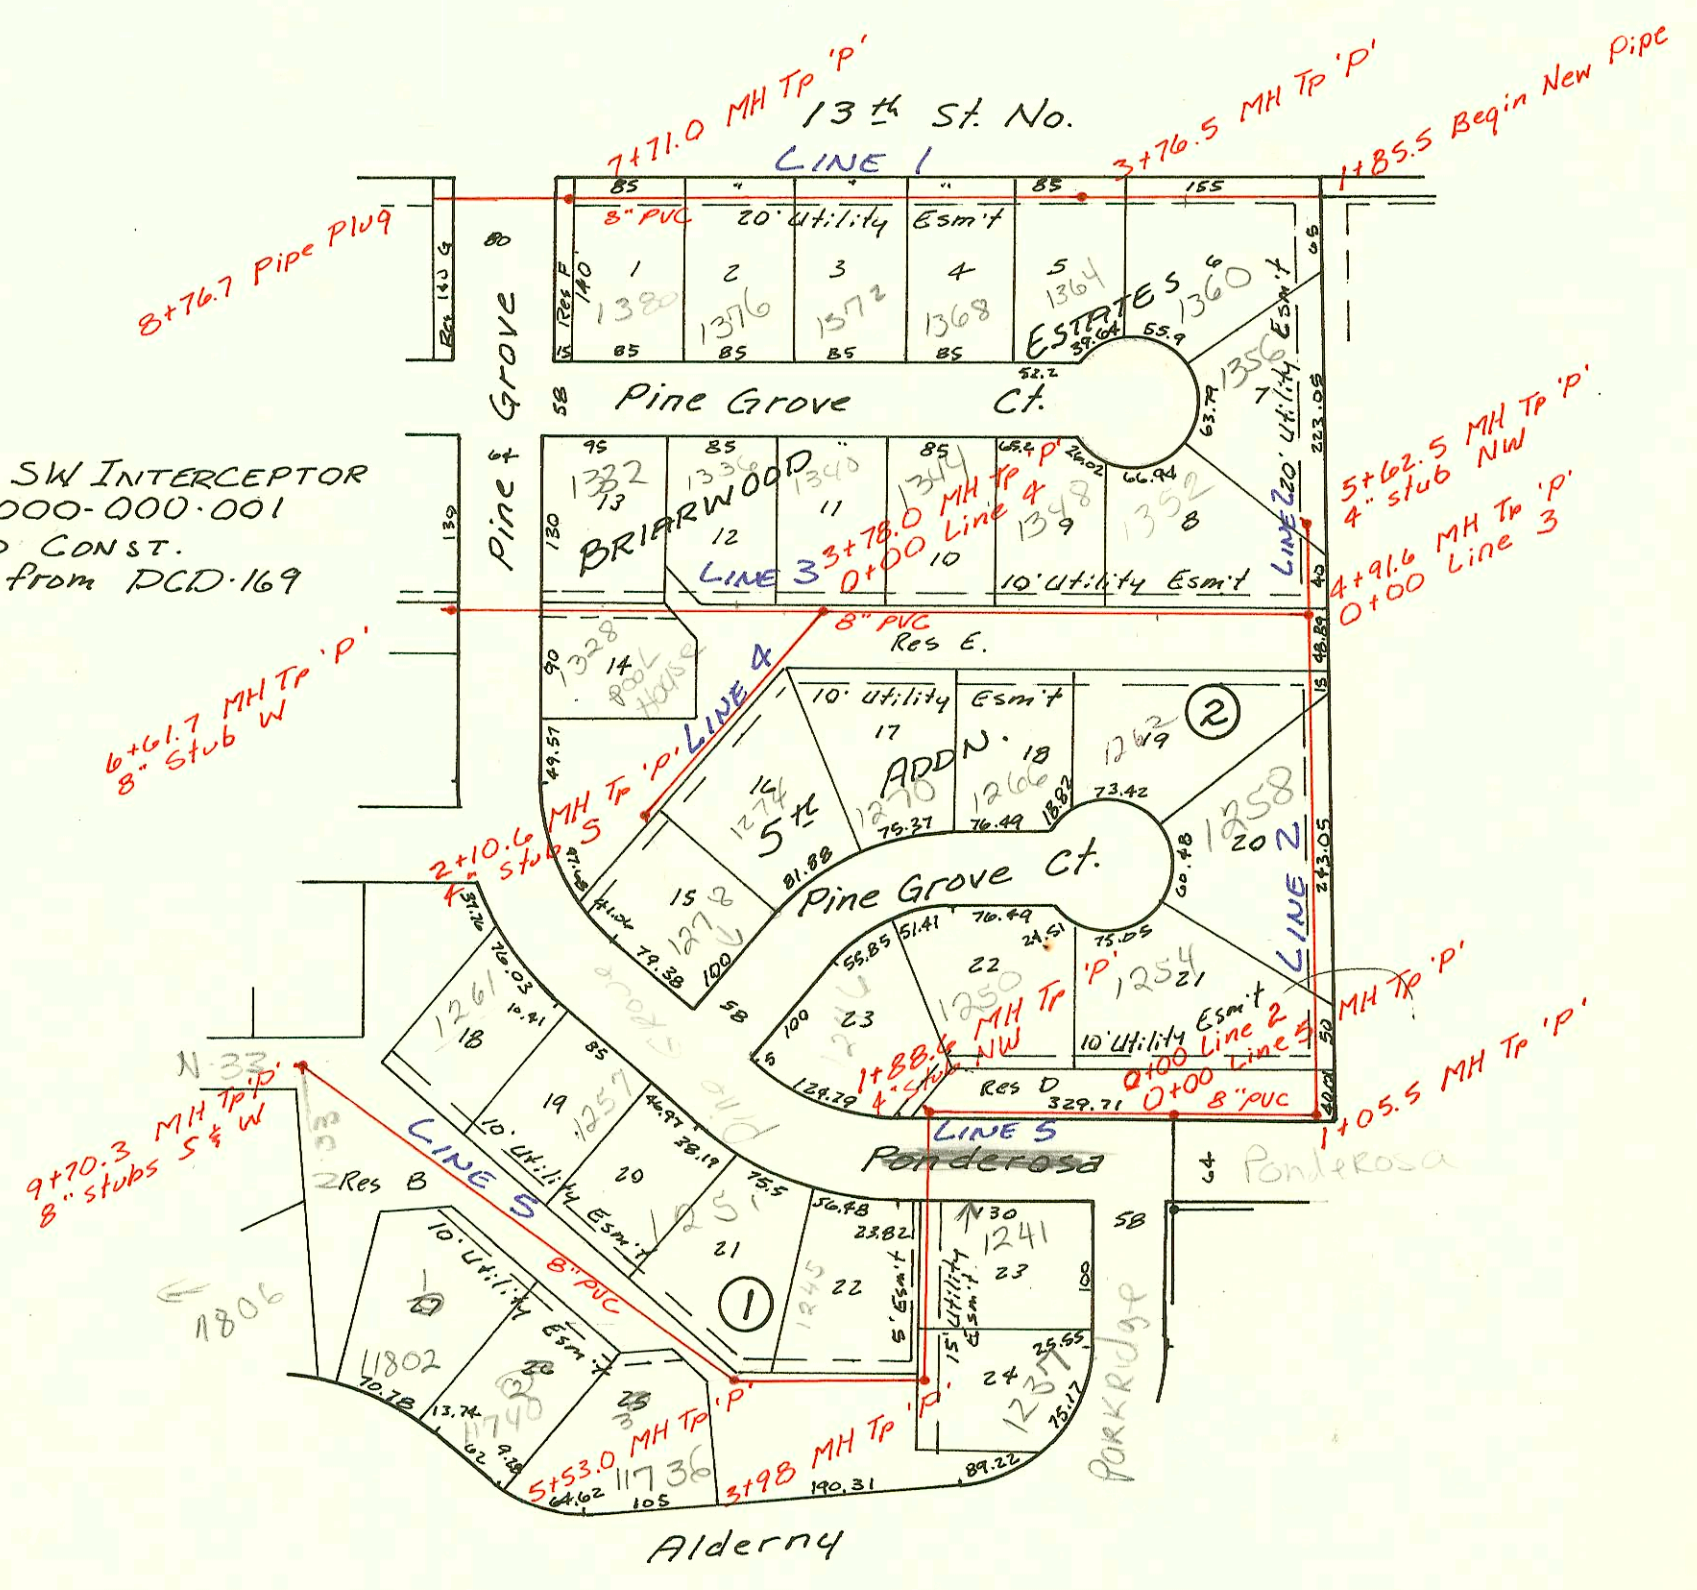

CONSTRUCTION RECORD							SERVICE RECORD					
STATION	ELEVATION		Depth	MANHOLE	4-INCH "Y" BRANCHES		No. of Permit		House Number		DATE OF PERMITS	
	Ground	Grade			North West	South East	North West	South East	North West	South East	North West	South East
LAT 18, LINE 1												
MAIN 12, SW I												
1+85.5	156.6	142.60	14.0									
2+00	156.7	142.69	14.0									
3+00	157.7	143.32	14.4			2+94.5 TAP		25922		1360	Pine Grove Ct	8-8-90
	158.84	147.80 OUT 145.80 IN	15.0 13.0	3+76.5								
4+00	158.5	145.86	12.6			4" PVC 40 4+01.5 TAP		91-20273-7		1304	Pine Grove Ct	4-11-91
5+00	159.2	146.13	13.1			4" SDR 35 4+49.5 TAP 4" PVC 40 5+35.0 N/C		22239-7 94-299-7		1368 1372 N	Pine Grove Ct Pine Grove Ct	5-16-91 1-7-94
6+00	159.4	146.39	13.0			6+22.0 TAP		20086		1376	Pine Grove Ct	2-16-88
7+00	159.9	146.66	13.2			4" SDR 35 6+97.4 N/C		91-7829-7		1380	Pine Grove Ct	5-20-94
	160.05	146.85	13.2	7+71.0								
8+00	160.0	146.93	13.1									
8+76.7	159.3	147.13	12.2									
LINE 2												
0+00	149.63	138.43	11.2	0+00 L-5 0+00								
1+00												
	147.73	138.83	8.9	1+05.5		1+56.0 TAP		23607		1254	Pine Grove Ct	8-2-89
2+00	148.5	139.15	9.4									
3+00	149.9	139.49	10.4			3+22.6 TAP		22859		1258	Pine Grove Ct	4-5-87
4+00	153.0	139.84	13.2									
	155.65	140.15 OUT 148.15 IN	15.5 7.5	0+00 L-3 4+91.6								
5+00												
	156.90	148.60	8.3	5+62.5		4" stub NW		18751		1356 N	Pine Grove Ct	7-22-87
LINE 3												
0+00	155.65	140.15	15.5	0+00 L-2 0+00								
1+00	154.8	140.50	14.3									
						1+18.0 TAP		18968	25738	1350 N 1348	Pine Grove Ct Pine Grove Ct	8/2/87 4-13-88
2+00	154.3	140.84	13.5			2+33.0 TAP		20464	19417	1366 N	Pine Grove Ct	10-26-87
3+00	153.8	141.19	12.6					19414		1370	Pine Grove Ct	10/26/87
	153.96	141.46	12.5	3+78.0		3+66.7 TAP		20444		1344	Pine Grove Ct	4-12-88
4+00	153.5	141.53	12.0			4+08 TAP 4+58 TAP		18172 18171		1340 1336	Pine Grove Ct Pine Grove Ct	4-21-87 4-21-87
5+00	154.4	141.86	12.5									
						4" SDR 35 5+61.7 TAP		91-36200	20706	1352 1328	Pine Grove Ct Pine Grove Ct	10-25-91 5-31-88
6+00	153.3	142.20	11.1									
	154.05	142.40	11.7	6+61.7		8" stub W						
LINE 4												
0+00	153.96	141.46	12.5	0+00 L-3 0+00								
1+00	152.3	141.81	10.5									
						0+67.6 TAP		19416		1210	Pine Grove Ct	10/26/87
2+00						1+36.6 TAP		26117		1214	Pine Grove Ct	9-12-90
LINE 5												
0+00	151.50	142.20	9.3	2+10.6 0+00 L-2 0+00								
	149.63	138.43	11.2			4" stub S		91-33549		1278	Pine Grove Ct	9-25-91
1+00	149.0	138.80	10.2									
	149.33	139.13	10.2	1+88.6		4" stub NW		18302		1250 1246	Pine Grove Ct Pine Grove Ct	5-11-87 2-16-88
2+00	149.0	139.18	9.8					20087	91-1491-7			1-31-92
3+00	149.6	139.58	10.0									
	150.15	139.97	10.2	3+98.0				92-23856-7		1257	Pine Grove Ct	8-20-92
4+00						4" PVC 40 4+75.2 TAP		92337-7		1245	Pine Grove Ct	6-3-91
5+00	150.3	140.21	10.1									
	150.79	140.34	10.5	5+53.0								
6+00	150.7	140.49	10.2									
						4" SDR 35 6+93.0 TAP		127661-7	92-12457	1251	Pine Grove Ct	5-21-92
7+00	151.2	140.81	10.4			4" PVC 40 6+76.0 TAP		93-22478-7		11740 W Aldermy		7-10-92 8-3-93
						7+75.3 TAP		24569	96-6379-7	1257	Pine Grove Ct	1-8-90
8+00	151.7	141.13	10.6							11802	Aldermy	4-19-96
						4" PVC 40 8+99.3		26979-7		1261	Pine Grove Ct	7-12-91
9+00	152.2	141.45	10.8									
	152.95	141.67	11.3	9+70.3		8" stub W 8" stub S						