
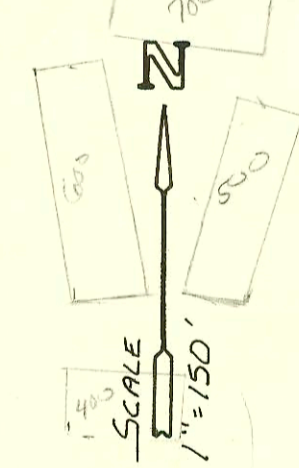


1=150

Priv. Sanitary Sewer for Willowbend 3rd Addn.
448-76-245-80901-000-000-131
Built By Stannard Const. Co.
Booked 6-87 From As Built Plans

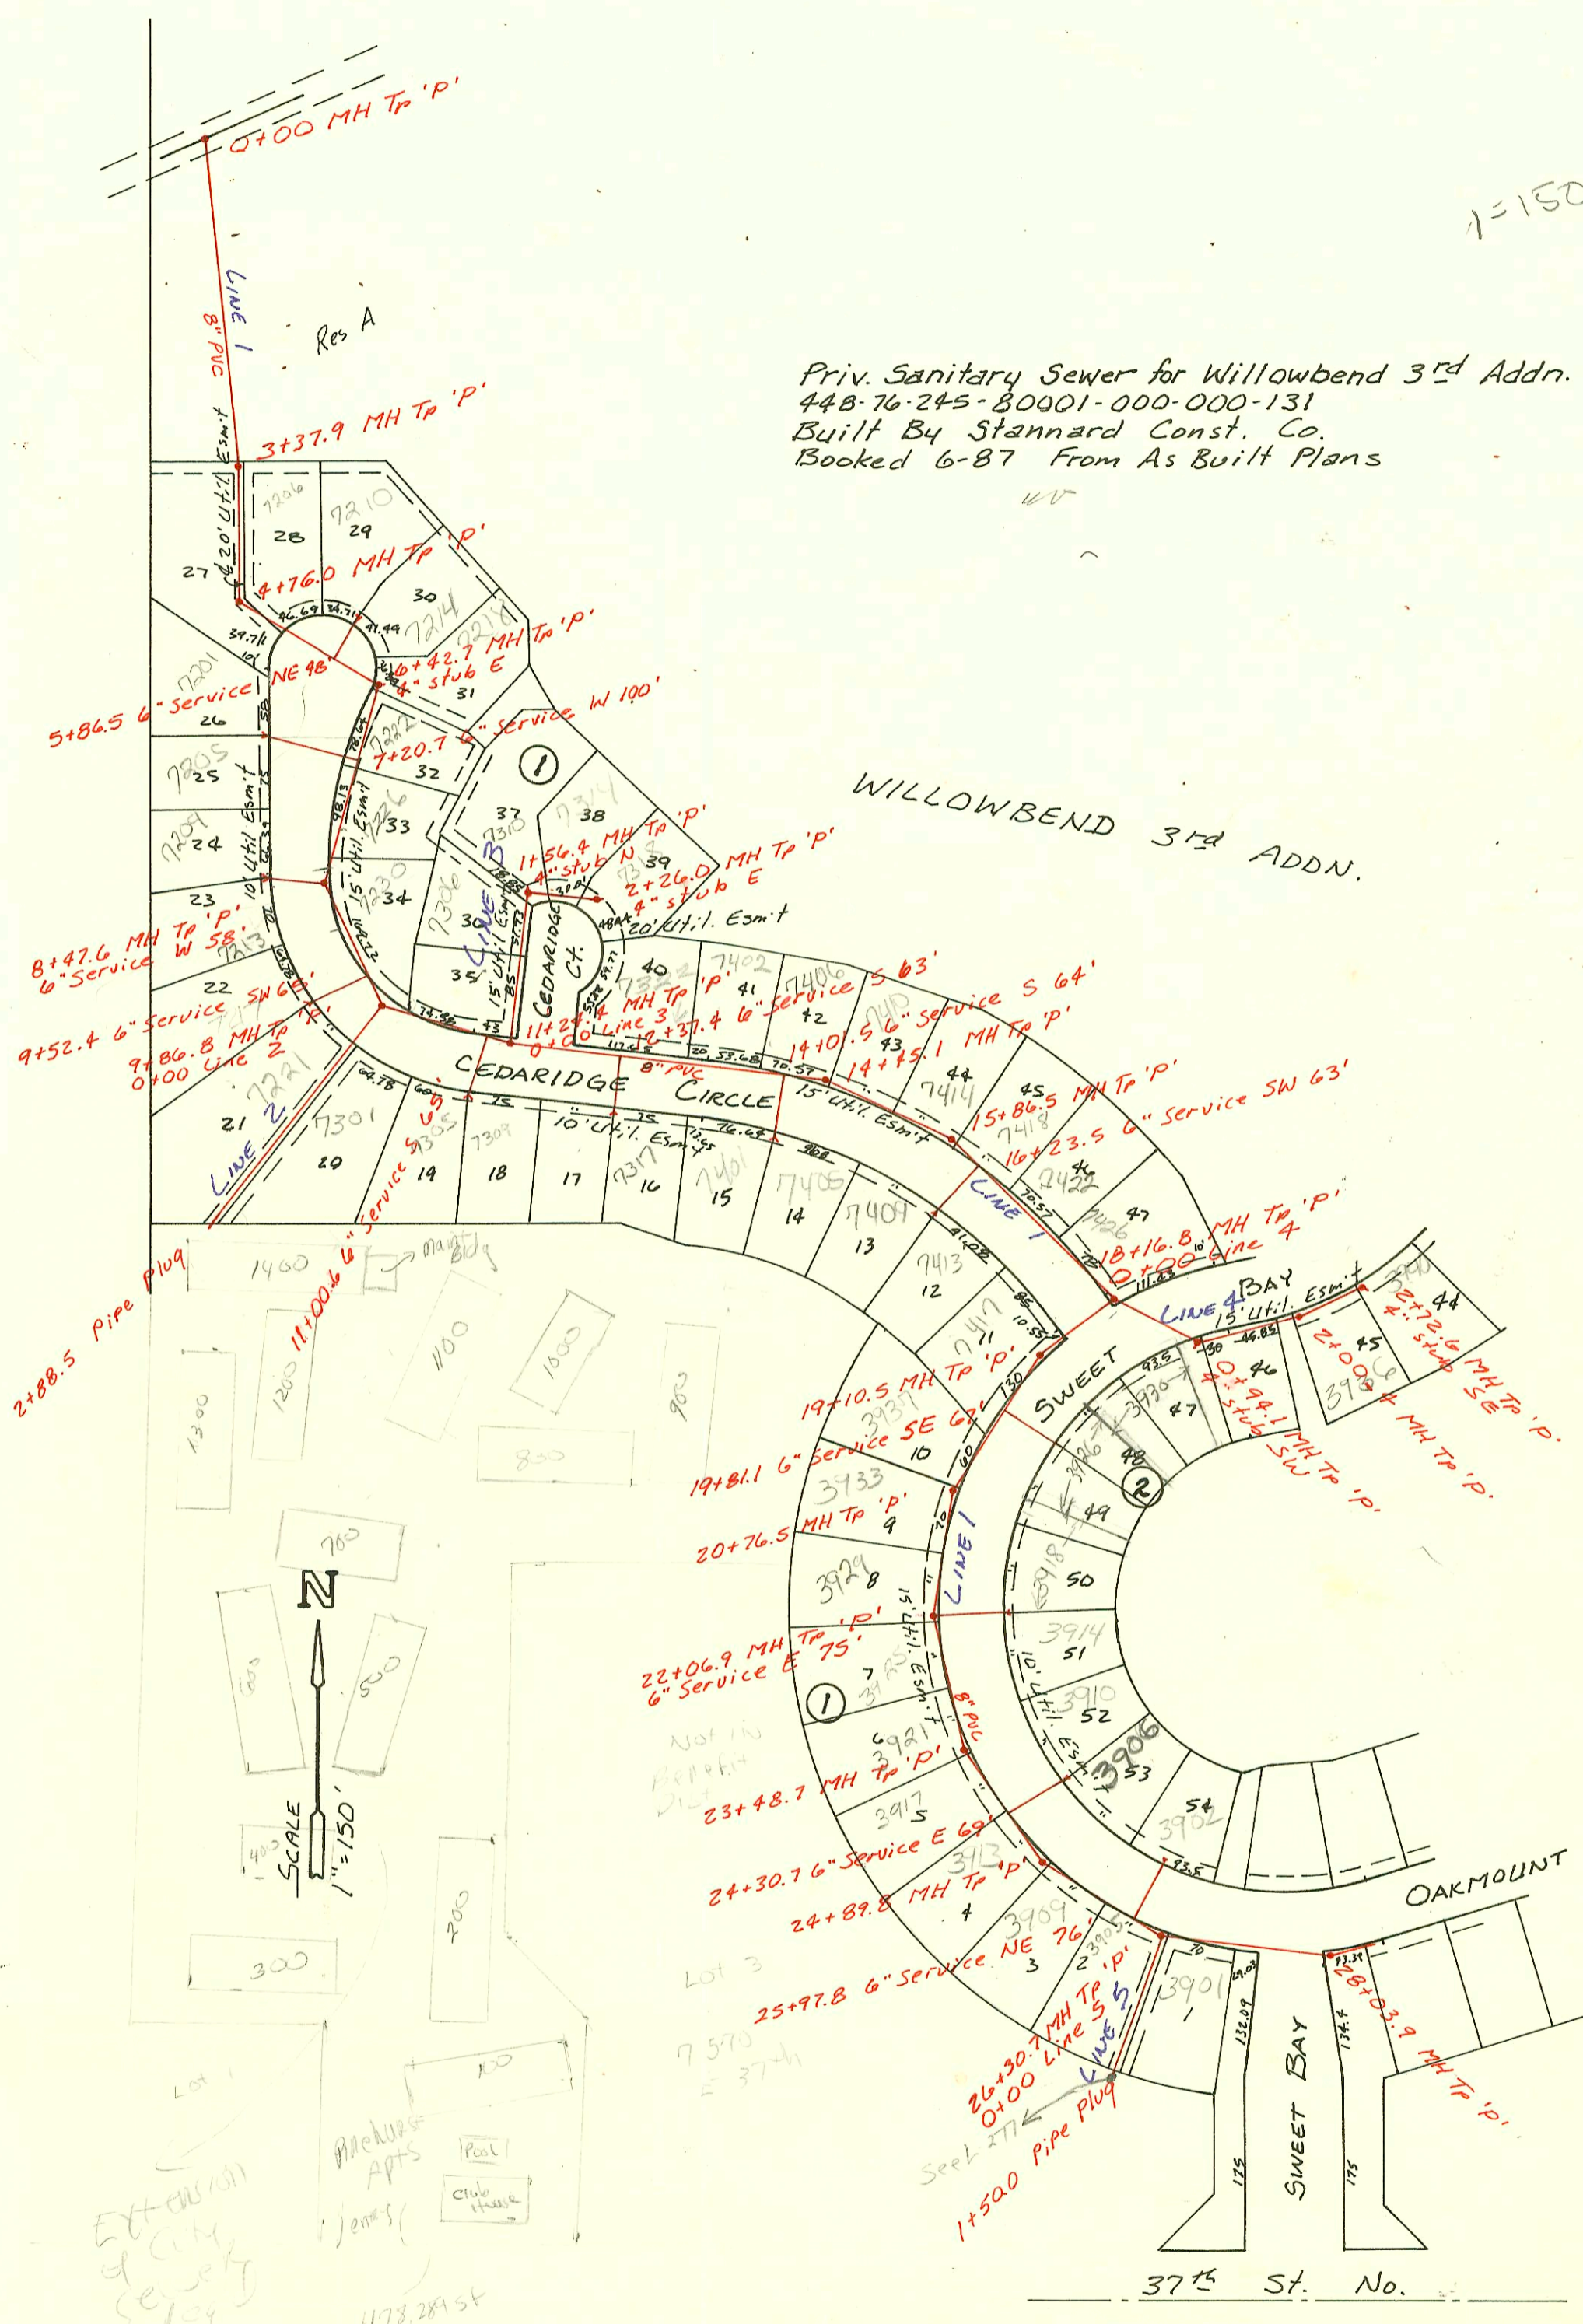

EXTENSION
of CITY
SEWER
FOR
BL

BRANCH
APTS
Pool
Club
House

473,289 SF

37th St. No.

J 282A

Priv. Sewer
Line 1

CONSTRUCTION RECORD						SERVICE RECORD						
STATION	ELEVATION		Depth	MANHOLE	4-INCH "Y" BRANCHES		No. of Permit		House Number		DATE OF PERMITS	
	Ground	Grade			North West	South East	North West	South East	North West	South East	North West	South East
0+00	174.07	167.27	6.8	EXIST 0+00								
1+00	176.8	167.93	8.9									
2+00	177.0	168.59	8.4									
3+00	177.5	169.25	8.3									
4+00	177.65 179.0 180.39	169.50 OUT 169.69 IN 170.16 170.73 OUT 170.77 IN	8.2 8.8 9.7	3+37.9 4+76.0		4" SCH 40 4+06.9 TOP	91-19932-7		1720 Cedaridge		9-28-91	
5+00	181.3	170.86	10.4									
5+86.5				5+86.5	6" Service NE 4" SCH 40 top 181.5 Flo 172.08		92-28752-7 93-22347-7		7210 Cedaridge	7214 E Cedaridge	9-11-92	8/16/93
6+00	181.7 182.67	171.22 171.37 OUT 171.45 IN	10.5 11.3	6+42.7		4" SCH 40 7+08.17	91-29307-7 2500 21154		7218 Cedaridge	7222 E Cedaridge	8-5-91	
7+00	182.9	171.72	11.2									
7+20.7					6" Service W 4" SCH 40 top 182.3 Flo 173.37		94-6134-7 24754		7201 F Cedaridge	7205 Cedaridge	4-21-94	1-31-90
8+00	183.5 185.18	172.18 172.40 OUT 172.58 IN	11.3 12.8	8+47.6	6" Service W 4" SCH 40 top 183.3 Flo 173.93	4" SCH 40 7+90.6	95-14191-7 92-18937 93-23050-7		7204 Cedaridge	7215 Cedaridge	2-9-98	9-22-93
9+00	184.5	172.89	11.6			8+54.2 TAP	18545		7216 Cedaridge	7215 Cedaridge		6-22-87
9+52.4					6" Service SW 4" SCH 40 top 185.1 Flo 174.27		97- 93-31345-7		7217 Cedaridge	7221 Cedaridge	5-28-97	12-22-93
10+00	185.7	173.55	12.2	9+86.8 0+00 6-2								
11+00	185.6	173.81	11.8									
11+00.6					6" Service S 4" SCH 40 top 185.9 Flo 175.10		97-6305-7 95-4140-7		7315 Cedaridge	7309 E Cedaridge	5-22-97	3-22-95
12+00	185.64	173.88 OUT 174.08 IN	11.8	0+00 L-3 11+24.4								
12+00	185.2	174.48	10.7			12+62.4 TAP	20637		7302 Cedaridge		2-19-88	
12+37.4					6" Service S 4" SCH 40 top 185.2 Flo 175.73		95-51407		7311 Cedaridge			4-10-95
13+00	185.0	175.01	10.0									
14+00	186.0	175.54	10.5									
14+01.5					6" Service S 4" SCH 40 top 186.1 Flo 176.61		93-7187-7 94-16013-7 94-16287-7		7402 Cedaridge	7405 E OR Cedaridge	4-5-93	9-30-94
14+01.5	186.68	175.78 OUT 175.79 IN	10.9	14+45.1		14+50.1 TAP	20531		7406 Cedaridge		4-21-88	10-5-94
15+00	187.5	176.02	11.5				95-7046-7		7410 Cedaridge		5-10-95	
15+00	189.03	176.38 OUT 176.64 IN	12.7	15+86.5			76-8944-7		7414 Cedaridge		5-31-96	
16+00	188.9	176.68	12.2				93-2942-7		7418 Cedaridge		11-11-93	
16+23.5					6" Service SW 4" SCH 40 top 189.1 Flo 177.71		95-1726-7 97-1370-7		7409 Cedaridge	7413 Cedaridge	2-7-95	8/3/97
17+00	189.8	176.98	12.8				98-1579-7 19880		7422 Cedaridge		8-17-98	
17+00						17+60.8			7426 Cedaridge		8-7-87	
18+00	190.5	177.24	13.2									
18+00	191.24	177.34 OUT 177.54 IN	13.9	0+00 L-4 18+16.8								
19+00	191.1	178.12	13.0									
19+00	191.59	178.19 OUT 178.27 IN	13.4	19+10.5								
19+81.1					6" Service SE 4" SCH 40 top 182.0 Flo 179.64		76-1352-7 97-80604		7414 E Cedaridge	3726 Sweet Bay	4-26-96	9-3-99
20+00	191.8	178.72	13.1				20618		3937 Sweet Bay		5-4-88	
20+00	193.42	179.10 OUT 179.14 IN	14.3	20+76.5								
21+00	192.5	179.26	13.2				78-2144-7		3433 Sweet Bay		2-10-98	
22+00	193.2	179.76	13.4				96-1354-7		3729 Sweet Bay		8-14-96	
22+00	194.10	179.78 OUT 180.18 IN	14.3	22+06.9	6" Service E 4" SCH 40 top 193.6 Flo 180.61		97-2257-7 20491 76-1478-7		3718 Sweet Bay	3717 Sweet Bay	2-8-94	4-18-88
23+00	193.8	180.31	13.5				76-1478-7 23470		3925 Sweet Bay		8-14-96	
23+00	194.24	180.38 OUT 180.48 IN	13.9	23+48.7		23+41.7 TAP			3721 Sweet Bay		7-5-89	
24+00	193.5	180.73	12.8				2000 20405		3717 Sweet Bay		11-2-00	
24+30.7					6" Service E 4" SCH 40 top 193.8 Flo 181.92		18874 01947		3910 Sweet Bay	3906 Sweet Bay	9-22-87	8-31-00
24+00	193.98	181.18 OUT 181.22 IN	12.8	24+89.8			97-295-7		3913 Sweet Bay		1-8-97	
25+00	193.0	181.25	11.8				25-038 TAP 23469		3707 Sweet Bay		23-6-9	
25+97.8					6" Service NE 4" SCH 40 top 192.9 Flo 182.83		75-693-7		3702 Sweet Bay		5-10-95	
26+00	192.5	181.55	11.0				74-1578-7		3705 Sweet Bay		9-29-94	
26+00	192.59	181.64 OUT 181.83 IN	11.0	0+00 L-5 26+30.7			72-1984-7		3701 Sweet Bay		8-7-92	
27+00	192.0	182.20	9.8									
28+00	192.5	182.73	9.8									
28+00	192.73	182.75 OUT 182.93 IN	10.0	28+03.9								