


Homeowner of 4201 Spyglass wanted to buy Revere cannot build a garage because of reverse of 8" lat phal per C. P. R. 4/16/67

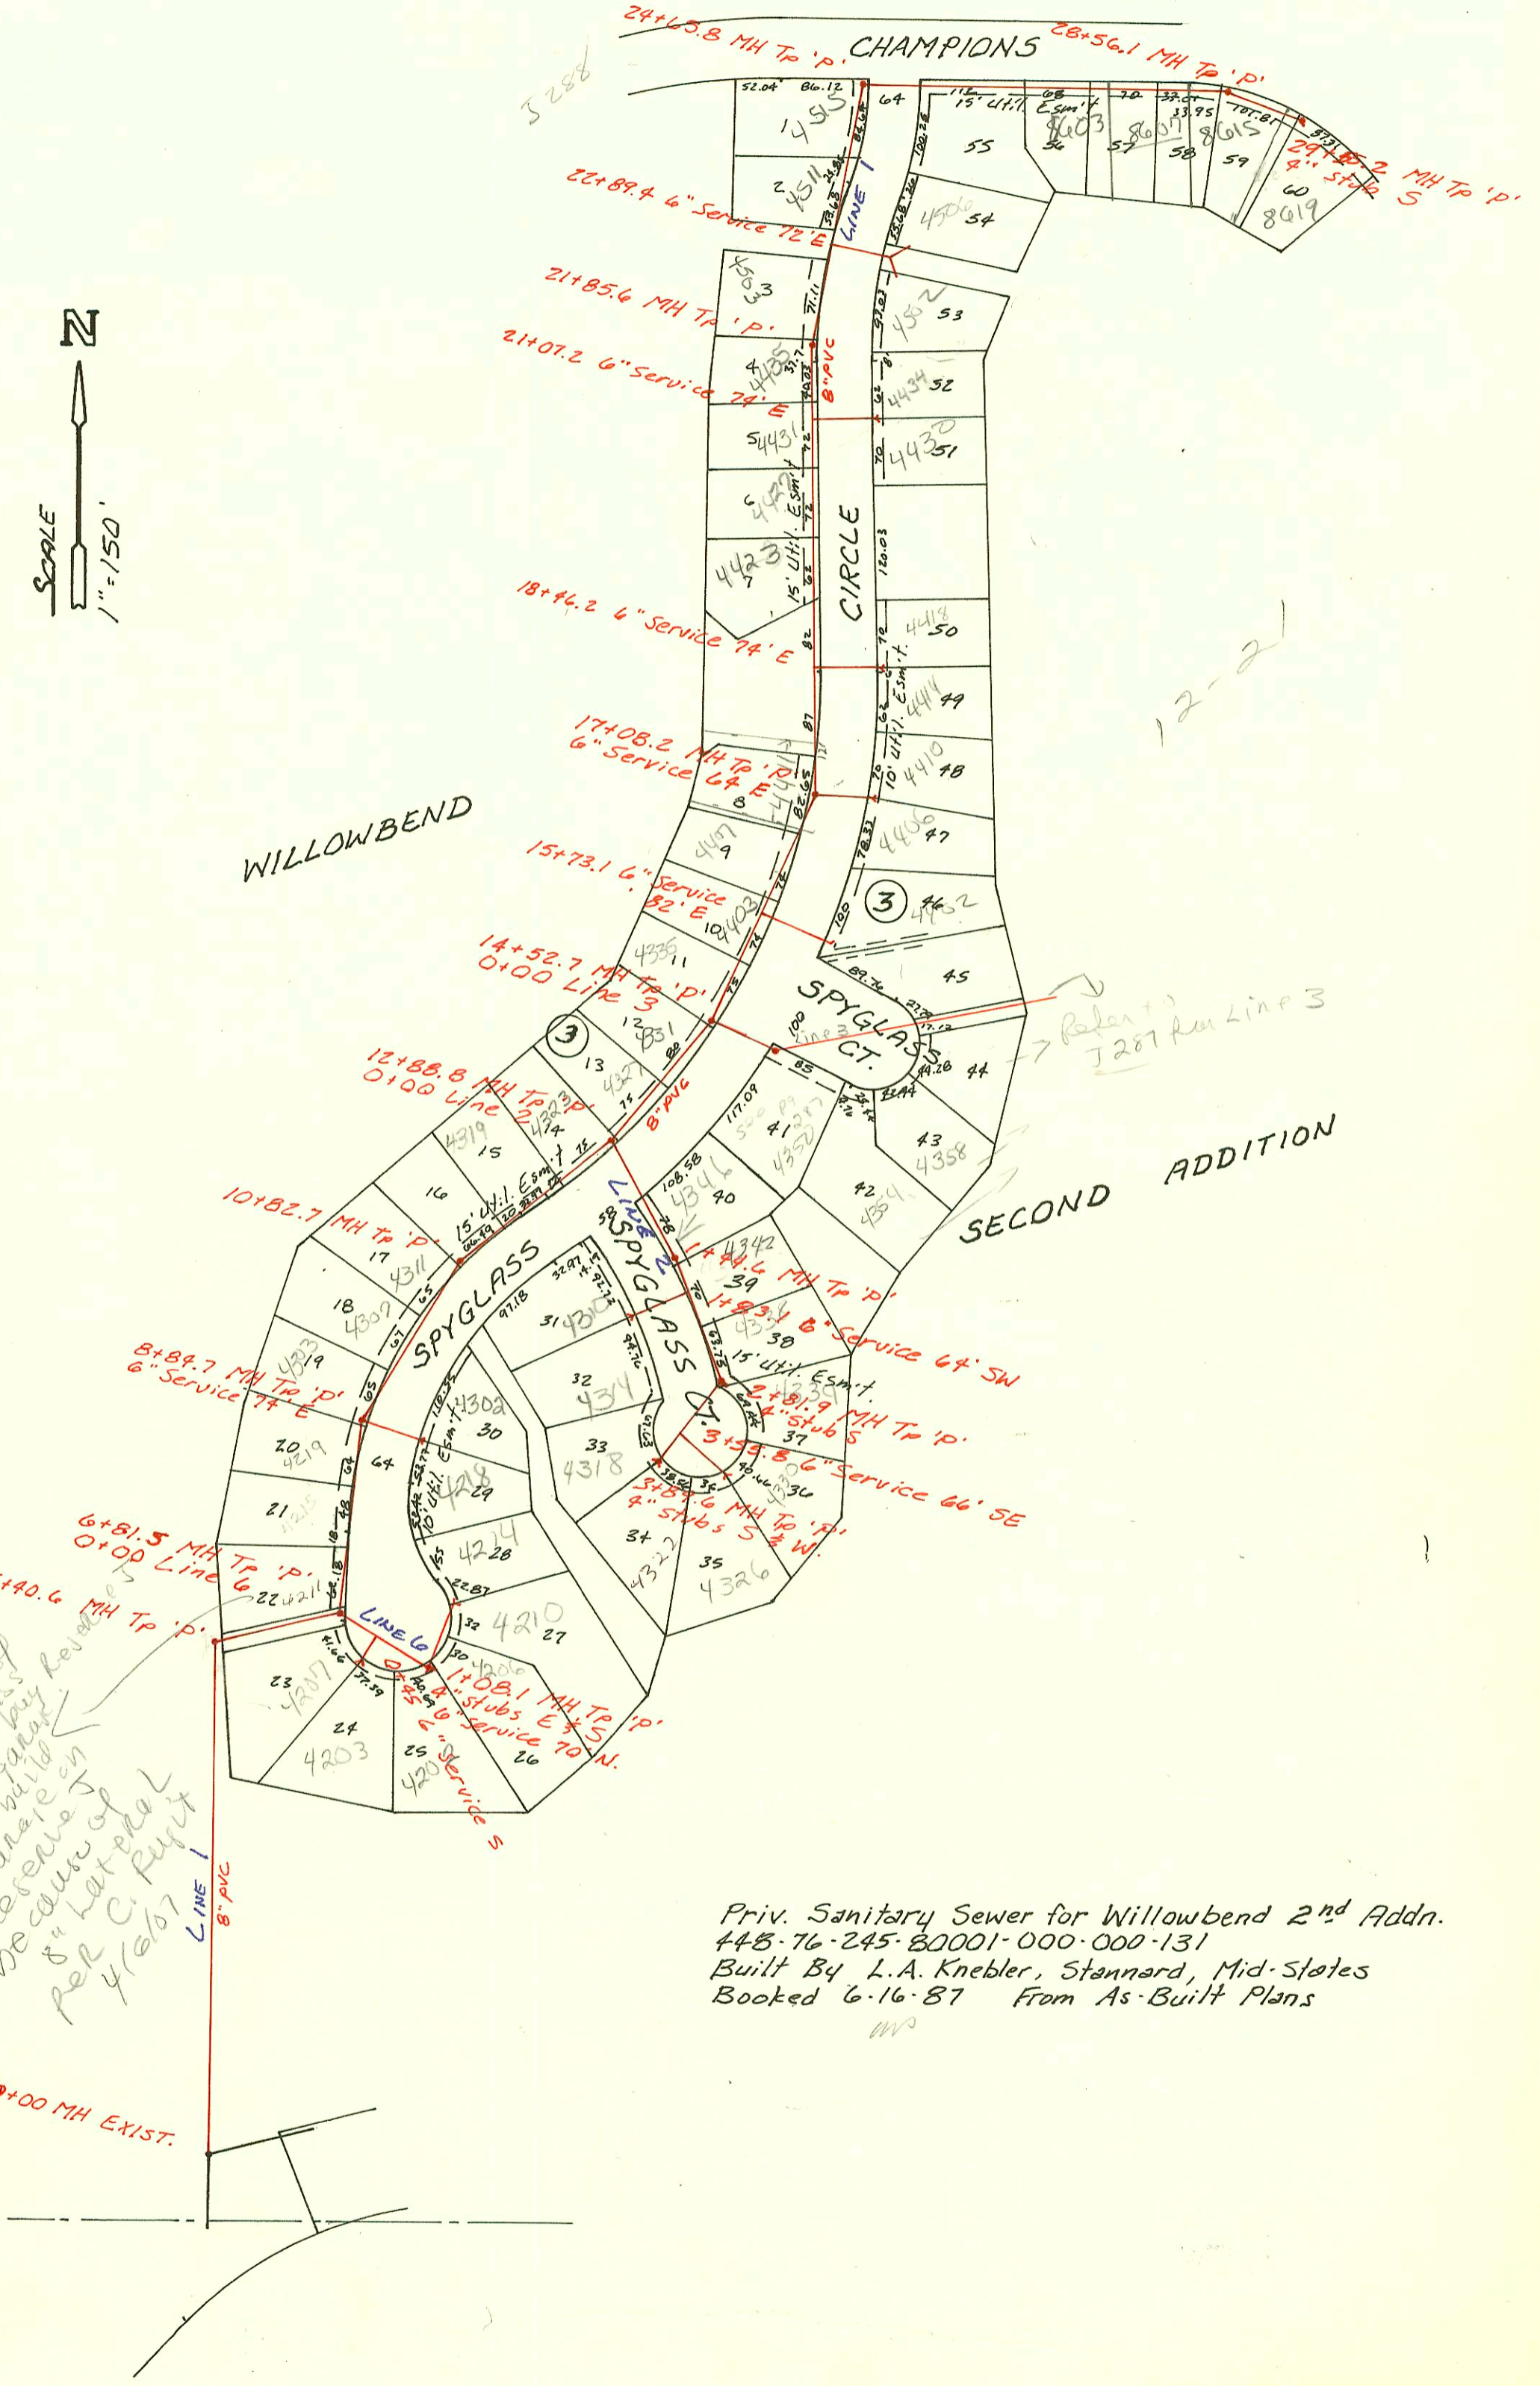

Priv. Sanitary Sewer for Willowbend 2nd Addn.
 448-76-245-80001-000-000-131
 Built By L.A. Knebler, Stannard, Mid-States
 Booked 6-16-87 From As-Built Plans
 MW

CONSTRUCTION RECORD

SERVICE RECORD

Priv. Sewer
LINE 1

STATION	ELEVATION		Depth	MANHOLE	4-INCH "Y" BRANCHES		No. of Permit		House Number		DATE OF PERMITS	
	Ground	Grade			North West	South East	North West	South East	North West	South East	North West	South East
0+00	192.10	178.97	13.1	EXIST. 0+00								
1+00	190.6	179.38	11.2									
2+00	188.4	179.78	8.6									
3+00	189.8	180.19	9.6									
4+00	190.3	180.59	9.7									
5+00	192.5	181.00	11.5									
	194.56	181.26 IN	13.4	5+40.6	4" S.C. 40 P.V.C. 5+76.6 N/C		94-5890-7		4207 N. Spyness		4-21-94	
6+00	193.9	181.53	12.4									
	193.91	181.91	12.0	6+81.3 0+00 L-6								
7+00	194.0	181.98	12.0		7+25.5 TAP 4" SCH 40 PVC 7+74.5 TAP		20164 94-24750-7		4211 SPYGLASS 4215 SPYGLASS		2-23-88 9-16-93	
8+00	195.0	182.38	12.6									
	196.41	182.71 OUT 182.88 IN	13.7	8+84.7	8+64.2 TAP 6" Service E. Top 195.6 Flo 183.81		216899 94-2305		4219 SPYGLASS 4302 SPYGLASS		1-22-91 11-27-91	
9+00	195.4	182.93	12.5		9+74.7 TAP 4" S.C. 40 P.V.C. 9+96.2 SADDLE 4" PVC 40 P.V.C. 10+75.1		20673 94-21605		4303 N. SPYGLASS 4304 SPYGLASS		5-19-88 7-2-91	
10+00	195.1	183.28	11.8				94-12587		4311 SPYGLASS		7-28-94	
	196.26	183.56 OUT 183.66 IN	12.7	10+82.7	4" PVC 40 11+48.7 TAP		92-17505		4319 SPYGLASS		1-31-92	
11+00	196.4	183.73	12.7				20123		4323 SPYGLASS		4-7-88	
12+00	197.0	184.10	12.9									
	197.92	184.44 OUT 184.54 IN	13.5	12+88.8	4" S.C. 40 13+44.8		94-11241-7		4327 SPYGLASS 4351 SPYGLASS		7-20-94 8-17-98	
13+00	198.0	184.59	13.4				94-14385-7		4335 N. Spyness C.R.		9-2-94	
14+00	199.0	185.01	14.0									
	199.19	185.24 OUT 185.29 IN	14.0	14+52.7	4" S.C. 40 P.V.C. 14+94.2 TAP		94-14385-7		4403 SPYGLASS		9-21-98	
15+00	200.4	185.46	14.9									
					6" Service E Top 199.5 Flo 187.09		9817457		4407 N. Spyness		6-10-97	
15+73.1												
16+00	199.5	185.82	13.7		16+17.2 TAP 4" PVC 40 17+19.2		18491		4411 SPYGLASS		8-14-96	
17+00	199.5	186.18	13.3				94-0425		4410 SPYGLASS		8-13-97	7-30-97
	199.89	186.21 OUT 186.29 IN	13.7	17+08.2	6" Service E Top 200.0 Flo 187.20		94-13217		4410 SPYGLASS		8-13-97	7-30-97
18+00	200.0	186.66	13.3									
					6" Service E Top 199.5 Flo 188.09		97-65177		4414 SPYGLASS		4-17-97	
18+46.2												
19+00	200.1	187.05	13.1		4" S.C. 40 P.V.C. 19+31.2 N/C		94-5268-7		4423 N. Spyness C.R.		4-12-94	
20+00	200.6	187.45	13.2				97-66827		4427 SPYGLASS		4-29-97	
21+00	201.2	187.85	13.4		4" PVC 40 6" Service E Top 200.8 Flo 189.14		94-12367		4434 SPYGLASS	4430 N. SPYGLASS	1-9-95	6-24-94
21+07.2									4435 SPYGLASS		9-25-97	
	202.29	188.19 OUT 190.69 IN	14.1	21+85.6	TAP 4" PVC 22+19.6 TAP		94-03035		4509 SPYGLASS		12-8-05	
22+00	202.0	190.74	11.3									
					4" S.C. 40 P.V.C. 6" Service E Top 203.0 Flo 192.37		94-29427		4506 N. Spyness C.R.	4502 SPYGLASS	11-12-93	97-28-94
22+89.4												
23+00	203.1	191.12	12.0									
24+00	204.4	191.49	12.9				94-21927		4511 SPYGLASS		12-10-98	
	205.94	191.74 OUT 192.00 IN	14.2	24+65.8			94-1307		4515 SPYGLASS		1-11-99	
25+00	205.3	192.13	13.2									
26+00	205.5	192.51	13.0									
					4" PVC 40 26+55.8		95-14357		8603 Champion		9-6-95	
27+00	205.0	192.89	12.1									
28+00	204.5	193.27	11.2									
	204.59	193.48 OUT 193.54 IN	11.1	28+56.1	4" S.C. 40 P.V.C. 28+16.1		94-11897		8607 Champion		7-1-94	
29+00	204.0	193.79	10.2									
	204.64	194.11	10.5	29+55.2	4" S.C. 40 P.V.C. 29+55.2		98-13507		8615 Champion		1-28-98	
0+00	193.91	182.84	11.1	6+81.5 L-1	4" S.C. 40 P.V.C. 0+00 6+81.5 L-1		95-9487		8619 Champion		6-22-85	
0+45.0					6" Service S Top 194.3 Flo 185.31		92-8101-7		9253 Spyness		6-3-92	
1+00	194.4	184.52	9.9									
	194.48	184.66	9.8	1+08.1	9" stub S 4" stub E		26284	93-7330-7	4202 SPYGLASS	4206 SPYGLASS	10-4-90	4-2-93
					6" Service S Top 194.3 Flo 185.31		9618367	94-21387	4214 SPYGLASS	4216 SPYGLASS	10-25-92	8/8/88

LINE 6