


All MH's ARE SHALLOW Tp 'P'

LAT 36, MAIN 3, SAN. SEWER #22  
 468-76-245-81673-000-000-001  
 Built By Wildcat Const.  
 Booked 8-5-87 from 12-P

876

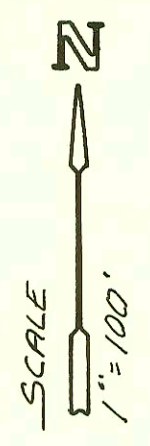

LAT 232 SW. INTERCEPTOR SEWER  
 468-76-245-81643-000-000-001  
 Built Mid-States Const.  
 Booked 8-24-87 From NLH-1

