
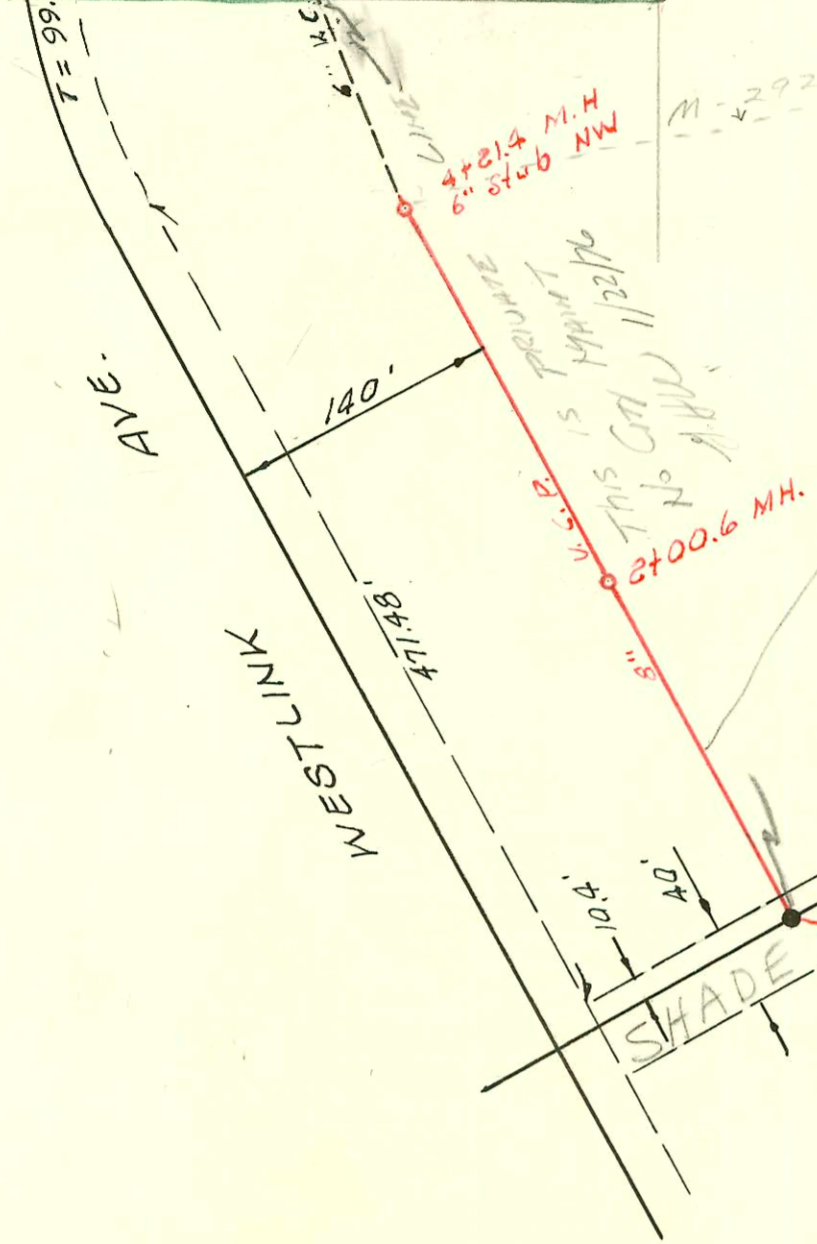


CENTRAL AVE.

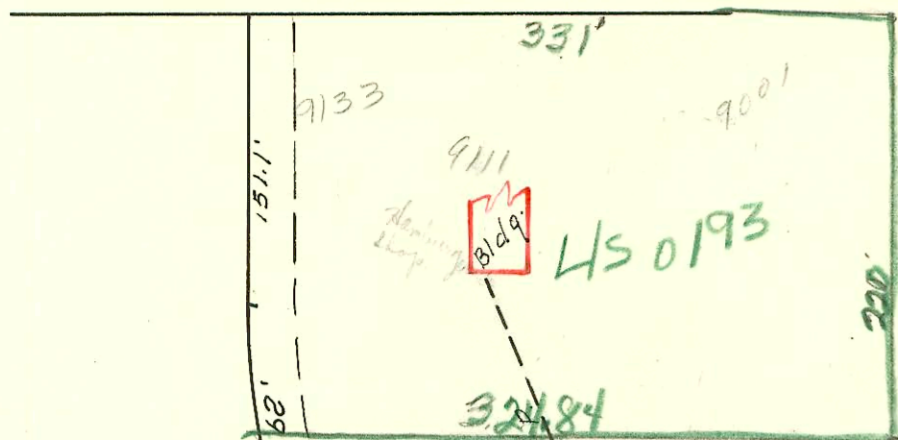

Refer to Plat S-49
 EASE now shown
 ON Replat.
 CK with sewer main
 concerning this 8" line
 to see if still
 private.

WESTLINK CENTER SAN. SEWER
 UTILITY CONT. INC. AUG. 1966
 PRIVATE CONTRACT, BK. K-79
 9 - 6 - 66

K

CONSTRUCTION RECORD						SERVICE RECORD						
STATION	ELEVATION		Depth	MANHOLE	4-INCH "Y" BRANCHES		No. of Permit		House Number		DATE OF PERMITS	
	Ground	Grade			North West	South East	North West	South East	North West	South East	North West	South East
0+00	141.4	134.35	7.0	0+00.0 Existg MH								
1+00	141.3	134.55	6.7									
2+00	141.3	134.75	6.5	2+00 ⁶		2+59.2		57296		9035W Central		8-20-76
3+00	140.1	134.95	5.1									
4+00	139.8	135.15	4.6									
	139.6	135.19	4.4	4+21 ⁴	M.H. TAP 6" stub NW	see below		C35365 8-15-80 6253 M.H. Tap C6020		9001W Central 9111W Central 9105-07 W. Central		10-12-72 12-2-83 8-29-86 12-5-67

#17618 9133 W-Central 4+21.4 6" stub NW TAP 1-12-87