
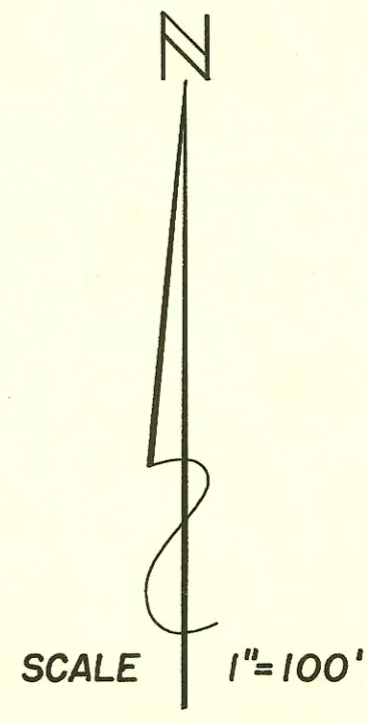


**LAT. 8 , SUB. 8 , W. I. S.**  
 UTILITY CONTRACTORS, INC. 3-19-63  
 C27-105 K-59 BOOKED 4-22-63

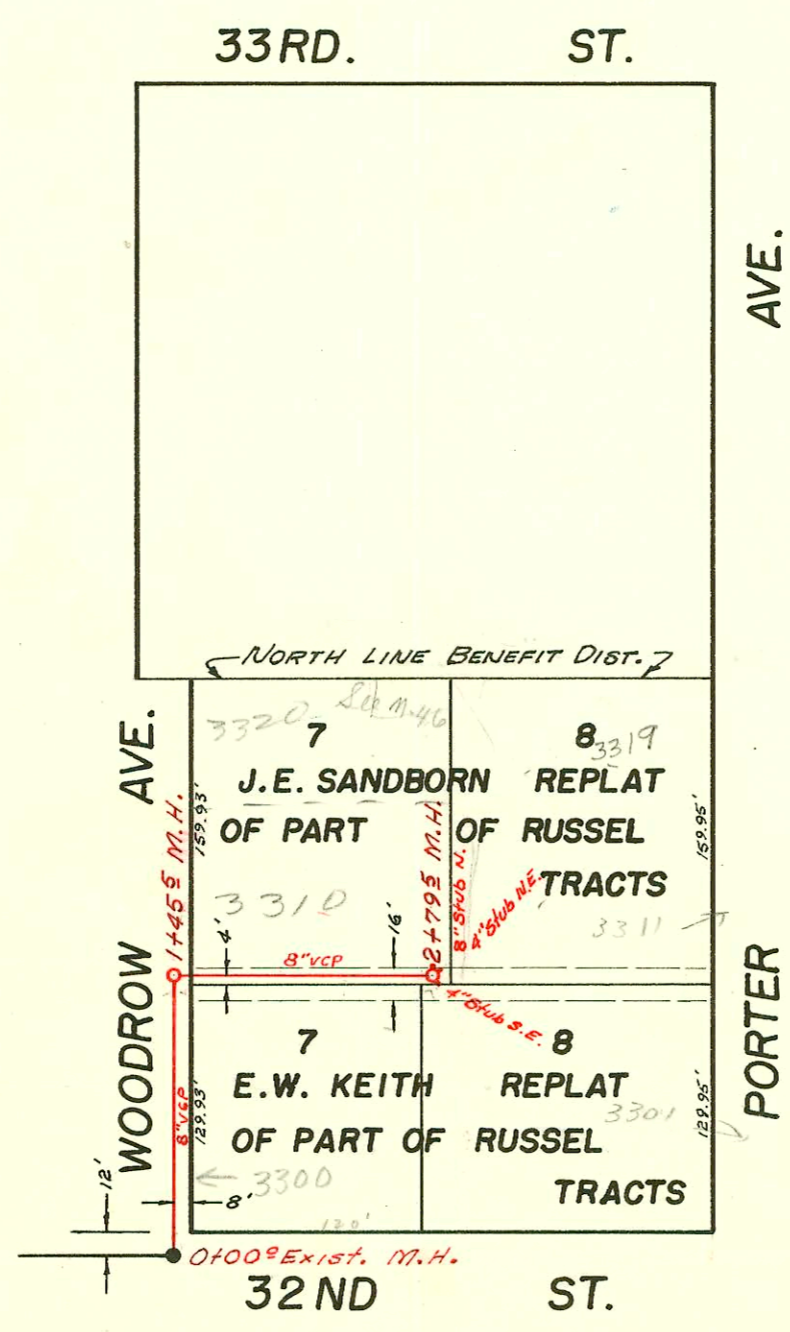

**LAT. 5 , SUB. 17 , S.S. NO. 22**  
 UTILITY CONTRACTORS, INC. 3-27-63  
 C22-48 K-73 BOOKED 4-22-63

CONSTRUCTION RECORD						SERVICE RECORD						
STATION	ELEVATION		Depth	MANHOLE	4-INCH "Y" BRANCHES		No. of Permit		House Number		DATE OF PERMITS	
	Ground	Grade			North-West	South-East	North-West	South-East	North-West	South-East	North-West	South-East
LAT. 8, SUB. 8, W.I.S.												
0+00	155.55	144.84	10.7	EXIST. 0+00								
1+00	155.2	145.64	9.6									
	157.3	146.22 146.38	11.1 10.9	1+72								
2+00	157.7	146.54	11.2		1+97	1+95	B335	B2249	1002 Capri	1001 Eastern	10-31-63	11-4-64
3+00	158.5	147.34	11.2		2+62	2+60	B336	B2266	1006 Capri	1005 Eastern	10-31-63	1-14-65
4+00	159.2	148.14	11.1		3+31	3+29	B155	B2704	1010 Capri	1009 Eastern	9-17-63	1-21-65
					3+90	3+88	B156	B2457	1014 Capri	1013 Eastern	9-17-63	12-7-64
5+00	160.4	148.78 149.30	11.6 11.1	4+80	4+59	4+57		B2250		1017 Eastern		11-4-64
	161.1	149.74	11.4		5+20	5+18	#17160		1022 Capri		5-6-63	
6+00	163.1	151.94	11.2		5+94	5+92	#16331	B1954	1025 Capri	1025 EASTERN	4-1-63	9-10-64
7+00	165.4	154.14	11.3		6+56	6+54	#17261	B1953	1030 Capri	1029 EASTERN	6-12-63	11-3-64
8+00	167.7	156.34	11.4	8+00	7+21	7+19	#17165	B1203	1034 Capri	1033 Eastern	5-23-63	5-5-64
					7+85	7+83	#16330	B1741	1038 Capri	1037 Eastern	4-1-63	8-6-64
LAT. 5, SUB. 17, S.S. NO. 22												
0+00	130.62	121.18	9.4	EXIST. 0+00								
1+00	131.1	121.38	9.7									
	130.8	121.47 121.57	9.3 9.2	1+45								
2+00	130.6	121.68	8.9		2+18	2+20						
	131.3	121.94 121.84	8.4 8.5	2+79	8" Stub N. 4" Stub S.E.	4" Stub S.E.	#17420	B4461	3311 Porter	3300 Woodrow	3-1-67	11-2-65

#17420 - top - 1018 Capri - Kennedy Bldg - 7-26-63 (4+55)  
 #282092 - top - 1021 Eastern - L. Manning - 10-8-64 (5+20)