



LAT. 3 SUB. 12. W.I.S.  
 UTILITY CONTRACTORS INC. 5-28-63  
 Proj. C23-22 K-70 Booked 6-18-63

**CAUTION**  
**UNDERGROUND**  
**UTILITIES**  
 Please check with K G & E or  
 Southwestern Bell  
 Telephone Co. for Location

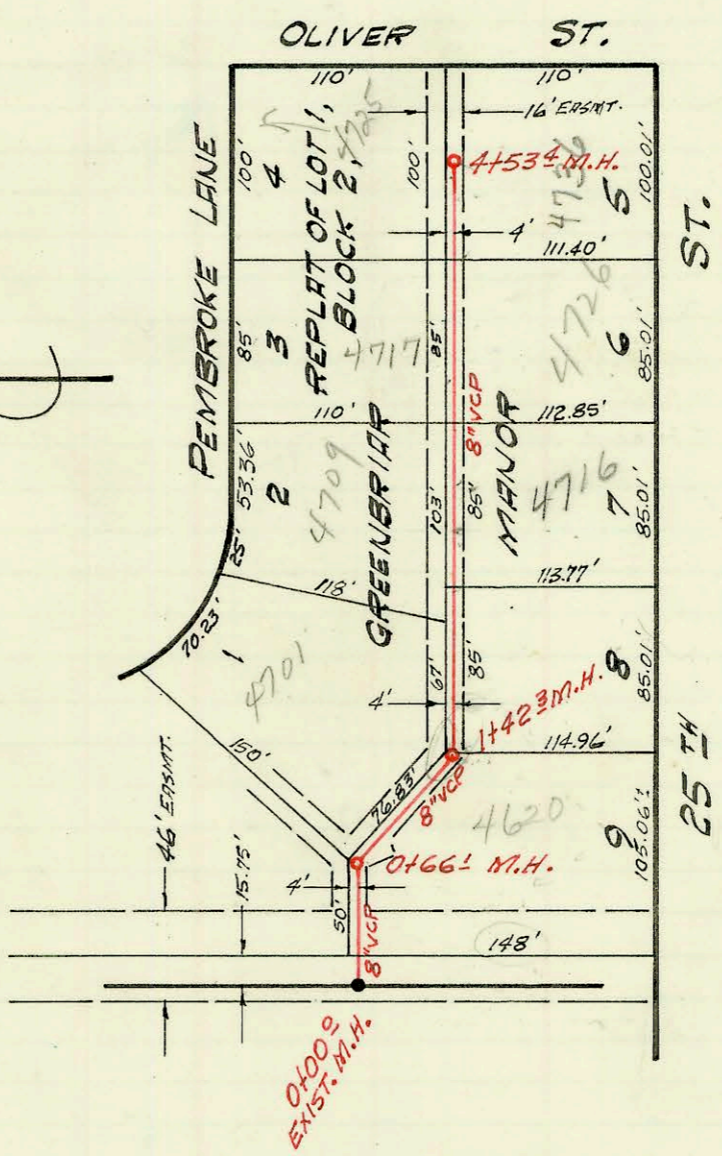

LAT. 17, SUB. 2, S.S. NO. 23  
 W. B. CARTER CONSTRUCTION CO., INC. 5-21-63  
 PROJ. NO. C23-33 K-70 BOOKED 6-26-63

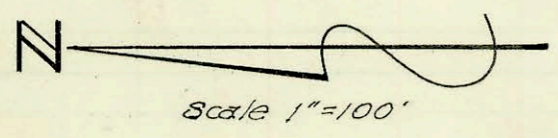