



Rock Rd

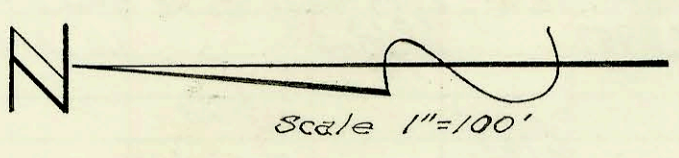

LAT. 1, SUB. 12, W.T.S.
 W.B. CARTER CONSTRUCTION CO., INC. 5-28-63
 PROJ. NO. C23-20 K-72 BOOKED 6-27-63

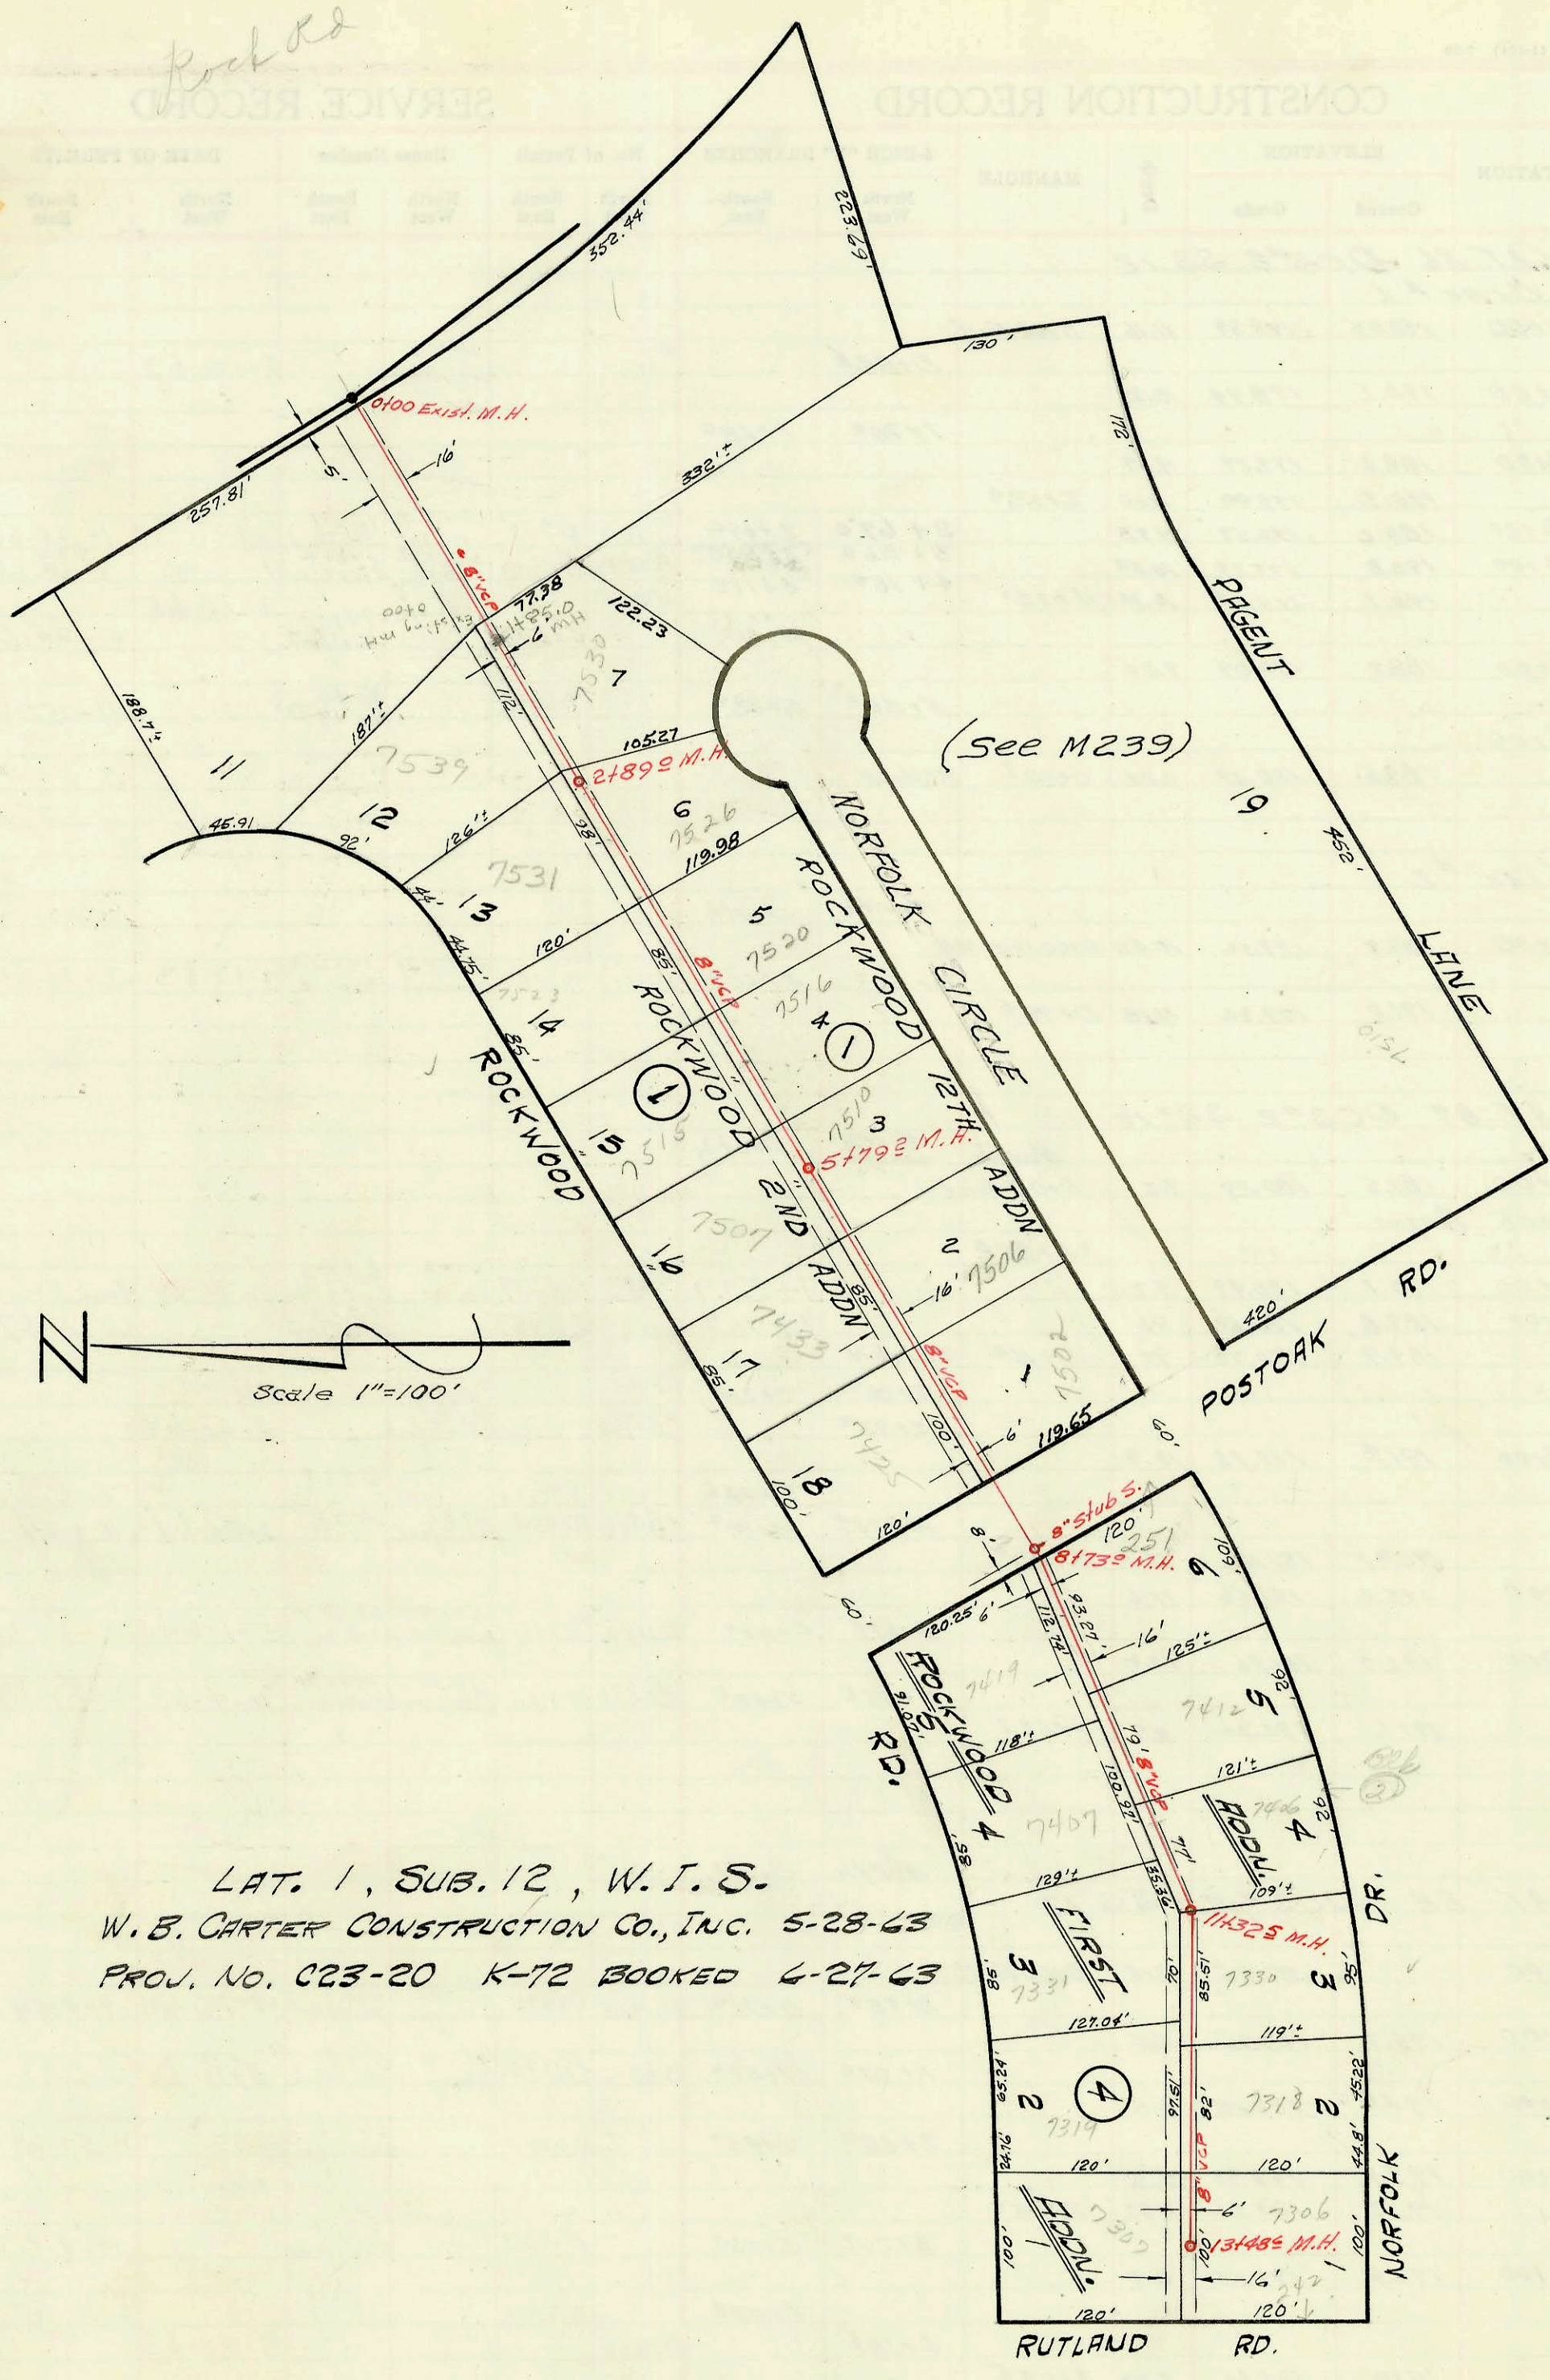