


13<sup>TH</sup> ST  
5<sup>TH</sup> ST  
No

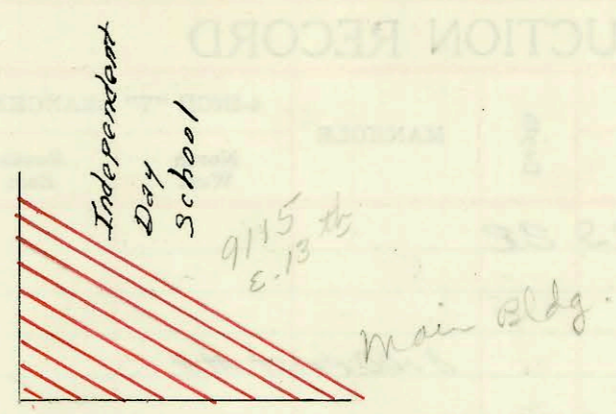

12+65 MH  
2" stub E.

8" Cast iron pipe installed from sta-13+33.5 to sta 14+15.5  
 4" Cast iron wye east at Sta 14+05.5 with 4" Plastic bldg. line connected  
 4" Cast iron wye west at Sta-14+12.5 will be used for new bldg now under const. S.L.P. 6-9-72

Lynn 12+76.5 X

Livingston X

11+99 MH

8+99 MH

5+99 MH

2+99 MH

39+30 (K-15)  
0+00 Exist.

15888 1/2

14052'

8" K.C.P.

9009 Modular Home

Outside City Limits  
 \$ 500 per spec. fee

Wichita Country Club S.S.

Independent Day School San. Sewer  
 W B Carter Constr Co.  
 Private Job K-71 Booked 8-12-63

K110

CONSTRUCTION RECORD

SERVICE RECORD

STATION	ELEVATION		Depth	MANHOLE	4-INCH "Y" BRANCHES		No. of Permit		House Number		DATE OF PERMITS	
	Ground	Grade			North West	South East	North West	South East	North West	South East	North West	South East
0+00	178.2	171.00	7.2	0100 exist								
1+00	177.6	171.60	6.0									
2+00	178.9	172.20	6.7									
	180.8	172.80	8.0	2+99 <sup>o</sup>								
3+00	180.8	172.80	8.0									
4+00	182.7	174.03	8.7									
5+00	183.8	175.26	8.5									
	184.9	176.49	8.4	5+99 <sup>o</sup>								
6+00	184.9	176.49	8.4									
7+00	186.0	177.72	8.3		7+73.0 <sup>ft</sup>		8705		9115 E 13th		7-25-83	
8+00	186.5	178.95	7.5									
	188.0	180.18	7.8	8+99 <sup>o</sup>								
9+00	188.0	180.18	7.8									
10+00	189.4	181.41	8.0									
11+00	179.6	182.64	8.0									
	191.9	183.87	8.0	11+99 <sup>o</sup>								
12+00	191.9	183.87	8.0									
13+00	193.0	185.10	7.9									
14+00	194.0	186.33	7.7									
	194.6	187.20	7.4	14+69 <sup>o</sup> 4" Stub E	6" SCH 40		3526		9115 E 13th (School)		6-7-99	

C57374 8-25-76 W. Frederick - 9009 S. 13th - Sept. (Mendota Home) (7+94.6)  
 C57230 8-16-76 Jack Brown 9115 E. 13th (New Spn) 7.0 (14+31.5) ✓  
 C51470 - 9115 E. 13th - 11-13-75 (11+82.6)  
 C33180 - 9115 E. 13th - 6-27-72 - Jay Sauter  
 Rec. #36704 \$500.00 spec. for 6-17-69 - Kendall Pkg. - 9115 E. 13th - Swimming Pool  
 KC14532 - top - 9115 E. 13th - Kendall Pkg. 6-17-69 (12+80.9)

by Carter → connected (14+69.5) 13th E.

B-1022 - 9115 E 13th - Davis Trenching - 3-12-64 - top (12+76.5) west side of sewer  
 B-3285 - 9115 E. 13th - James Pkg. - 4-27-65 - top (11+79.5) east side of sewer  
 Rec. #65749 \$300.00 spec. for 3 connections - 9115 E. 13th - James Pkg. - 4-27-65  
 C-57374 - 9009 E. 13th St - 8-25-76 - Frederick 195.4' W of 5+99.2 (7+94.6)