


Scale 1" = 100'

Lat 88 S.S. 22
Utility Contr. Inc 6-23-63
Proj No C 23-27 K-69 Booked 8-23-63

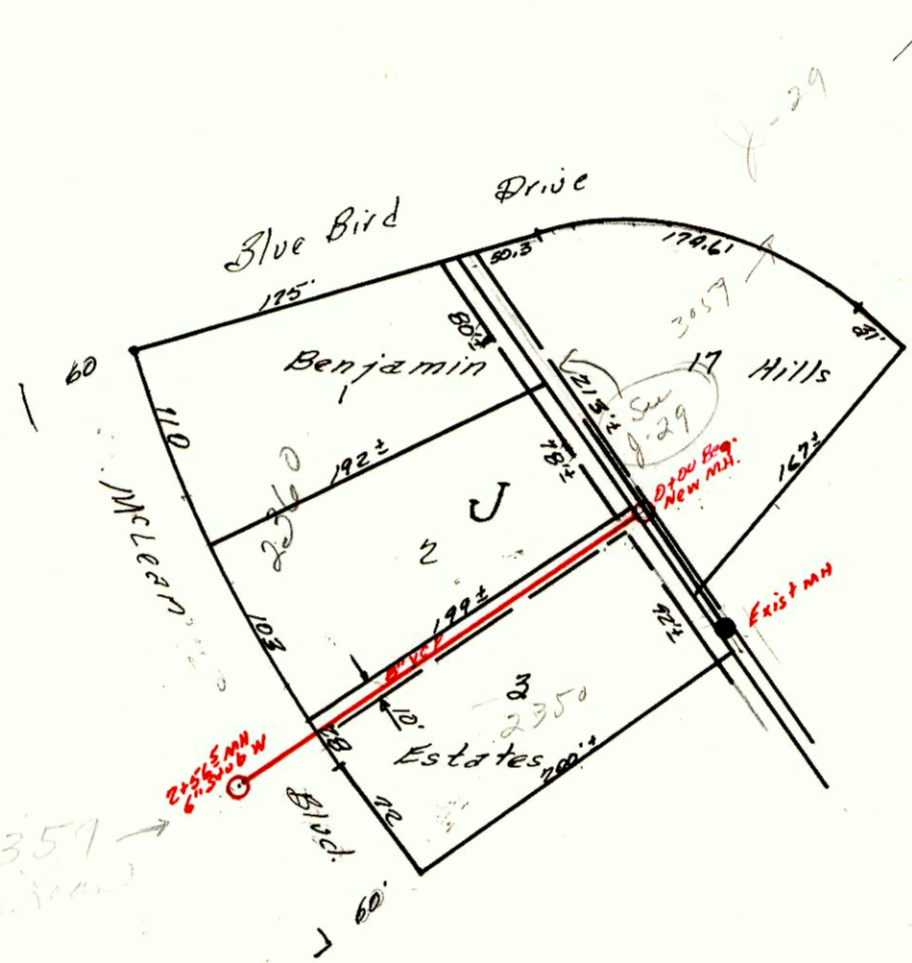

Est. Lat 59 S.S. 22
Utility Contr. Inc.
Private Contract K-69 Booked 8-23-63

2359
McLean

See
p. 171

K112

CONSTRUCTION RECORD						SERVICE RECORD						
STATION	ELEVATION		Depth	MANHOLE	4-INCH "Y" BRANCHES		No. of Permit		House Number		DATE OF PERMITS	
	Ground	Grade			North West	South East	North West	South East	North West	South East	North West	South East
LAT 88	3.3	22										
0+00	125.1	119.52	5.6	0+00 Exst	0+48 ⁰							
						0+57 ⁰		C 22156		3016 W. 21-21		12-10-70
						0+71 ⁶						
1+00	127.3	119.72	7.6			1+57 ⁰		C 9625		3026 W. 21-21		7-16-68
2+00	129.9	119.9	10.0									
						2+16 ⁰						
						2+35 ⁵						
							2+77 ⁰					
3+00	128.0	120.12	7.9		TAP 3+16 ²	3+21 ⁰		C 11295		2336 Redbud		11-6-68
	127.6	120.18	7.4	3+29 ²								
					TAP 3+42.5							
4+00	127.3	120.32	7.0		4+23			C 12011		2332 Redbud		12-19-68
	127.9	120.5	7.4	4+84 6" Stub N.				" B70		2374 Redbud		8-26-63
Ext. LAT 59	SS	22										
0+00	128.5	122.30	6.2	0+00 Exst.								
						0+53 ⁰						
1	128.7	122.50	6.2									
2	128.4	122.70	5.9									
	128.1	122.82	5.3	2+56 ⁵	6" Stub W			B 2663		2359 The Glen		1-14-65

#B66-2350 McLean Blvd - Phipps Bldg - 8-23-63 top (0+64)