


CAUTION
UNDERGROUND
UTILITIES

Please check with K G & E or
 Southwestern Bell
 Telephone Co. for Location

LAT. 2 SUB. 12 W.I.S.
 Utility Contr. Inc. 8-6-63
 Proj. No. C23-21, K-83 Booked 8-23-63

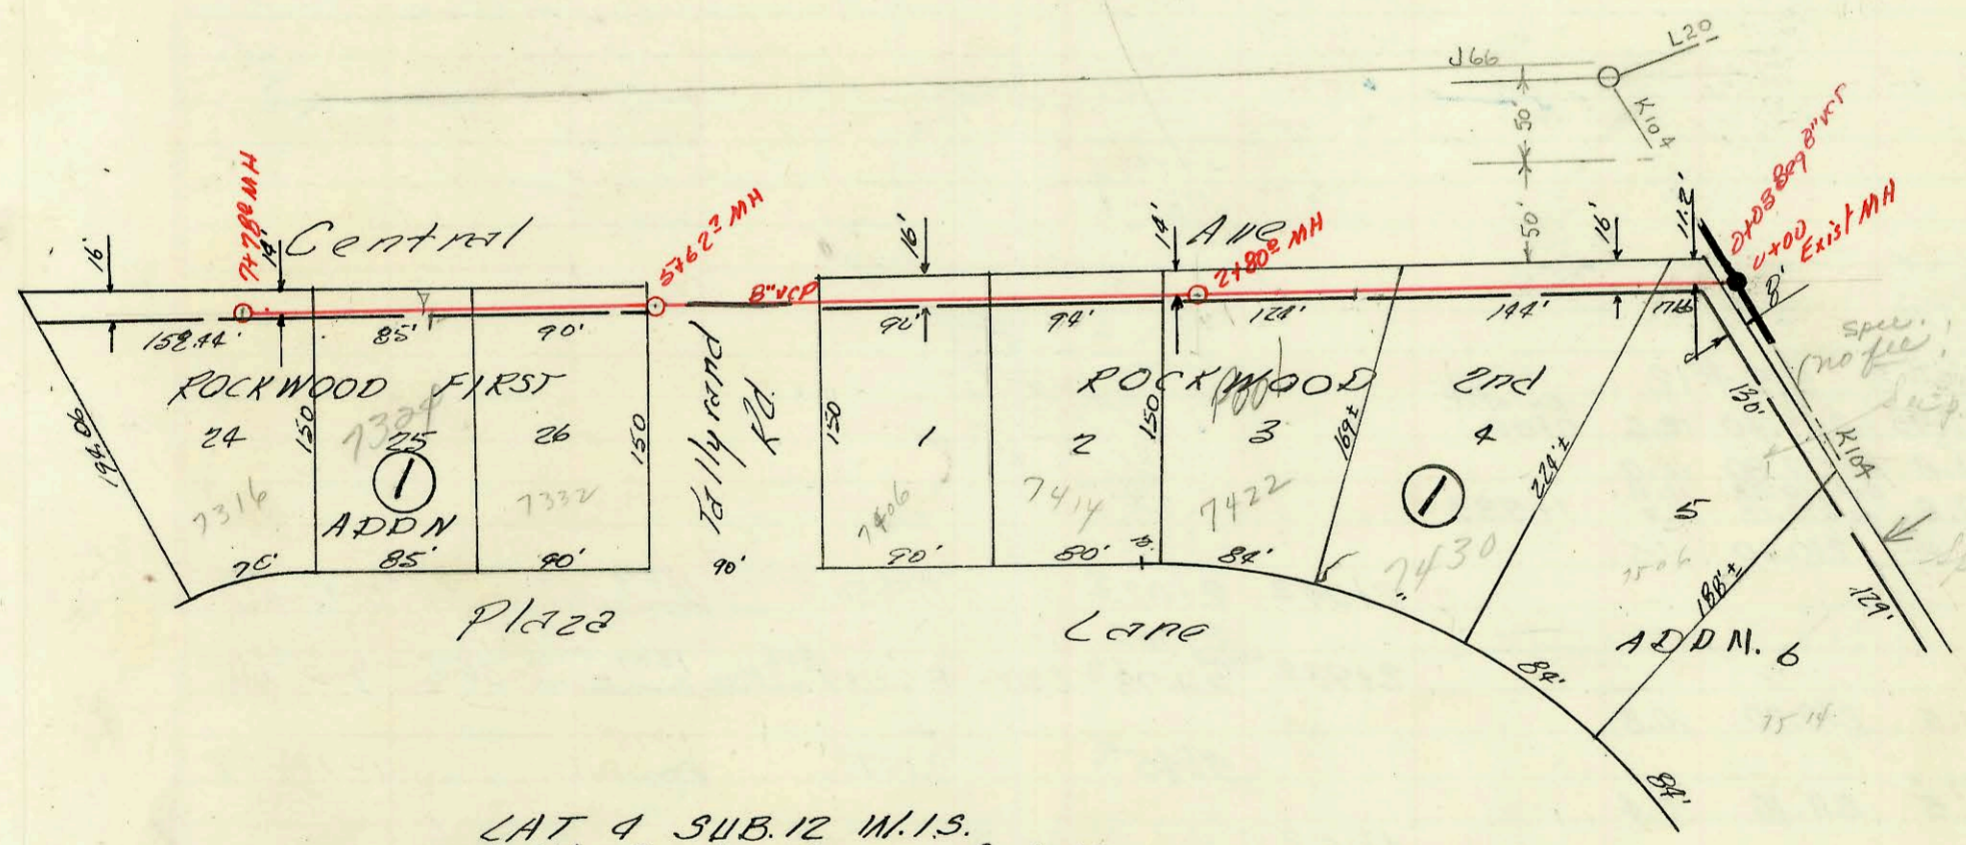

LAT 4 SUB. 12 W.I.S.
 Utility Contr. Inc. 8-6-63
 Proj. No. C23-23, K-83 Booked 8-23-63

SCALE
 1"=100'

K113

CONSTRUCTION RECORD						SERVICE RECORD						
STATION	ELEVATION		Depth	MANHOLE	4-INCH "Y" BRANCHES		No. of Permit		House Number		DATE OF PERMITS	
	Ground	Grade			North West	South East	North West	South East	North West	South East	North West	South East
LAT 2 SUB 12 W13												
0+00	168.8	159.10	9.7	0+00 Beg								
					0+94°W	0+92°E						
1+00	169.3	159.50	9.8									
	169.9	159.80 out 159.90 in	10.1	1+76°	4" Sub S.W. North 1+97°	4" Sub S.E. South 1+99°		33107		7532 Rockwood		7-16-65
2+00	170.1	160.05	10.2									
					2+90°E			B-135		7507 Tanglewood		9-12-63
						2+98°E						
3+00	171.5	160.65	10.8									
	171.5	160.95	10.5	3+49°E								
						3+87°E		B-448		7508 Rockwood		11-26-63
4+00	171.9	161.25	10.6									
					4+09°E			# 314		7439 Tanglewood		10-24-63
						4+70°E		B-610		7432 Rockwood		12-30-63
5+00	172.3	161.85	10.4									
	172.8	163.00 out 162.08 out	9.8	5+38°E = 0+00 Line 1A	5+56°E	5+58°E		B-390		7421 Rockwood	11-19-64	11-13-63
					5+89°E							
6+00	172.7	163.50	9.2									
						6+36°E		B-1521		7416 Rockwood		6-16-64
7+00	173.3	164.30	9.0									
	173.7	164.98	8.7	7+84°E	7+19°E	7+21°E		# B-77 B-1167 B-1248		7339 Tanglewood 7408 Rockwood 7332 Rockwood	8-26-63	4-29-64 5-15-64
LINE 1A												
0+00	172.8	168.00	9.8	0+00 Exist = 5+38°E Line 1	West	East						
						0+28°E						
						0+92°E		# C-11074		7431 Tanglewood		10-24-68
1+00	171.3	164.1	7.2									
	170.9	164.98	6.5	1+69°E	0" Sub S.W.			C-32448		7423 Tanglewood		5-24-72
LAT 4 SUB 12 W15												
0+00	159.8	153.7	6.1	0+00 Exist Beg	North	South						
					0+03	0+13°E		B-5243		7506 Playa Ln		3-15-66
						0+67°E						3-17-66
						0+92°E		14623 B-6087		7430 Playa Ln		7-29-66
1+00	163.8	155.91	8.2									
2+00	165.8	157.12	8.7					# 408 C-1922		7427 Playa Ln		9-9-81 2-16-67
						2+00°E						
						2+22°E						
3+00	168.0	158.50	10.5	2+80°E								
	168.2	158.84	9.4									
4+00	170.3	160.64	9.7									
						3+20°E						
						3+36°E		C-11500		7414 Playa Ln		11-15-68
						4+12°E		B-5343		7406 Playa Ln		3-28-66
5+00	171.5	162.24	9.3									
	172.9	163.60	9.3	5+62°E								
						5+93°E		B-5054		7332 Playa Ln		2-8-66
6+00	173.8	164.25	9.5									
						6+80°E		# 872		7324 Playa Ln		2-14-64
7+00	176.3	166.05	10.2									
	176.7	167.50	9.2	7+78°E End		7+63°E		B-1366		7316 Playa Ln		6-8-64

B-479-7415 Tanglewood CL-12-12-63 - Ken Lippold - top 1+63
 B-847-7523 Playa Ln - 3-4-64 - Reginald Kelly - top 1+43
 B-1765-7516 Rockwood - 8-19-64 - Ken Lippold - top (2+86.5)
 B-1726-7524 Rockwood - 11-27-64 - Ina Kelly - top (2+44)
 B-2349-7407 Tanglewood - 1-5-65 - Kennedy Kelly - top (6+26.4)
 B-3092-7515 Tanglewood - 4-15-65 - Kennedy Kelly - top (1+94)
 B-3449-7431 Tanglewood - 5-20-65 - Ken Lippold - top (1+59)
 # C-11073 - Seal off - 7431 Tanglewood - 10-24-68 - Ken Lippold - (1+59 line 1A)
 B+L EXC-4" SHT 40 - 5' from Main (CLAT LINE) 1-way cleanout
 1/2" dia, 1 H 22