



SERVICE RECORD

CONSTRUCTION RECORD

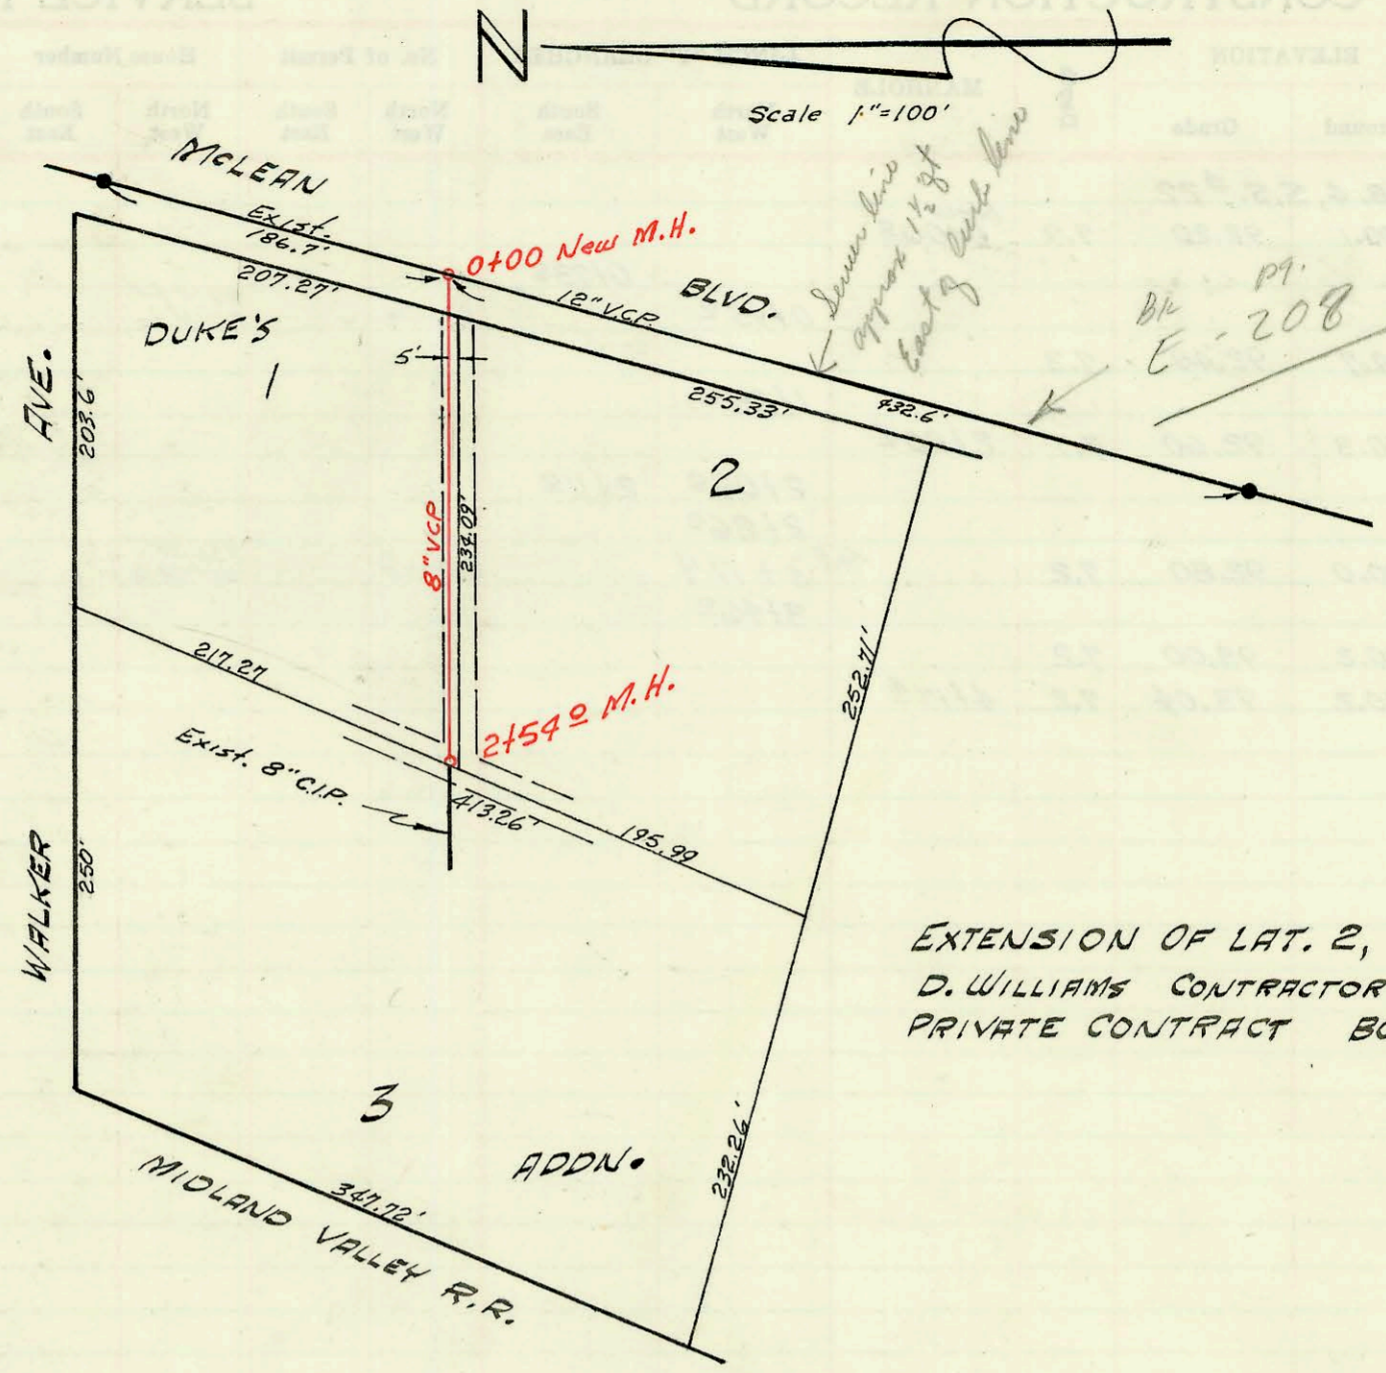

EXTENSION OF LAT. 2, S.S. NO. 21  
 D. WILLIAMS CONTRACTOR 1963  
 PRIVATE CONTRACT BOOKED 9-16-63

Kardner

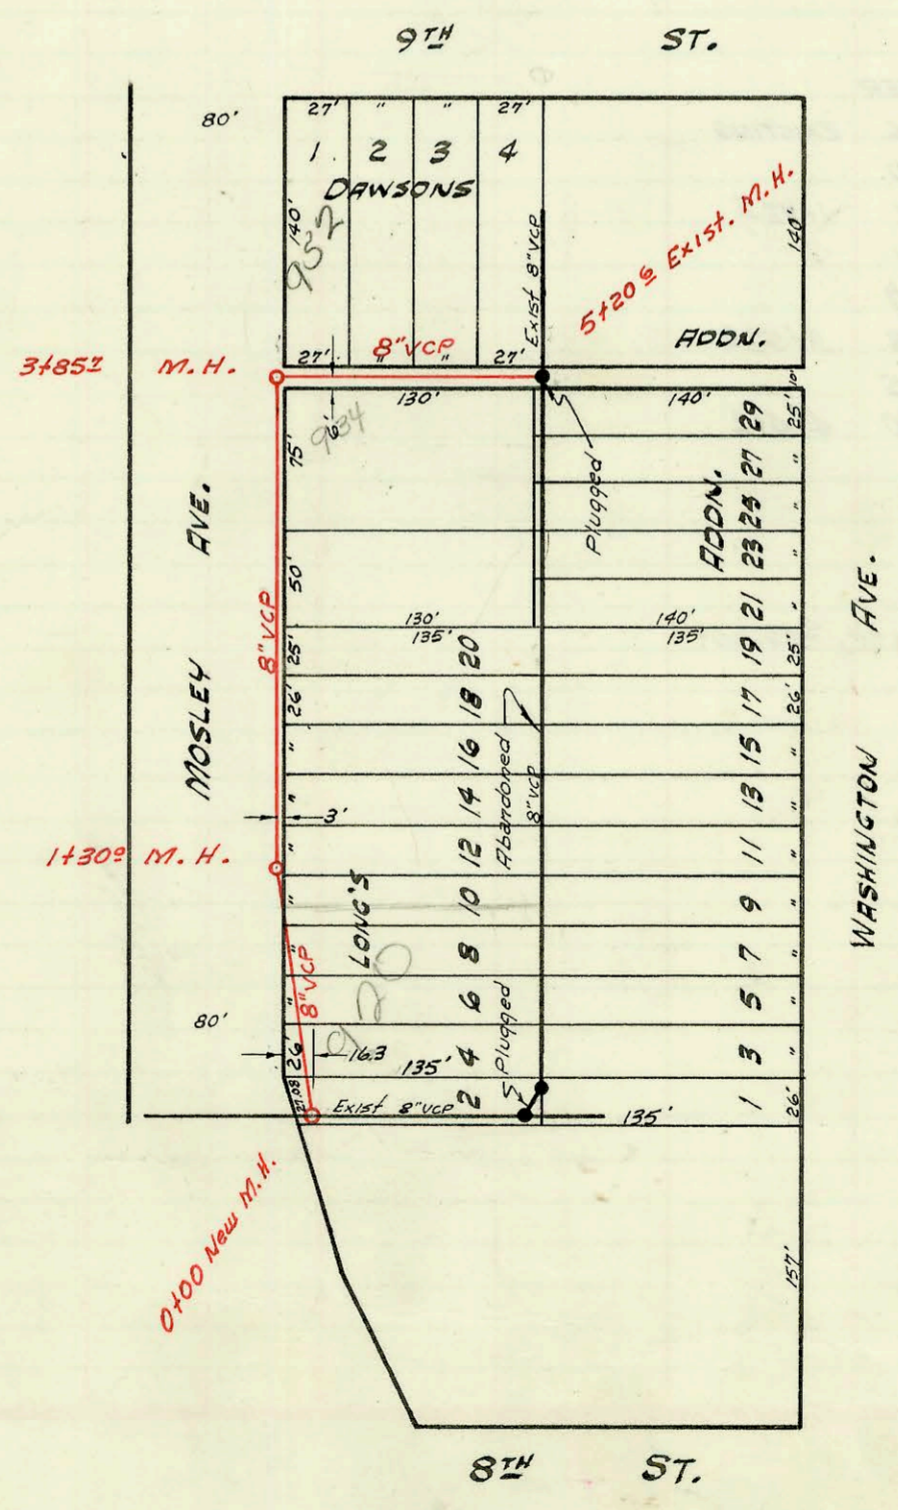

RELOCATION OF EAST SUBMAIN "D" S.S. NO. 1  
 W.B. CARTER CONSTRUCTION CO. 6-4-63  
 PRIVATE CONTRACT Plan BOOKED 9-23-63

