
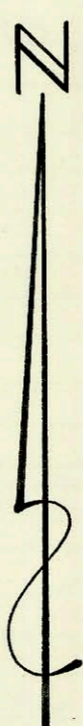


3612  
8-48

CONSTRUCTION RECORD

CONSTRUCTION RECORD

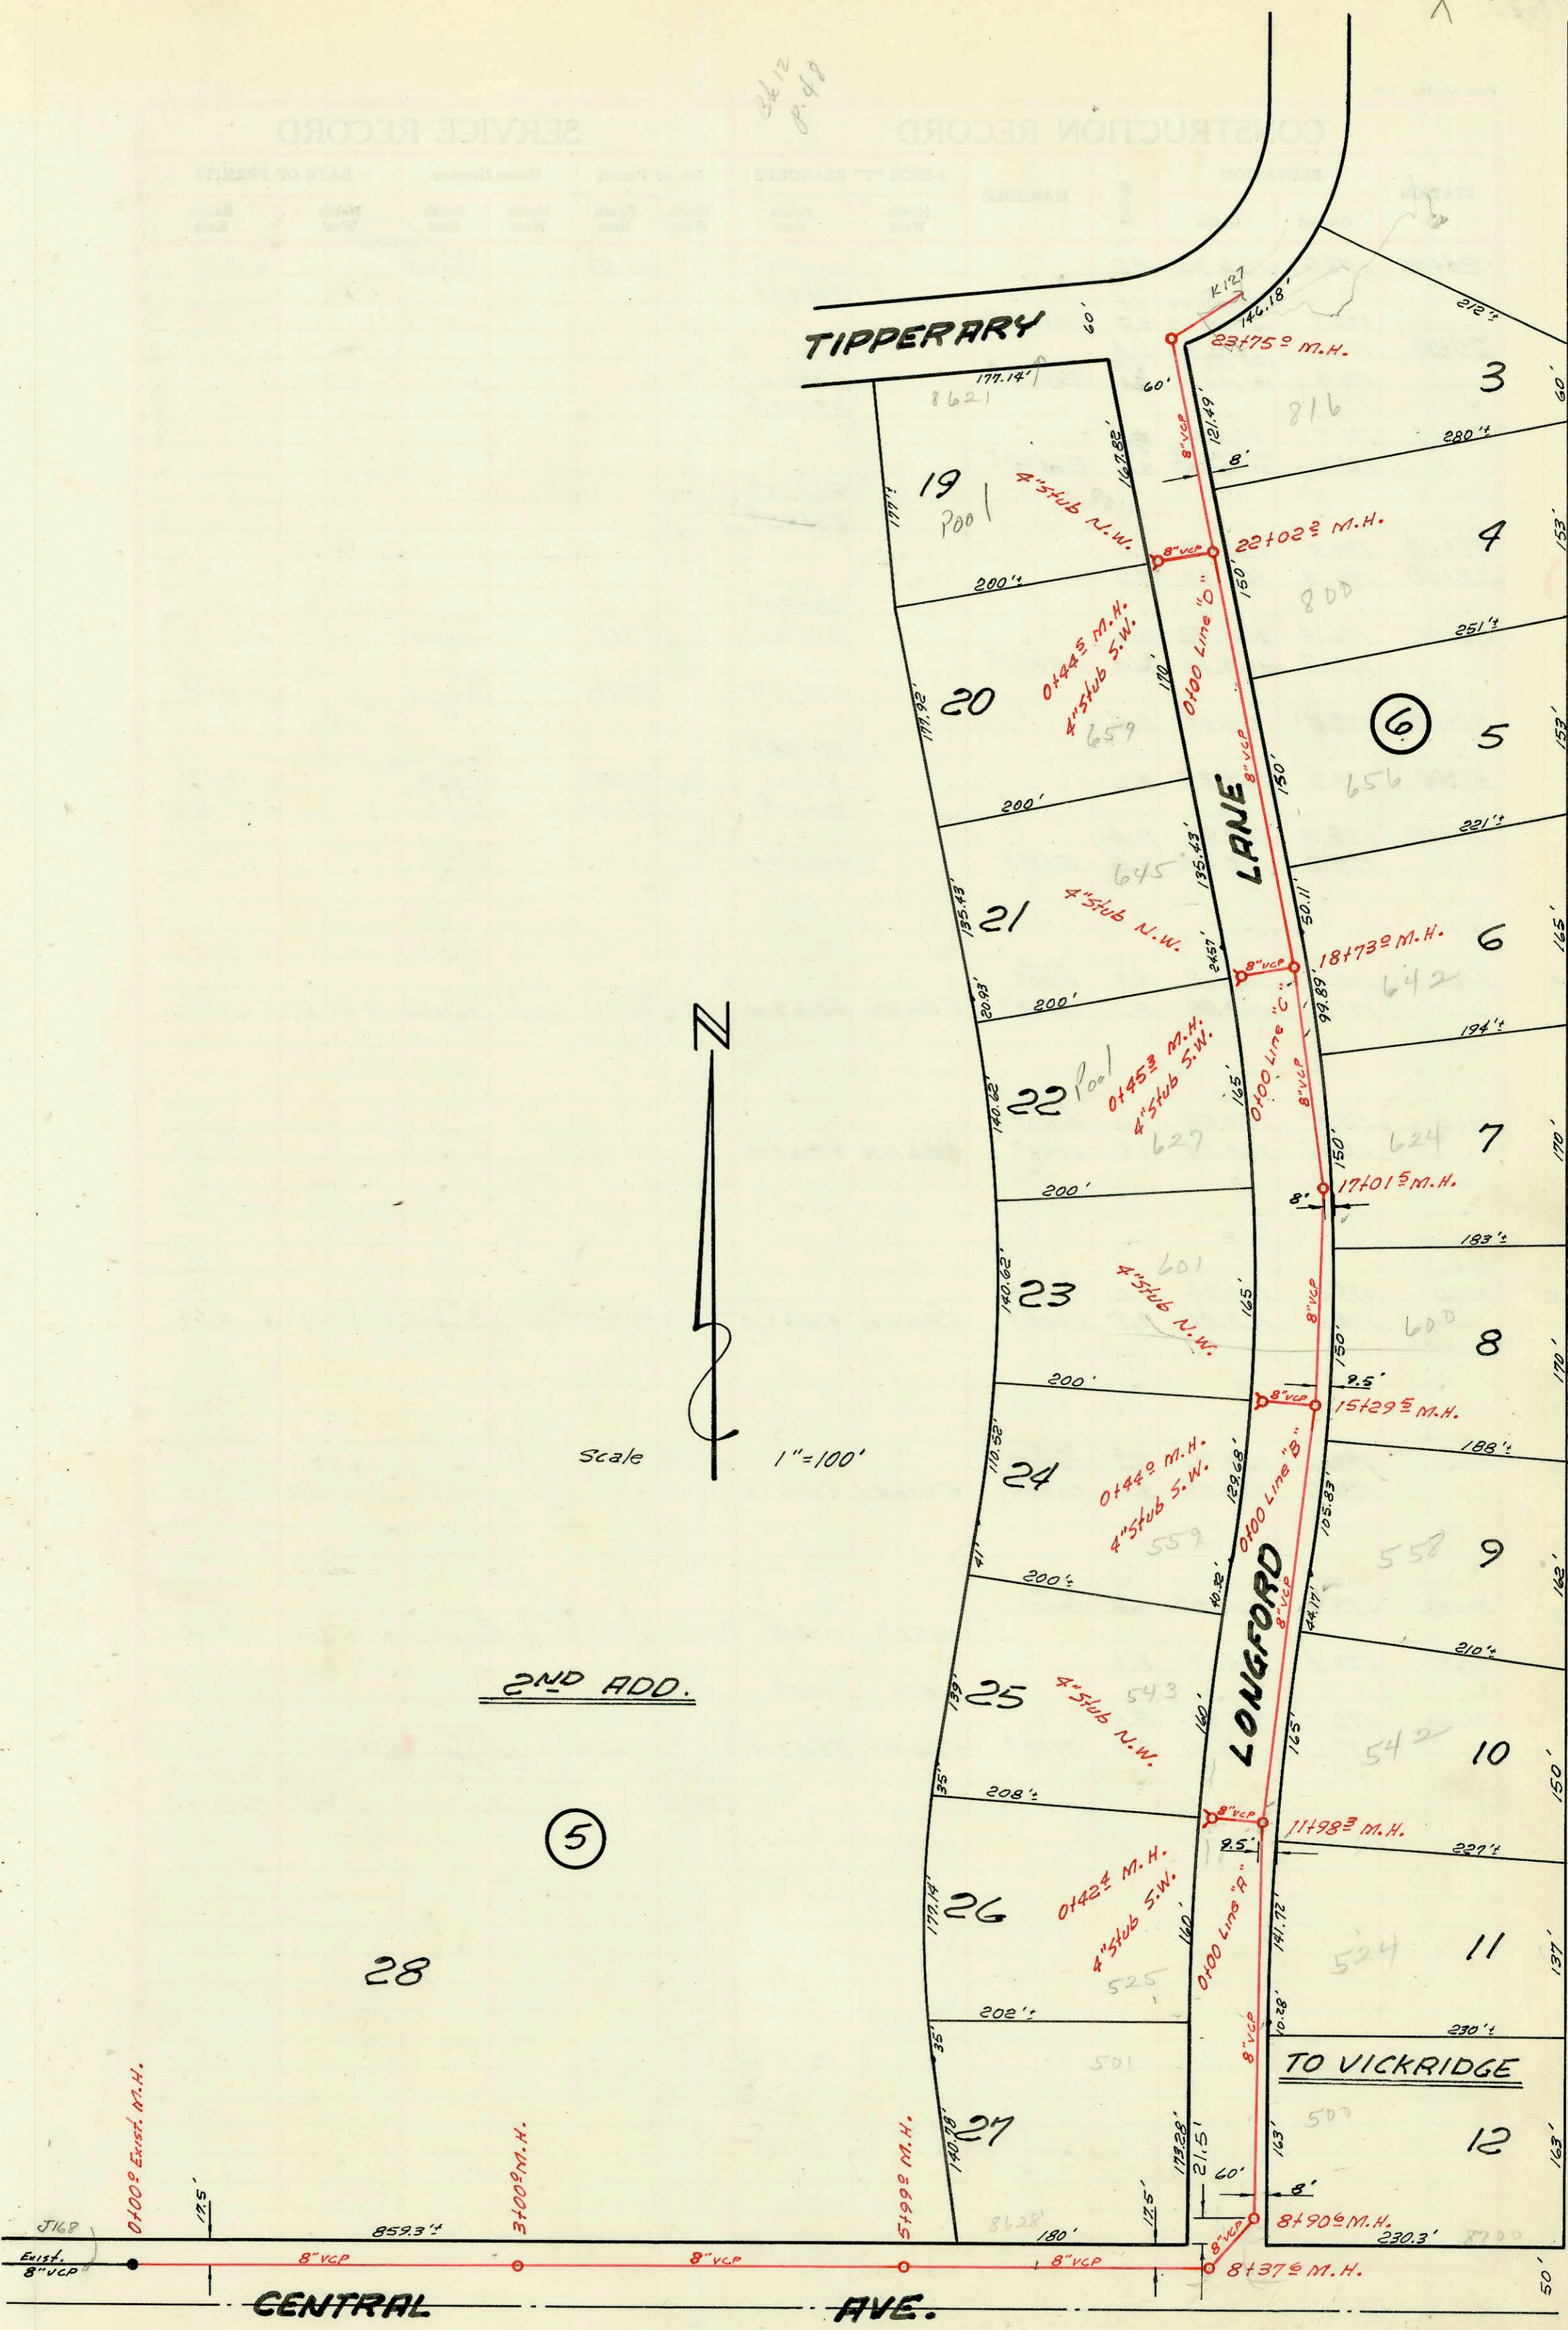

Scale 1" = 100'

2ND ADD.

(5)

28

TO VICKRIDGE

**CENTRAL AVE.**

**LAT. 8, SUB. 9, W. I. S.**

UTILITY CONTRACTORS, INC. 11-19-63  
C23-107 K-70 BOOKED 1-20-64

