
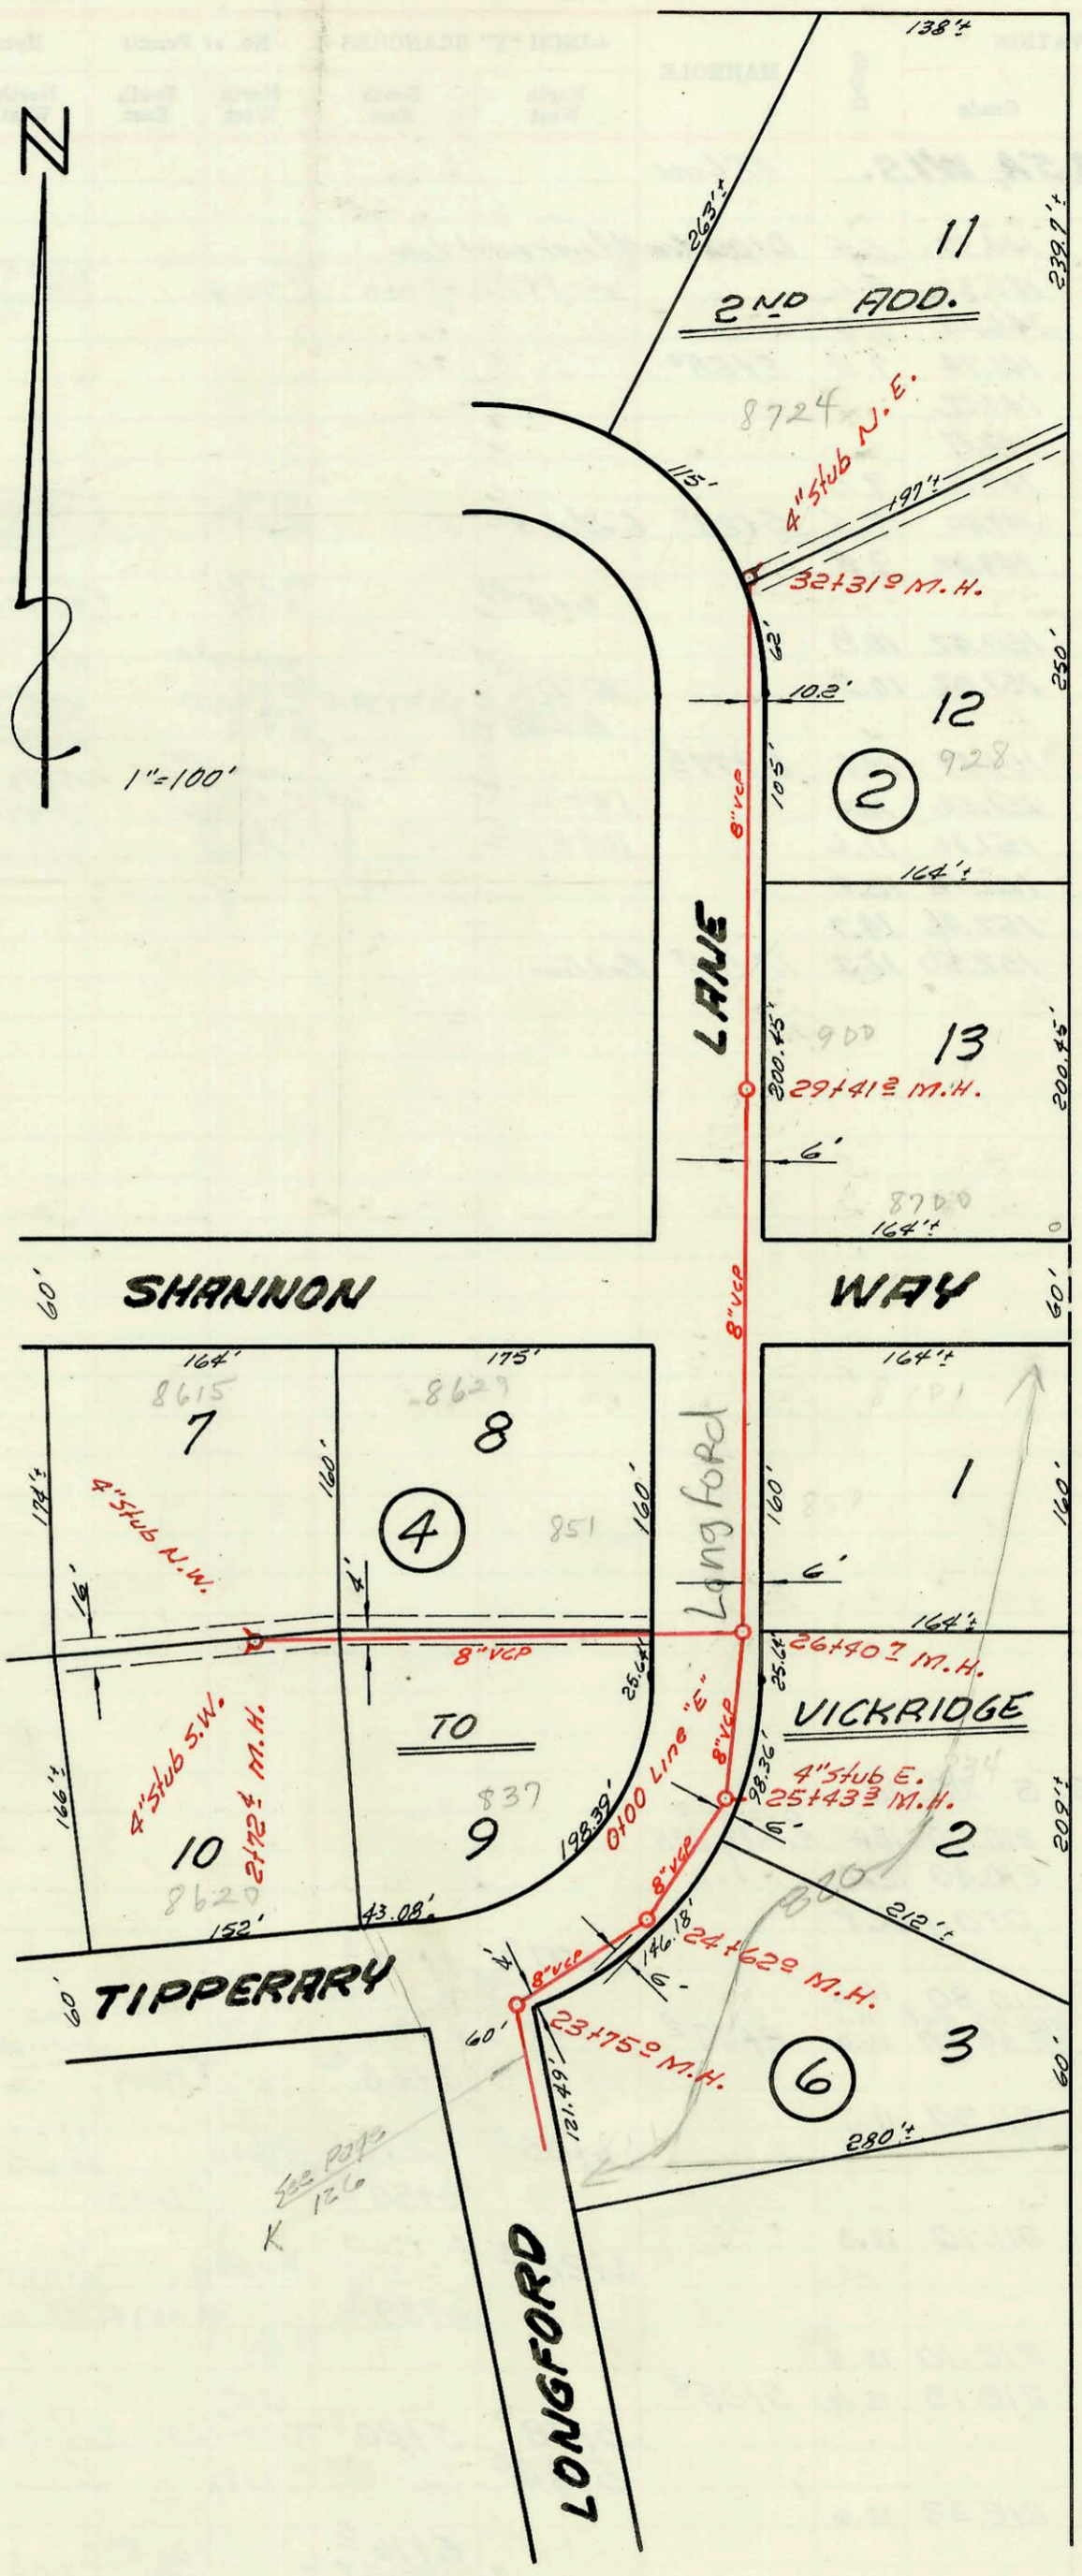


CONSTRUCTION RECORD SERVICE RECORD

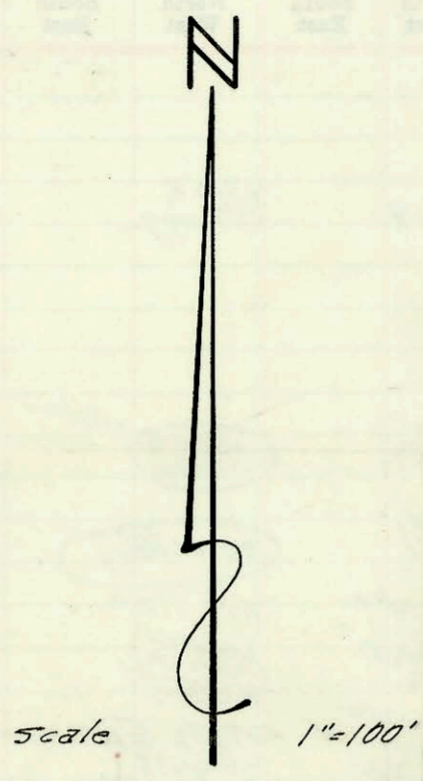

LAT. 8, SUB. 9, W.I.S.

CONSTRUCTION RECORD

SERVICE RECORD

STATION	ELEVATION		Depth	MANHOLE	4-INCH "Y" BRANCHES		No. of Permit		House Number		DATE OF PERMITS		
	Ground	Grade			North West	South East	North West	South East	North West	South East	North West	South East	
24+00	173.5	165.35	8.2			24+07.0 Tap 24+43 ^o		265 27	820 House Hong Kong			1-14-90	
	172.7	out 165.59 in 165.69	7.1 7.0	24+62 ^o									
25+00	172.2	165.85	6.4			4" stub E. 25+60 ^o							
	171.5	out 166.02 in 166.12	5.5 5.4	25+43 ^o									
26+00	171.7	166.35	5.4			26+63 ^o 26+85 ^o							
	171.2	out 166.49 in 166.59	4.7 4.6	26+40 ^o									
27+00	173.3	166.92	6.4			28+84 ^o							
28+00	175.3	167.42	7.9			28+962 ^o							
29+00	176.4	167.92	8.5			29+71 ^o		4938	900 Longford			12-17-81	
	176.7	168.12	8.6	29+41 ^o					950 Longford			6-18-74	
30+00	177.0	168.54	8.5			30+68 ^o							
31+00	177.3	169.24	8.1			31+13 31+61 ^o		Dep # C12734 # C12724	928 (at h) Longford 928 Longford Ln.			2-11-69 2-10-69	
32+00	178.3	169.94	8.4			4" stub N.E.							
	179.7	170.15	9.6	32+31 ^o									
Line "A"	0+00	170.6	162.90	7.7	Exist. 0+00 ^o								
		171.6	163.54	8.1	0+42 ^o	4" stub N.W. 4" stub S.W.		C13291 #2917	543 Longford	525 Longford Ln.		3-27-69	5-1-67
Line "B"	0+00	171.2	163.56	7.6	Exist. 0+00 ^o								
		171.6	164.24	7.4	0+44 ^o	4" stub N.W. 4" stub S.W.		C19708	554 Longford Ln.				6-16-70
Line "C"	0+00	173.8	164.24	9.6	Exist. 0+00 ^o								
		174.6	164.92	9.7	0+45 ^o	4" stub N.W. 4" stub S.W.		C12136 #C13415	645 Longford Ln.	627 Longford Ln.		1-8-69	4-4-69
Line "D"	0+00	173.6	164.90	8.7	Exist. 0+00 ^o								
		175.0	165.58	9.4	0+44 ^o	4" stub N.W. 4" stub S.W.		2052 015 C17135 C1232	8627 Jaffery	859 Longford		11-7-02 12-1-69	12-15-66
Line "E"	0+00	173.4	166.59	6.8	Exist. 0+00 ^o								
						0+82 ^o 0+84 ^o		C23562 C9469	8629 Shannon Way	837 Longford Lane		4-2-71	7-8-68
1+00	175.4	167.19	8.2			1+87 ^o 1+89 ^o							
2+00	176.2	167.79	8.4										
	177.1	168.21	8.9	2+72 ^o	4" stub N.W. 4" stub S.W.			81114 C6238	8615 Shannon Way (back house)	8620 Shannon Way (kitchen drain)		10-28-68	12-22-67
								C15197	8615 Shannon Way (back house)				7-31-67
								C15198	8615 Shannon Way (kitchen drain)				7-31-67