


CONSTRUCTION RECORD SERVICE RECORD

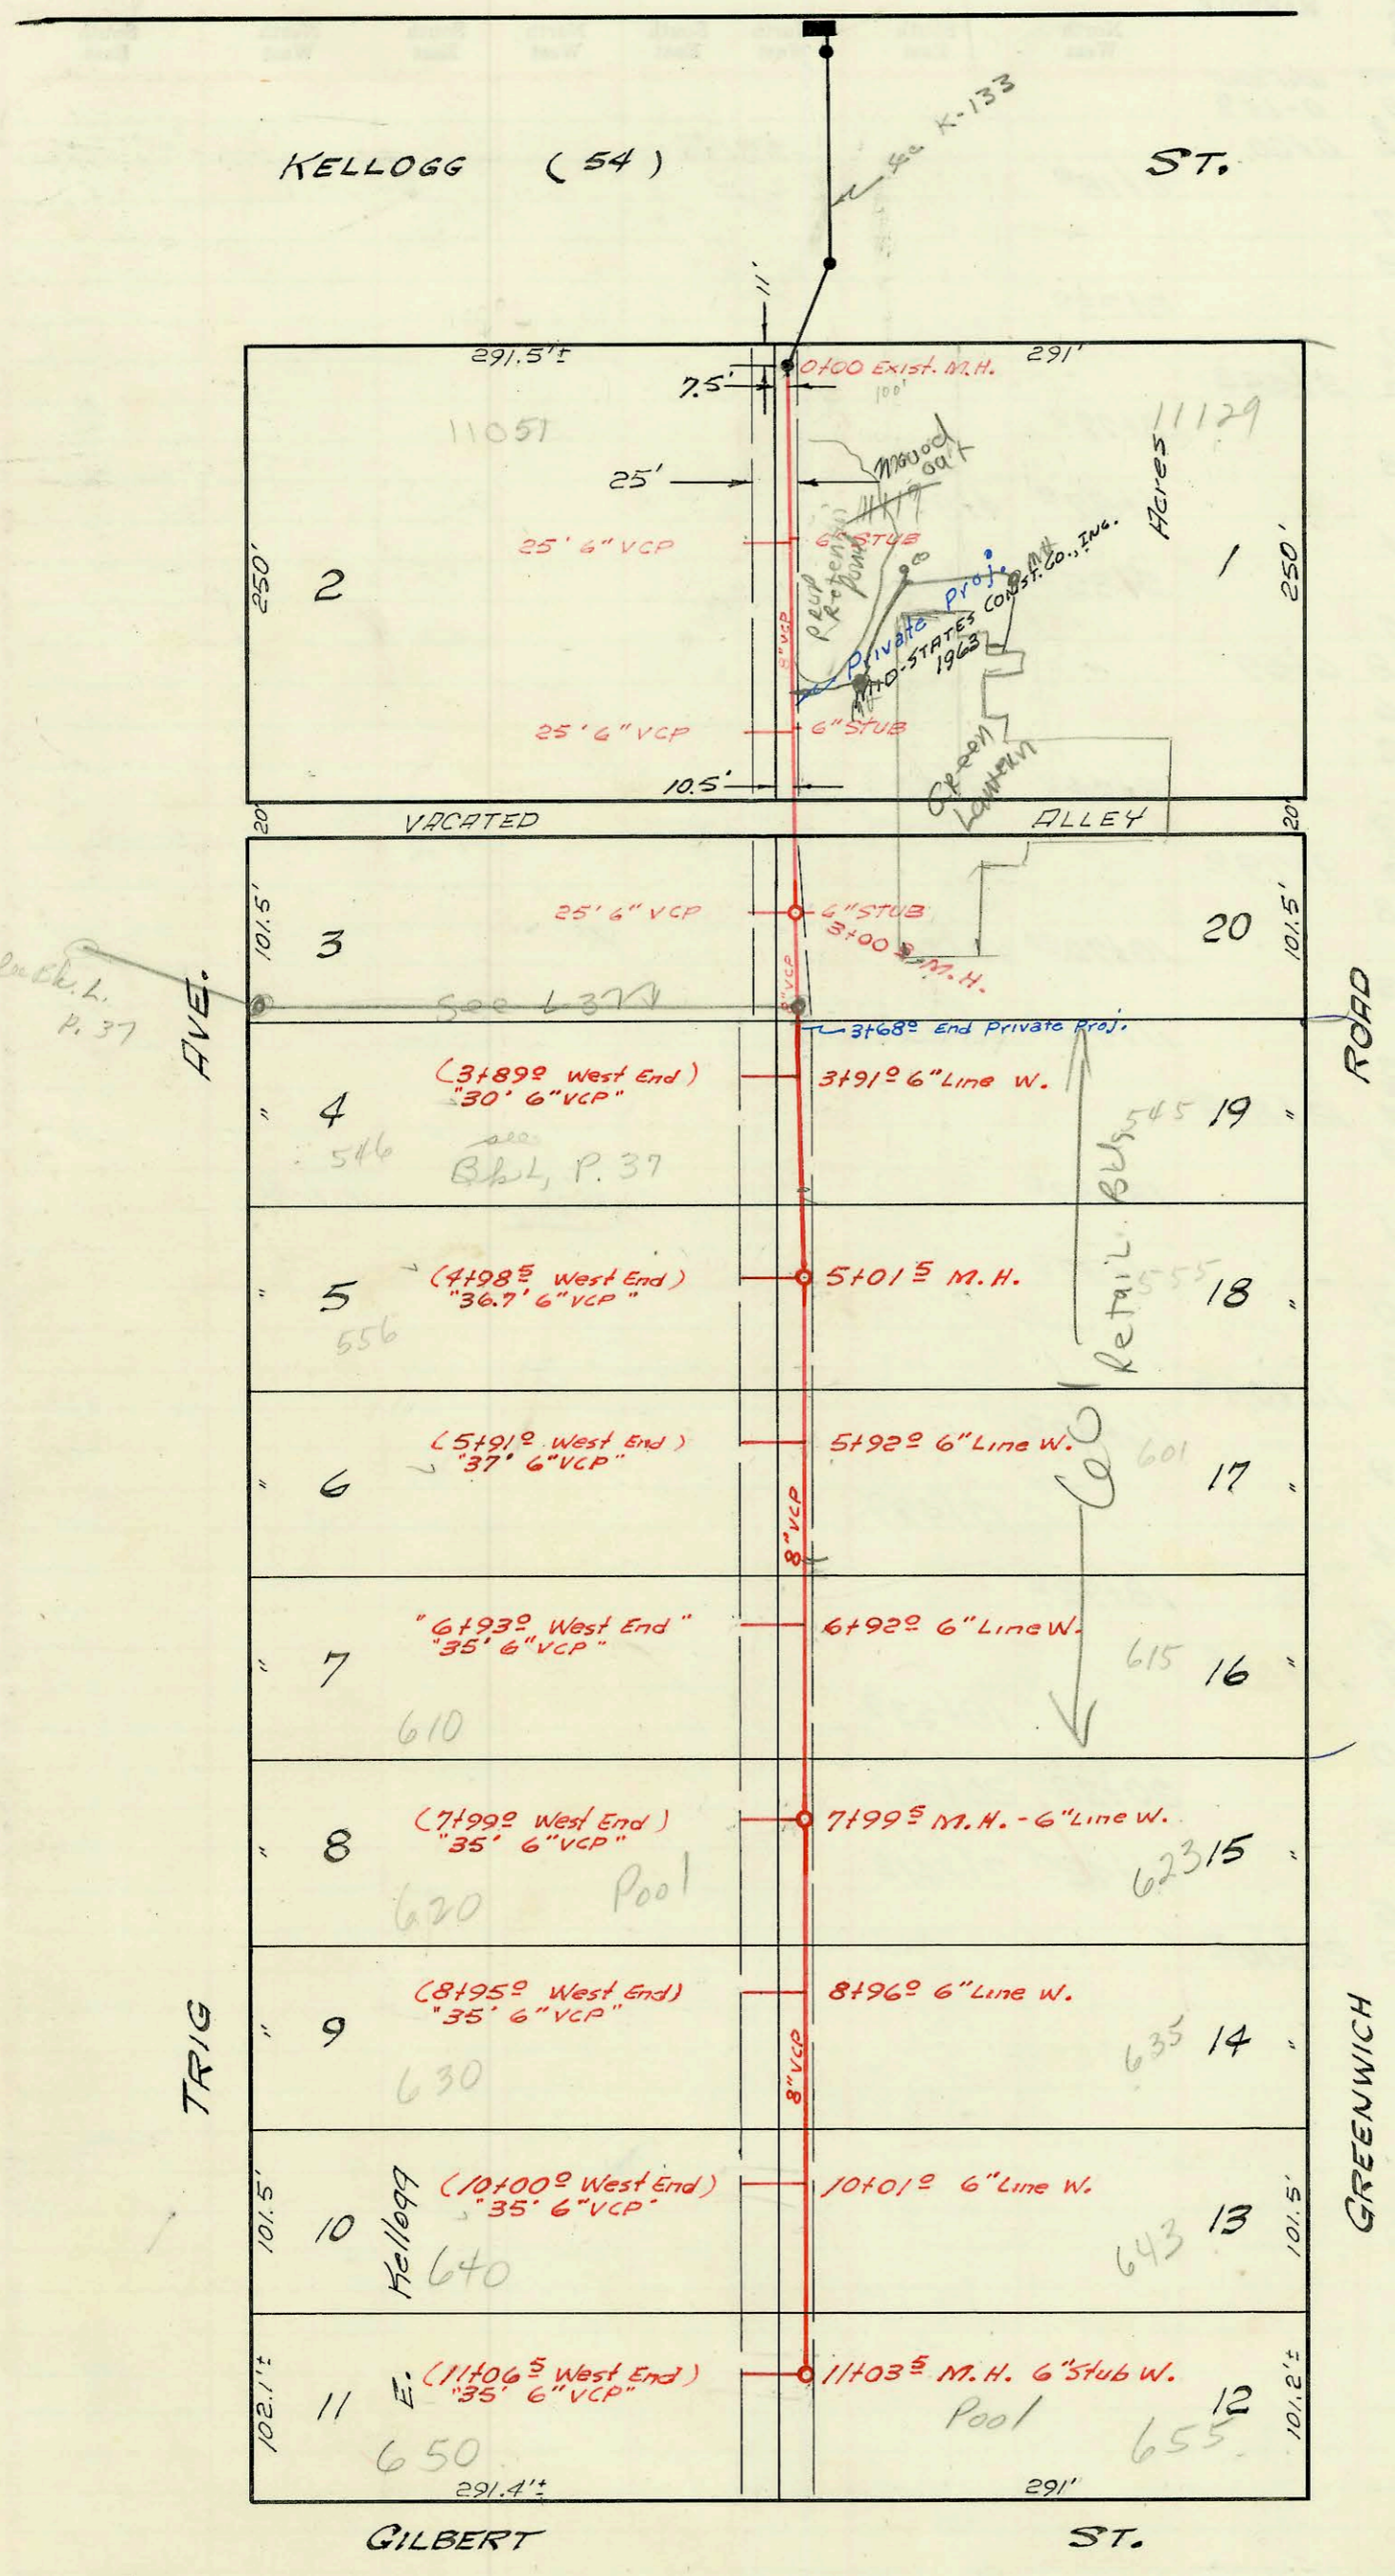

see L. 37
AVE.

Scale 1" = 100'

LATERAL 2, SUBMAIN 13, WAR IND. SEWER
 W. B. CARTER, CONSTRUCTION CO. 12-6, 1963
 PROJ. NO. C23-4 K-74 BOOKED 10-25-63

2112.5

CONSTRUCTION RECORD

SERVICE RECORD

STATION	ELEVATION		Depth	MANHOLE	4-INCH "Y" BRANCHES		No. of Permit		House Number		DATE OF PERMITS	
	Ground	Grade			North West	South East	North West	South East	North West	South East	North West	South East
Lat 2, Sub. B, Wis												
0+00	159.0	143.60	15.4	Exist.	25' Due W. 6" 0+97Z	6" 4" 0+95Z	200246 B3833	11051	1117	52200	7-21-65	5-21-64
1+00	158.2	143.80	14.4									
2+00	157.8	144.00	13.8		25' Due W. 6" 2+02E	6" 4" 2+00E						
3+00	155.7	144.20	11.5		25 Lin Ft. 6" VCP Due W. 3+91E	6" stub E.						
4+00	155.4	144.40	11.0			4+57E	#C4492		545 S. 40		8-17-67	
5+00	155.1	144.60	10.5						556 S. 219			
	155.1	144.60	10.5	5+01E	6" stub W. 5+21.9	5+60E	C32759 14349 1355 23618		555 S. 219		9-30-85	6-4-64 2-20-69
						5+92E						
6+00	154.5	144.80	9.7									
						6+92E	6+59E	C42676	610 S. 219		12-11-73	
7+00	154.0	145.00	9.0									
						7+03E		C63188	615 S. 219		9-23-77	
						7+85E		C39013	623 S. 219		5-15-73	
	152.6	145.20	7.4	7+99E	6" stub W. 3+163 5+2617				630 S. 219		4-21-81 12-11-73	
8+00												
						8+83E		C27850	635 S. 219		9-10-71	
						8+95E						
9+00	152.3	145.40	6.9									
						9+93E		C42678 2005-27 83127 64868	630 S. 219		12-11-73	12-15-05 1-3-66
10+00	152.0	145.60	6.4									
						10+01E		C42679	640 S. 219		12-11-73	
						10+93E						
11+00	151.8	145.80	6.0									
	151.8	145.80	6.0	11+03E	6" stub W. C42680				650 S. 219		12-11-73	

SWR 2038-02944
 95-1073-7 516-95
 B 3834 7-21-65
 11129 E Kellogg
 4" sch 40 lep
 NIC at Wye Sta 0+95.7

11610 E Kellogg SWR 2004-00448 S/O 40'E f/MH + T' from man - A-Henney 2-21-06