


Belgium

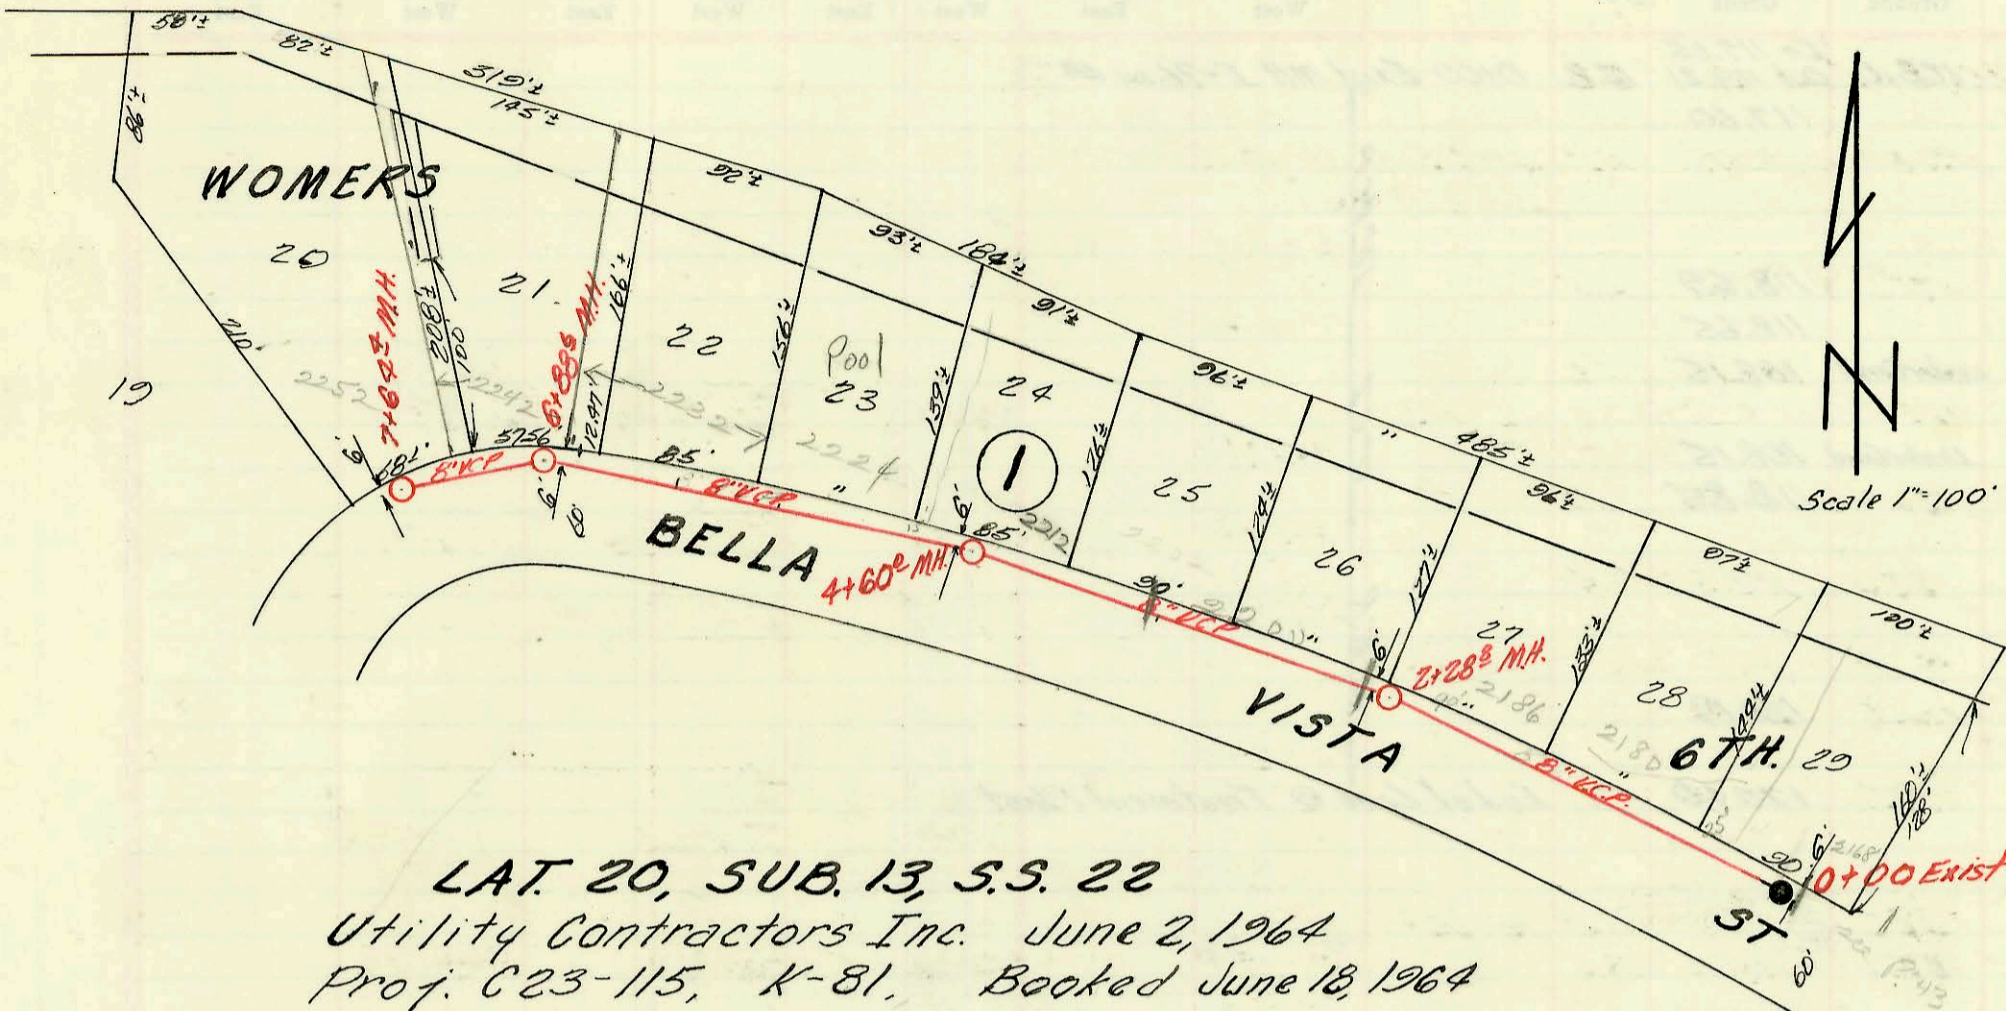

LAT. 20, SUB. 13, S.S. 22
 Utility Contractors Inc. June 2, 1964
 Proj. C23-115, K-81. Booked June 18, 1964

2-146

CONSTRUCTION RECORD						SERVICE RECORD						
STATION	ELEVATION		Depth	MANHOLE	4-INCH "Y" BRANCHES		No. of Permit		House Number		DATE OF PERMITS	
	Ground	Grade			North West	South East	North West	South East	North West	South East	North West	South East
LAT 20, SUB 13, SS# 22												
0+00	122.7	116.76	5.9	0+00 Exist M/H. Sanded R-95								
0+05				8" 8" MCP								
1+00	121.5	116.96	4.5		0+75 ⁰		B4010		2180 Bella Vista		8-23-65	
2+00	122.9	117.16	5.7		1+61 ⁰							
	122.9	117.22	5.7	2+28.8	2+18 ⁶		B5075		2186 Bella Vista		2-18-66	
					2+51 ⁴							
3+00	122.7	117.36	5.3		3+43 ³		C29272		2220 Bella Vista		12-3-71	
4+00	122.0	117.56	4.4		4+30 ⁰		2000-00837 C19883		2212 R Bella Vista		4-4-00 6-30-70	
	121.8	117.68	4.1	4+60 ⁰								
5+00	121.5	117.84	3.7		5+18 ⁰							
6+00	122.7	118.24	4.5		5+62 ⁰		C1202		2224 Bella Vista		12-14-66	
					6+14 ⁵		B6397		2232 Bella Vista		9-27-66	
					6+81 ⁰							
	122.2	In 118.70 out 118.60	3.6	6+88 ⁶								
7+00	122.2	118.74	3.5		7+15 ⁶		C7106		2242 Bella Vista		3-1-68	
					7+56 ⁴		*C9785		2252 Bella Vista		7-24-68	
	122.7	119.00	3.7	7+64 ⁴ End 8" MCP								

C1036 - 2224 Bella Vista - Reynolds Pkg 12-1-66 top (4+89)
 B6397 - 2232 Bella Vista - Reynolds Pkg 10-4-66 top (6+79)