


LAT. 176, SUB. 5, S.S. 22  
W. B. CARTER CONST. CO., INC. (Let 6-16-64)  
PROJ. No. C23-104 K-79 BOOKED 7-14-64

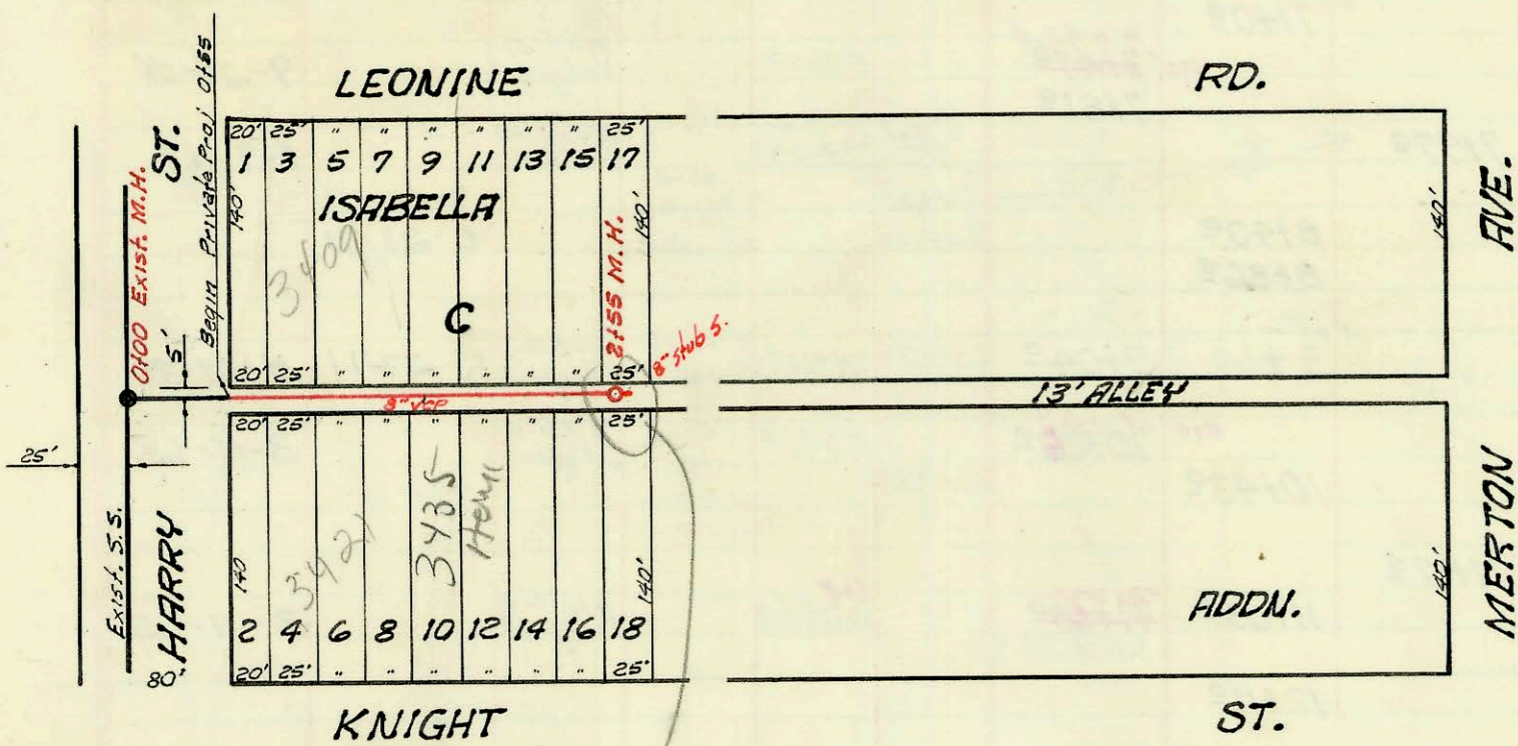

EXT. LINE 1-B, LAT. 57, S.S. 22.  
W. B. CARTER CONST. CO. INC. 7-9-64  
PRIVATE PROJ. K-84 BOOKED 7-15-64

prop. grand water  
clean up line  
see atty  
F-Mail  
INSTRUCTION  
4/3/69  
BSC

save This space

