


LAT. 28, SUB. 17, S. S. 22

W.B. CARTER CONST. CO. INC. LET 6-16-64

PROJ. NO. C23-103 K-76-A BOOKED 7-27-64

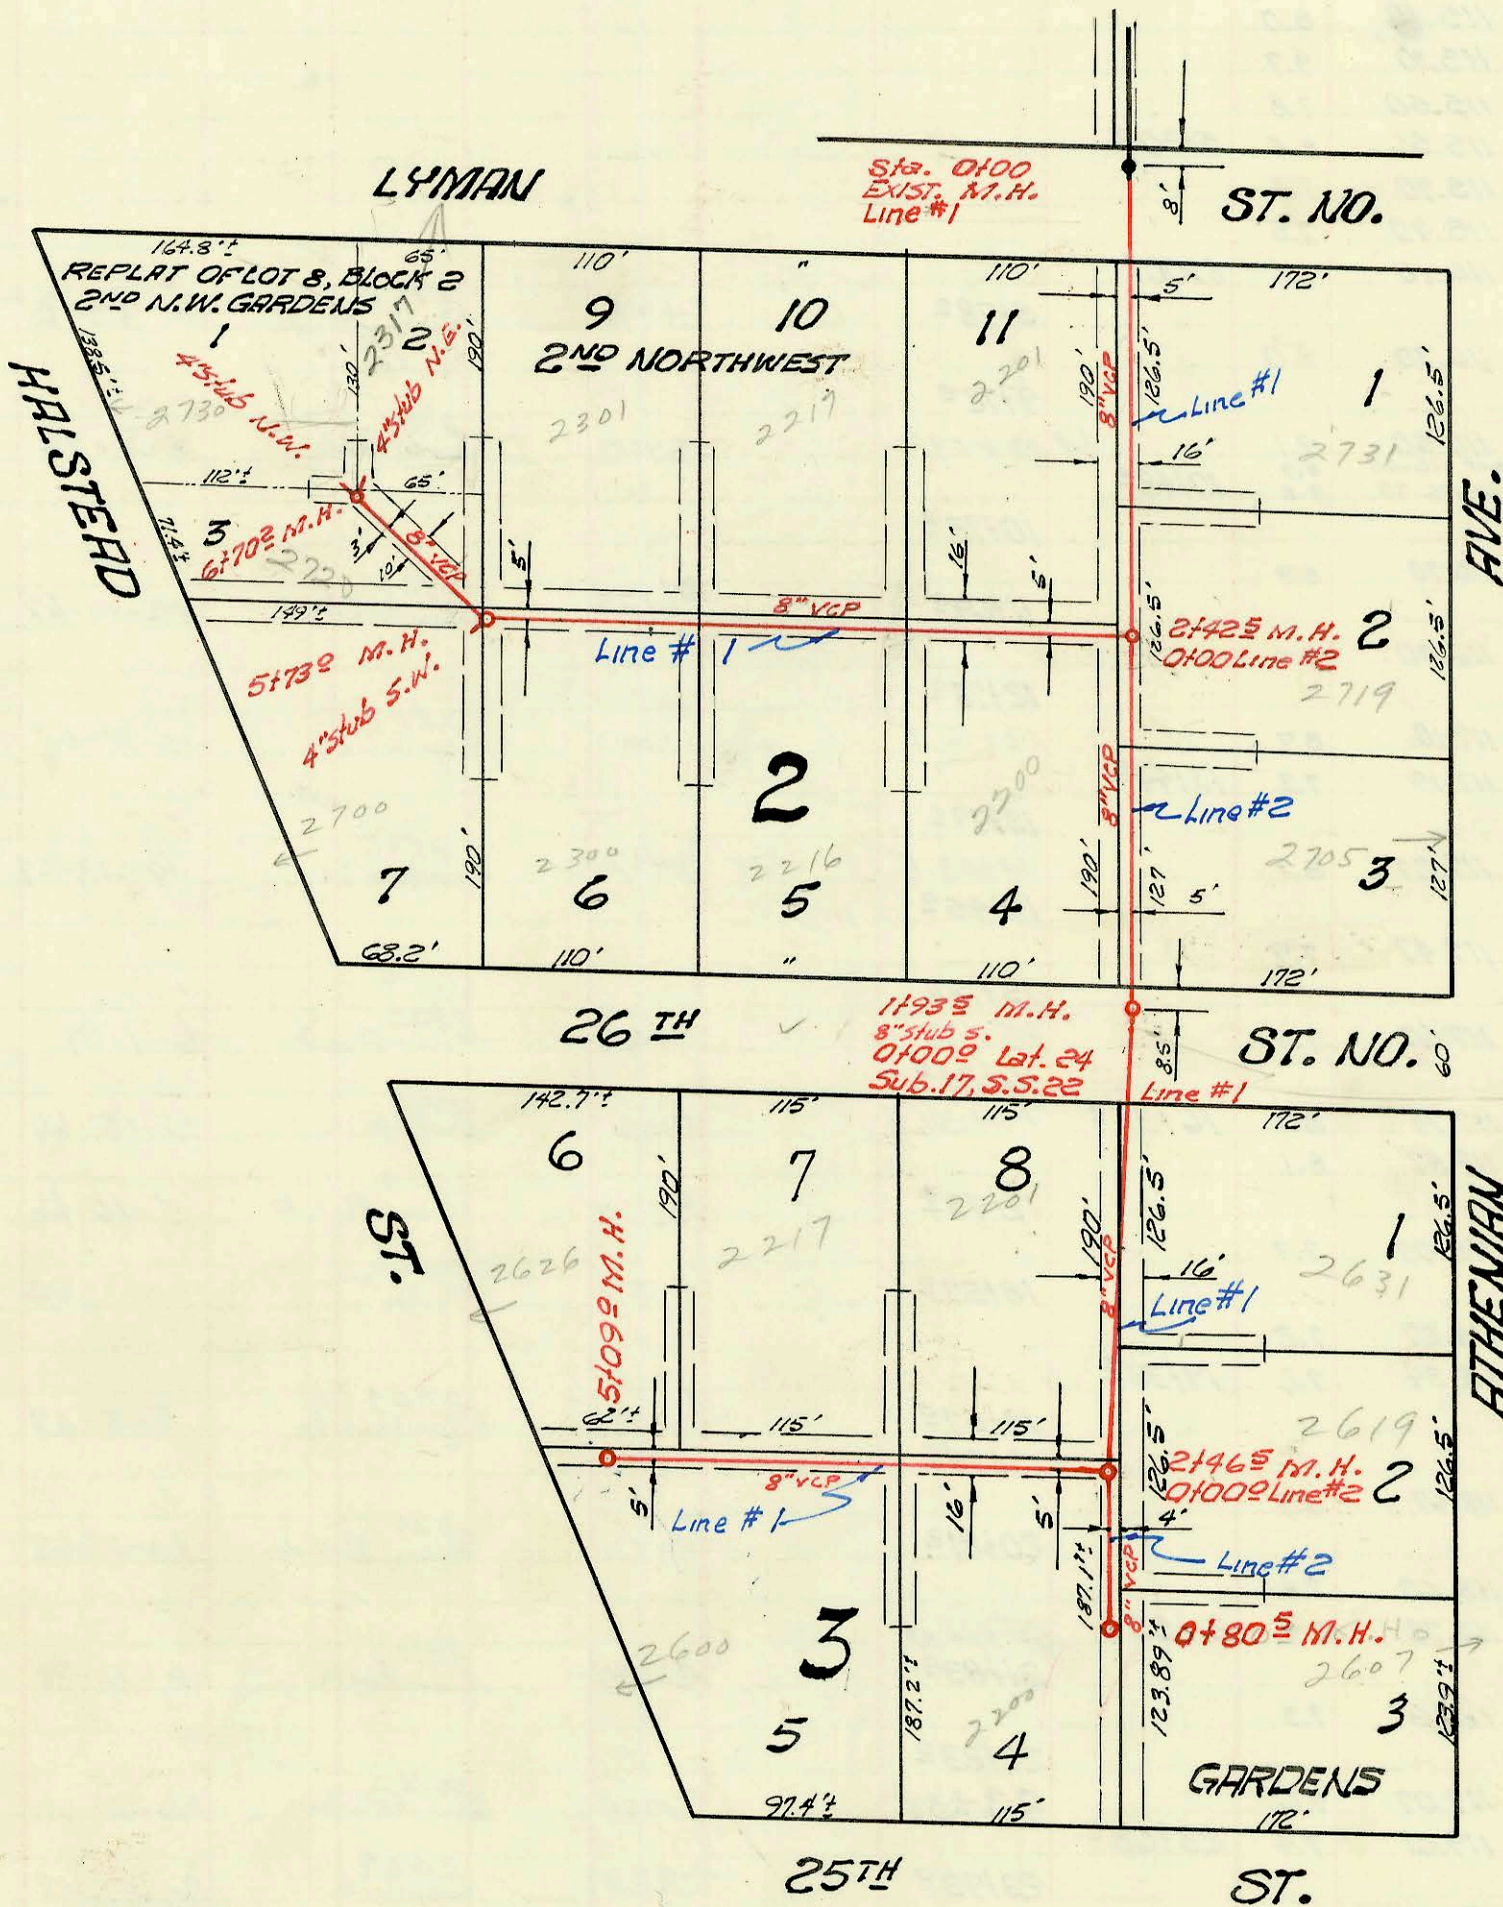

LAT. 24, SUB. 17, S. S. 22

MID-STATES CONSTRUCTION CO., INC. 8-11-64

PROJ. NO. C23-97, K-74, BOOKED 8-24-64

155

| CONSTRUCTION RECORD | | | | | | | SERVICE RECORD | | | | | | |
|---------------------|---------------------------|-----------------------------------|-----------------------------------|-------------------|---------------------------|------------|----------------|-----------------|------------------|------------------|-----------------|---------------|----------|
| STATION | ELEVATION | | Depth | MANHOLE | 4-INCH "Y" BRANCHES | | No. of Permit | | House Number | | DATE OF PERMITS | | |
| | Ground | Grade | | | North West | South East | North West | South East | North West | South East | North West | South East | |
| Line #1 | Lat. 28, Sub. 17, S.S. 22 | | | | | | | | | | | | |
| | 0+00 | 127.1 | 120.30 | 6.8 | Exist. 0+00 | (S' curb) | | | | | | | |
| | 1+00 | 127.4 | 120.50 | 6.9 | | | | | | | | | |
| | | | | | | | 1+20 | B135 | 2201 | 2731 N. Athenian | | 9-16-65 | |
| | | | | | | | 1+37 | B6410 | Lymon | | | 9-28-66 | |
| | 2+00 | 127.2 | 120.70 out 120.78 in 120.88 | 6.5 6.8 6.7 | 2+42 | | | | | | | | |
| | 3+00 | 127.5 | 121.00 | 6.5 | | | | | | | | | |
| | | | | | | | 3+62 | B3782 | 2217 | Lymon | | 7-13-65 | |
| | | | | | | | 3+74 | B1950 | 2216 | W. 26th | | 9-10-64 | |
| | 4+00 | 127.6 | 121.20 | 6.4 | | | 4+89 | B1700 | B 2701 | 2801 Lymon | 2300 W. 26th | 7-29-64 | |
| 5+00 | 127.6 | 121.40 out 121.55 in 121.68 | 6.2 6.1 6.0 | 5+73 | 4" stub S.W. | | B2218 | | 2700 | Halsted | | 10-29-64 | |
| 6+00 | 127.9 | 121.75 | 6.2 | | | 6+35 | C54571 | | 2720 | Halsted | | 4-1-76 | |
| | 128.3 | 122.03 | 6.3 | 6+70 | 4" stub N.W. 4" stub N.E. | | B1685 | C52169 | 2730 | Halsted | 2317 Lymon | 7-22-64 | 10/28/75 |
| Line #2 | Lat. 28, Sub. 17, S.S. 22 | | | | | | | | | | | | |
| | 0+00 | 127.6 | 120.80 | 6.8 | Exist. 0+00 | | | | | | | | |
| | | | | | | | 0+84 | B1810 | 9373 | 2200 | W. 26th | 2719 Athenian | 10-5-83 |
| | 1+00 | 127.5 | 121.00 | 6.5 | | | | | | | | | |
| | | | | | | | | | | | | | |
| | | | | | | 1+41 | | B2910 | | 2705 N. Athenian | | 3-4-65 | |
| 1+93 | 127.3 | 121.18 | 6.1 | 1+93 | (8" stub S.) | | | | | | | | |
| Line #1 | Lat. 24, Sub. 17, S.S. 22 | | | | | | | | | | | | |
| | 0+00 | 127.3 | 121.18 | 6.1 | Exist. 0+00 | | | | | | | | |
| | 1+00 | 127.8 | 121.38 | 6.4 | | | | | | | | | |
| | | | | | | | 1+24 | | C1166 | 2631 N. Athenian | | 12/10/66 | |
| | | | | | | | 1+28 | B6437 | 2201 W. 26th St. | | | 10-3-66 | |
| | 2+00 | 127.7 | 121.58 | 6.1 | | | | | | | | | |
| | | | | | | | | | | | | | |
| | | | | | | | | | | | | | |
| 3+00 | 127.5 | out 121.67 in 121.78 | 5.8 5.7 | 2+46 | | | | | | | | | |
| 3+00 | 127.1 | 121.98 | 5.1 | | | | | | | | | | |
| 4+00 | 127.4 | 122.38 | 5.0 | | | 3+89 | B2240 | 2217 W. 26th N. | | | 11-2-64 | | |
| 4+00 | 127.4 | 122.38 | 5.0 | | | | | | | | | | |
| | | | | | | 4+78 | B2159 | B2959 | 2626 | Halsted | | 3-10-65 | |
| 5+00 | 127.2 | 122.78 | 4.4 | | | | | | | | | | |
| | 127.3 | 122.82 | 4.5 | 5+09 | | | | | | | | | |
| Line #2 | Lat. 24, Sub. 17, S.S. 22 | | | | | | | | | | | | |
| | 0+00 | 127.5 | 121.78 | 5.7 | Exist. 0+00 | | | | | | | | |
| | | | | | | | | | | | | | |
| | | | | | | 0+74 | B1872 | B2481 | 2200 W. 25th | 2607 N. Athenian | | 7-1-64 | |
| | | | | | | | | | | | | | |
| | | | | | | 0+80 | | | | | | 12-11-64 | |

B 3080-2619 N. Athenian - 4-16-65 - You white plug-top 0+04 Line 2