


LAT. 94, S. S. # 22  
 W. B. CARTER CONSTRUCTION CO. INC. 12-3-64  
 PROJ. NO. C24-40 K-84 BOOKED 1-5-65

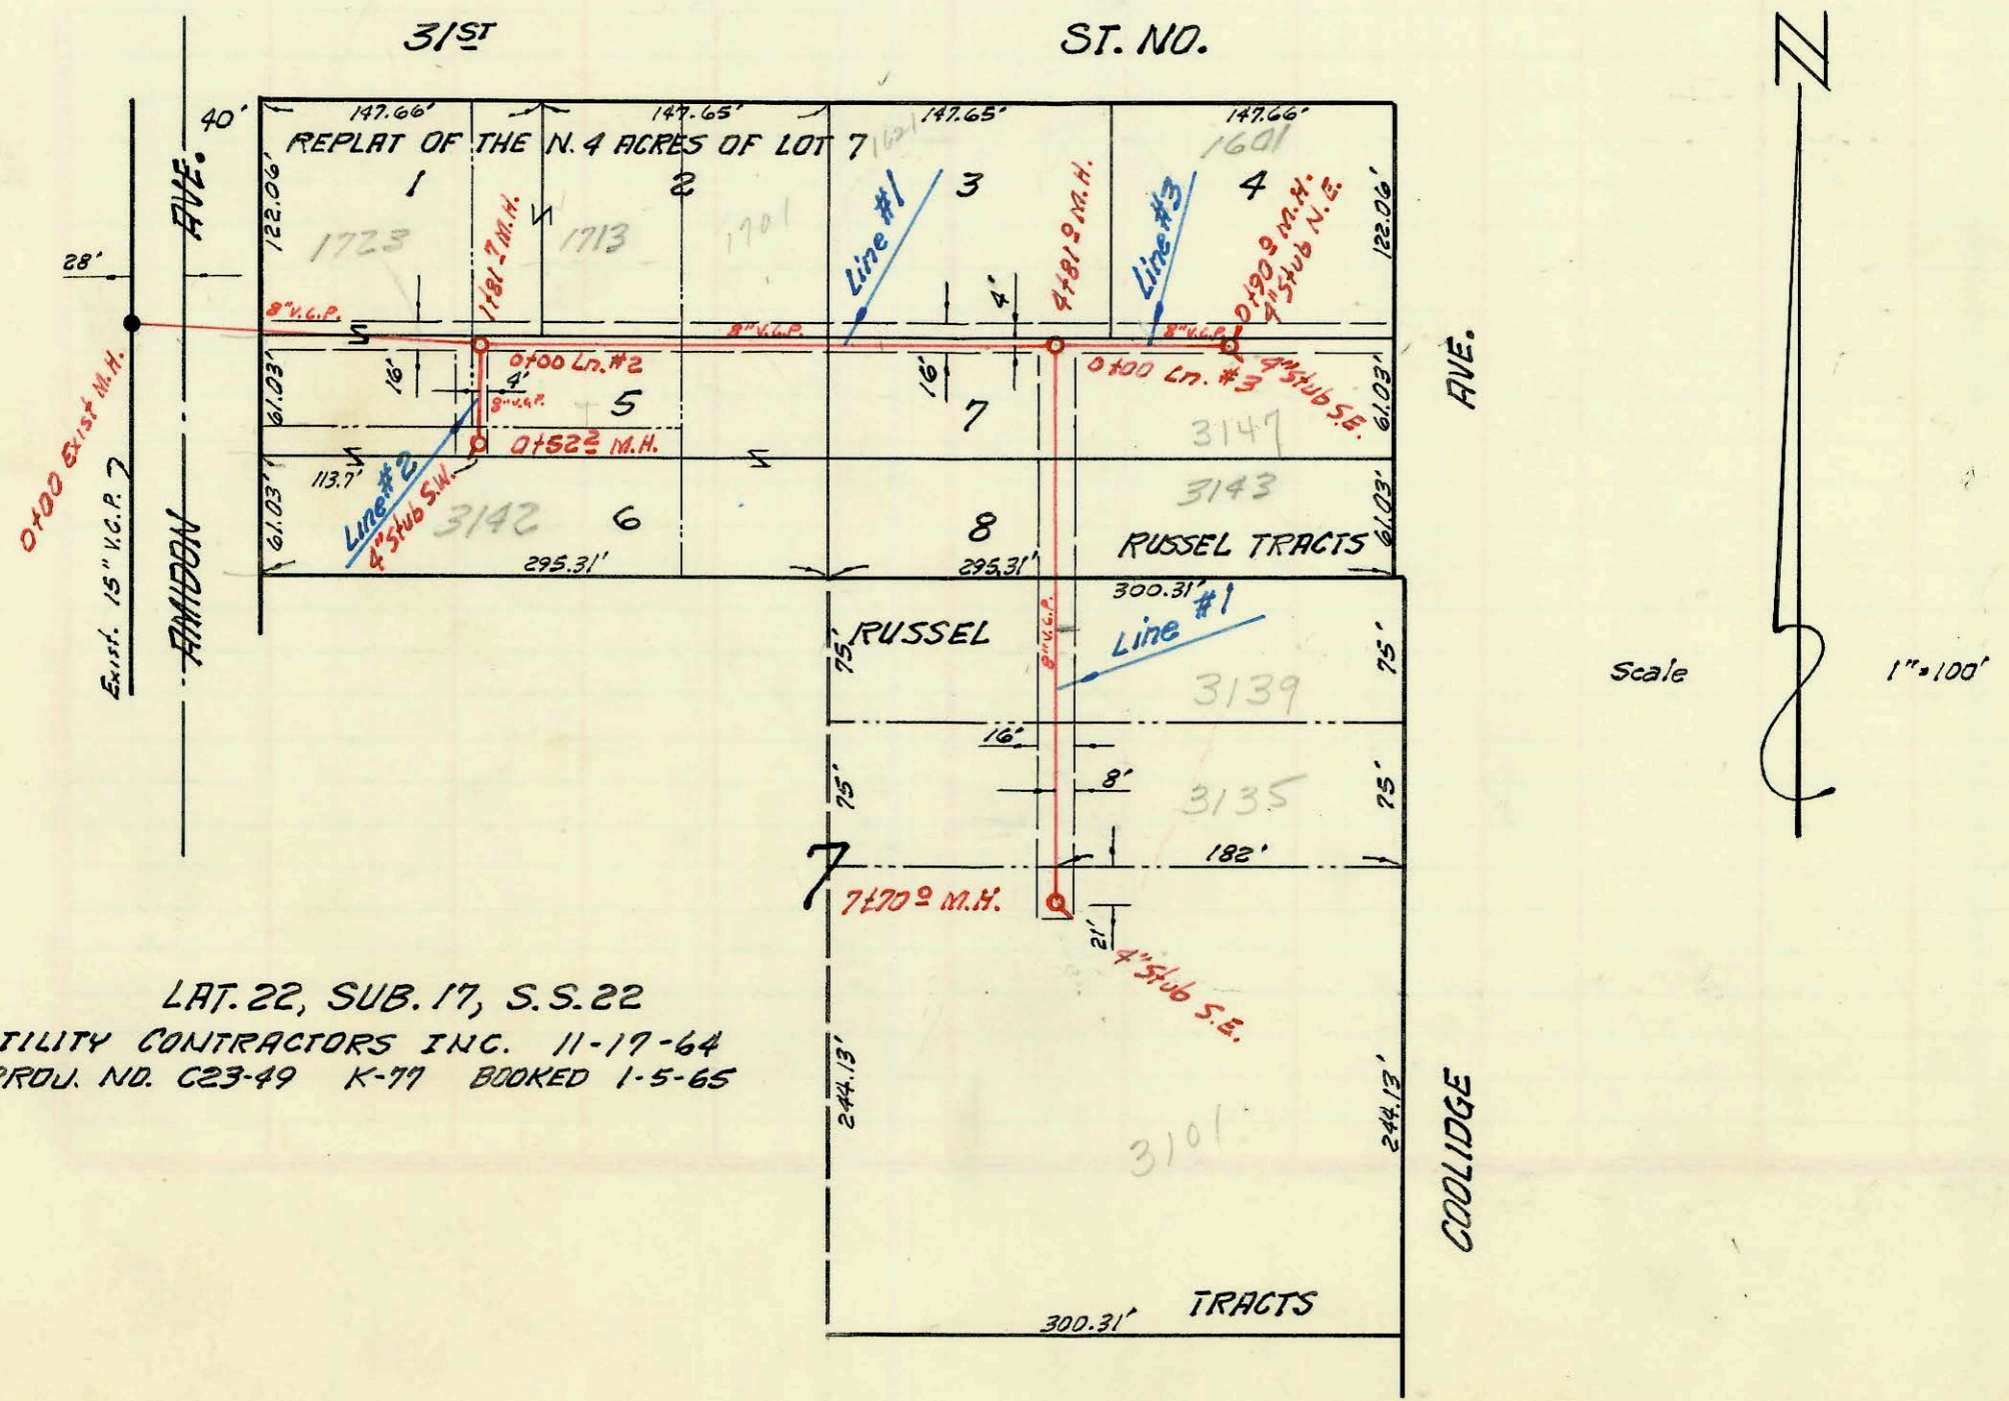

LAT. 22, SUB. 17, S. S. 22  
 UTILITY CONTRACTORS INC. 11-19-64  
 PROJ. NO. C23-49 K-77 BOOKED 1-5-65

CONSTRUCTION RECORD						SERVICE RECORD						
STATION	ELEVATION		Depth	MANHOLE	4-INCH "Y" BRANCHES		No. of Permit		House Number		DATE OF PERMITS	
	Ground	Grade			North West	South East	North West	South East	North West	South East	North West	South East
LAT. 94, S.S. 22												
0+00	126.4	118.54	7.9	New 0+00	0+99	0+97	C46055	B2605	2410 N. 25th St. Meridian	2653	8-2-74	1-5-65
1+00	127.5	118.94	8.6		1+89	1+87	# B2606		2614 N. Meridian		1-5-65	1-5-65
2+00	127.1	119.34	7.8									
	127.3	119.60	7.7	2+65	2+89	2+87	B5349		2624 N. Meridian		3-29-66	
3+00	127.1	119.74	7.4		3+82	3+80	57032 B5416	B2615	2634 N. Meridian	2625	8-7-76	1-6-65
4+00	127.1	120.14	7.0									
	126.9	120.36	6.5	4+55								
Line #1	LAT. 22, SUB. 17, S.S. 22											
0+00	129.0	116.85	12.2	Exist. 0+00								
1+00	128.2	117.25	11.0		1+39		C1041		1723 W. 31st St. No.		12-2-66	
2+00	128.8	117.58	11.2	1+81	2+41		B3245		1713 7th St. No.		4-20-65	
3+00	129.5	118.05	11.5		3+07	3+09	B3058		1701 W. 31st St.		4-8-65	
4+00	129.2	118.45	10.8		4+20		B3069		1621 W. 31st St. N.		4-9-65	
5+00	129.3	118.95	10.4	4+81	5+52	5+50						
6+00	128.7	119.35	9.4		6+31	6+29	B2612		3139 Coolidge		1-15-65	
7+00	127.8	119.75	8.1		7+05	7+03	B2613		3135 Coolidge		1-15-65	
	129.1	120.03	9.1	7+70	7+34	7+32	B3091		3111 Coolidge		4-13-65	
							C28948		3101 Coolidge		11-11-71	
Line #2	0+00											
	128.7	119.56	9.1	Exist. 0+00								
	128.8	120.03	8.8	0+52	4+34	4+32	C10524		3442 N. Amidon		9-17-68	
Line #3	0+00											
	129.2	119.50	9.7	Exist. 0+00	0+38							
	128.7	120.40	8.3	0+90	4+34	4+32	B3088	B3269	1601 W. 31st St. Coolidge	3147	4-9-65	4-23-65

2000-0044 2 216-00 3143 N Coolidge - (No record of OR's) moved out from under add on 4" SCH 40 - 20' of Pipe - Repair

2370 31-8-4-76 = 2634 N. Meridian Top of Soil 2429 W. 26th St. (4+80.4)