



K 163A

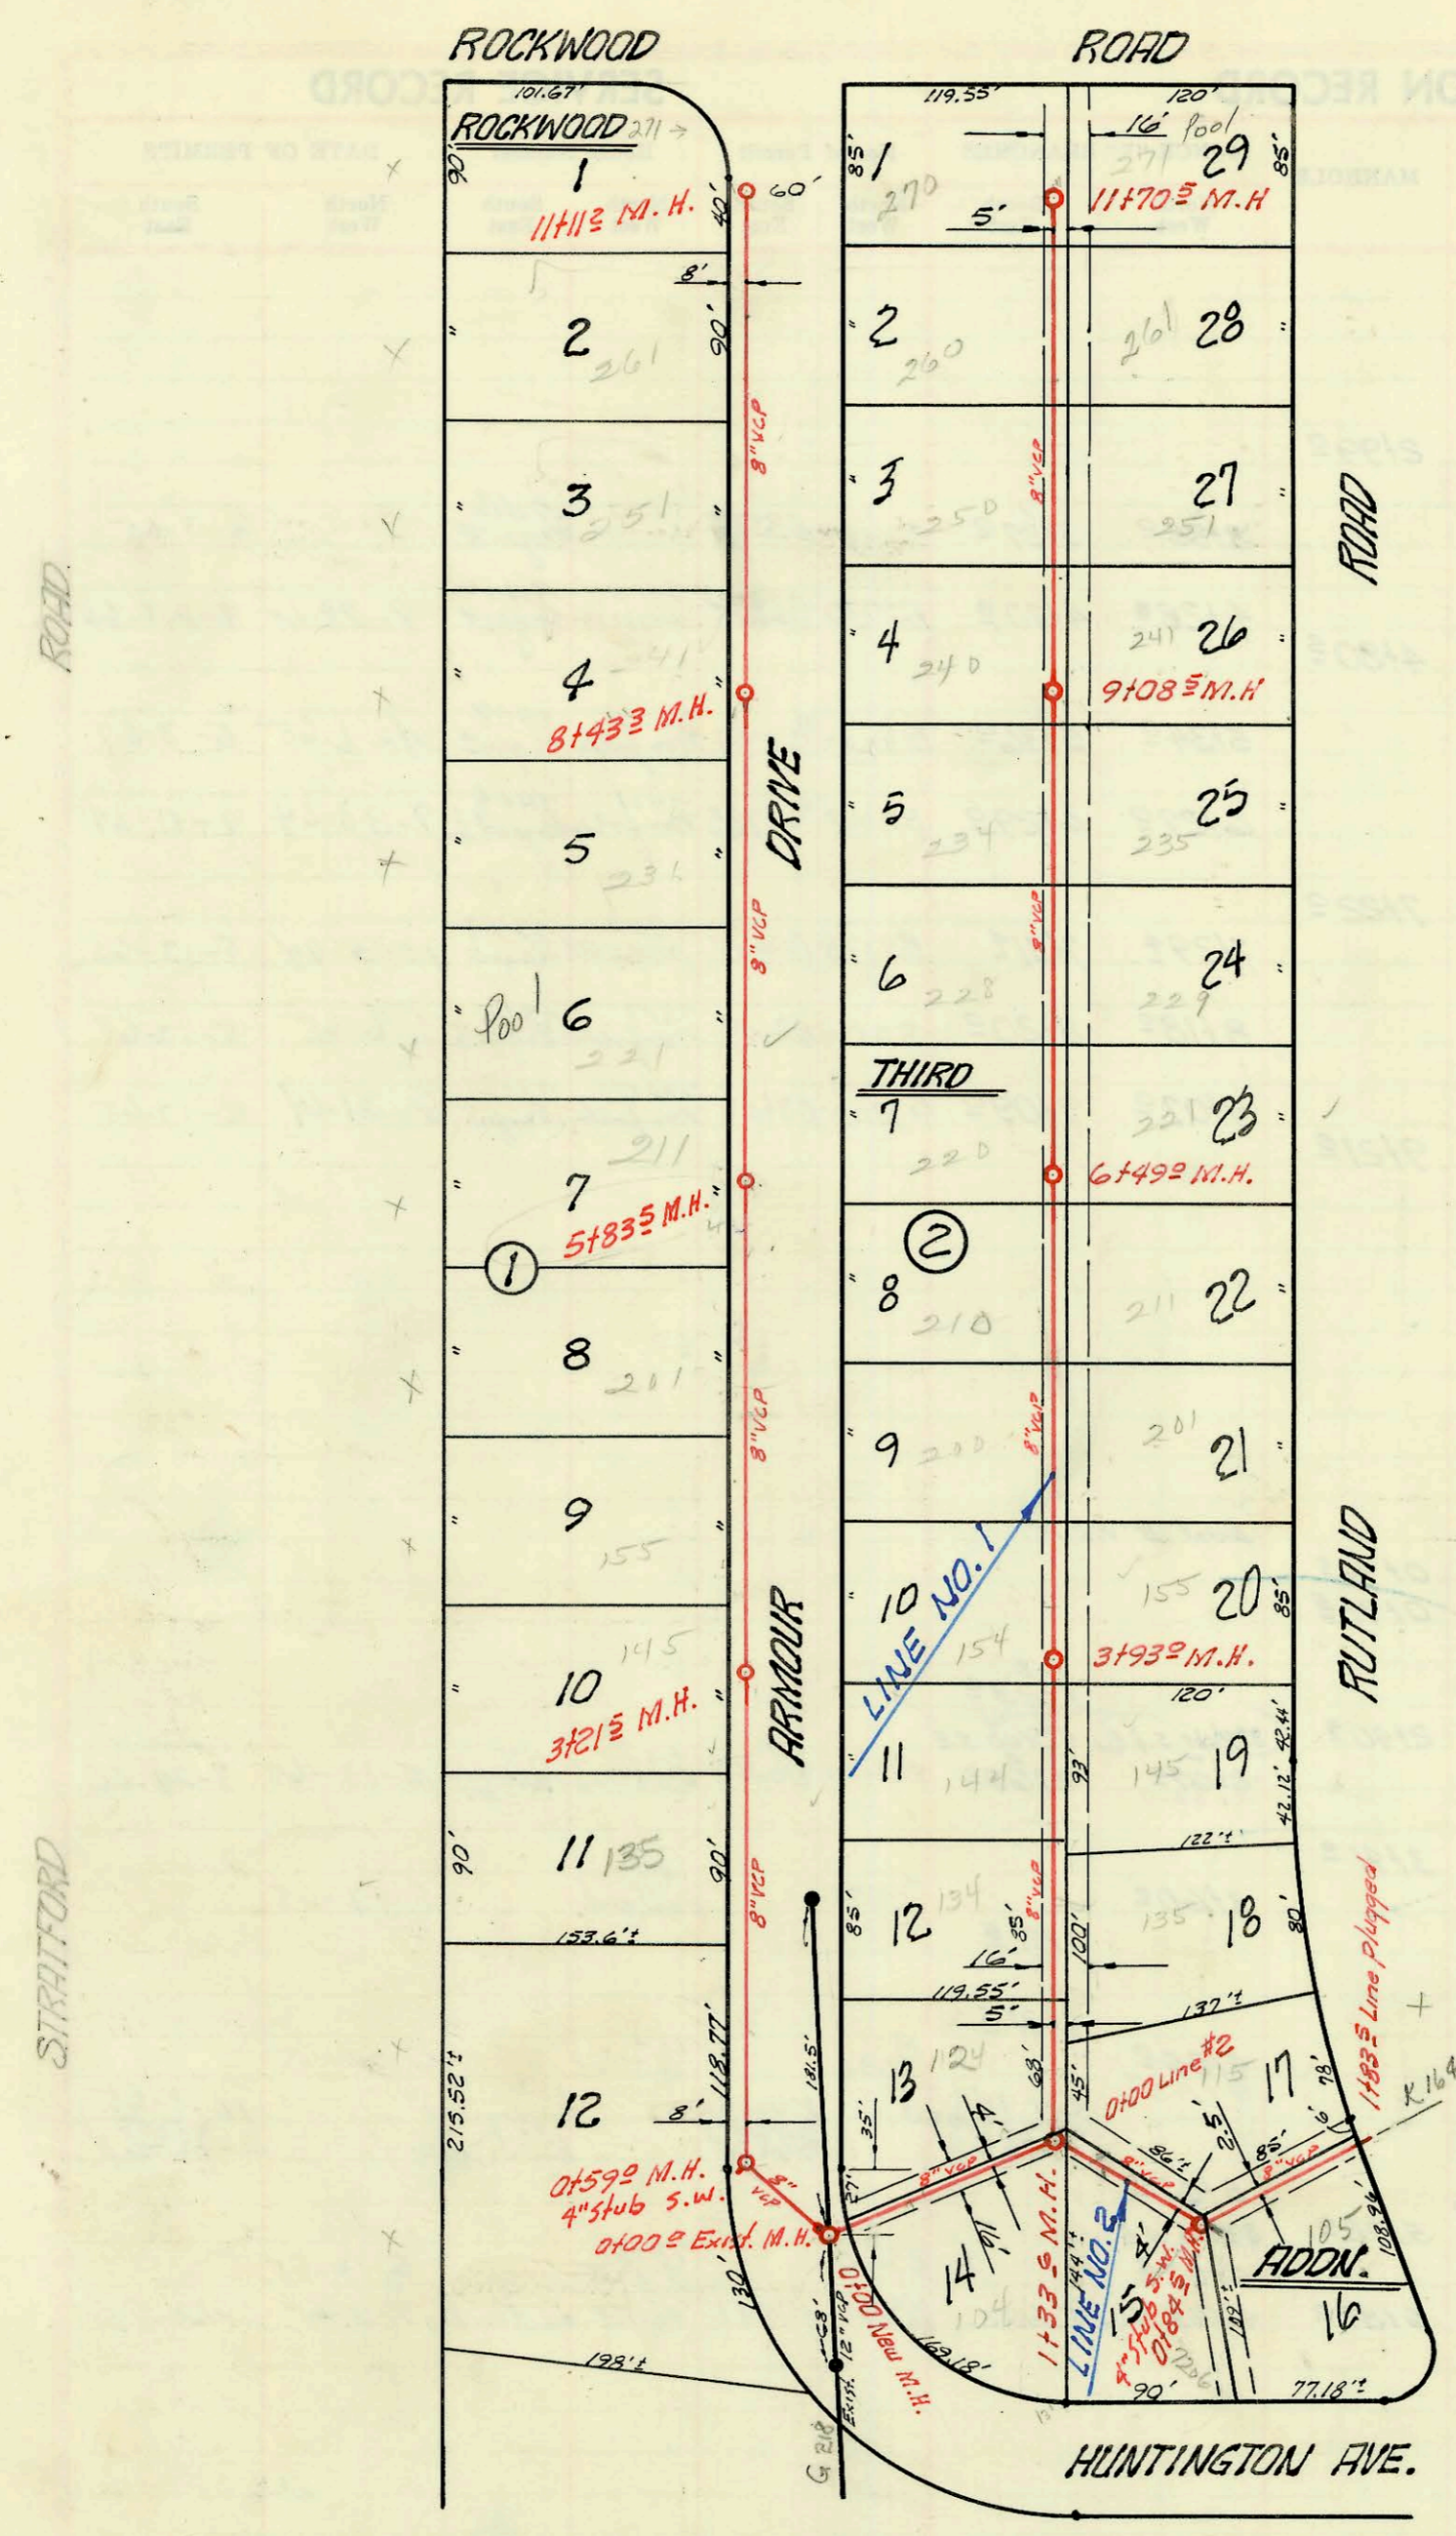

**CAUTION**  
**UNDERGROUND**  
**UTILITIES**  
 Please check with K G & E or  
 Southwestern Bell  
 Telephone Co. for Location

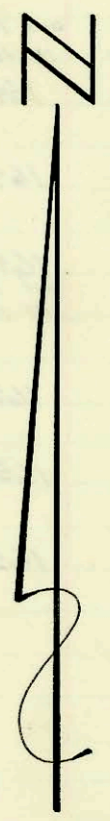

Scale 1" = 100'

LAT. 25, SUB. 5A, W.I.S.  
 W.B. CARTER CONST. CO., INC. 7-14-64  
 PROJ. NO. C24-20, K-84, BOOKED 8-11-64

LAT. 24, SUB. 5A, W.I.S.  
 W.B. CARTER CONSTRUCTION CO., INC. 7-14-64  
 PROJ. NO. C24-19, K-82, BOOKED 8-19-64

