


LATERAL 24, W. I. S.
 W. B. CARTER CONSTRUCTION CO, INC. 11-3-64
 PROJ. NO C29-16 K-82 BOOKED 11-13-64

LAT. 33, W. I. S.
 W. B. CARTER CONST. CO. INC.
 PROJ. NO. C26-7, BK NO. K-79
 MAY 17, 1966

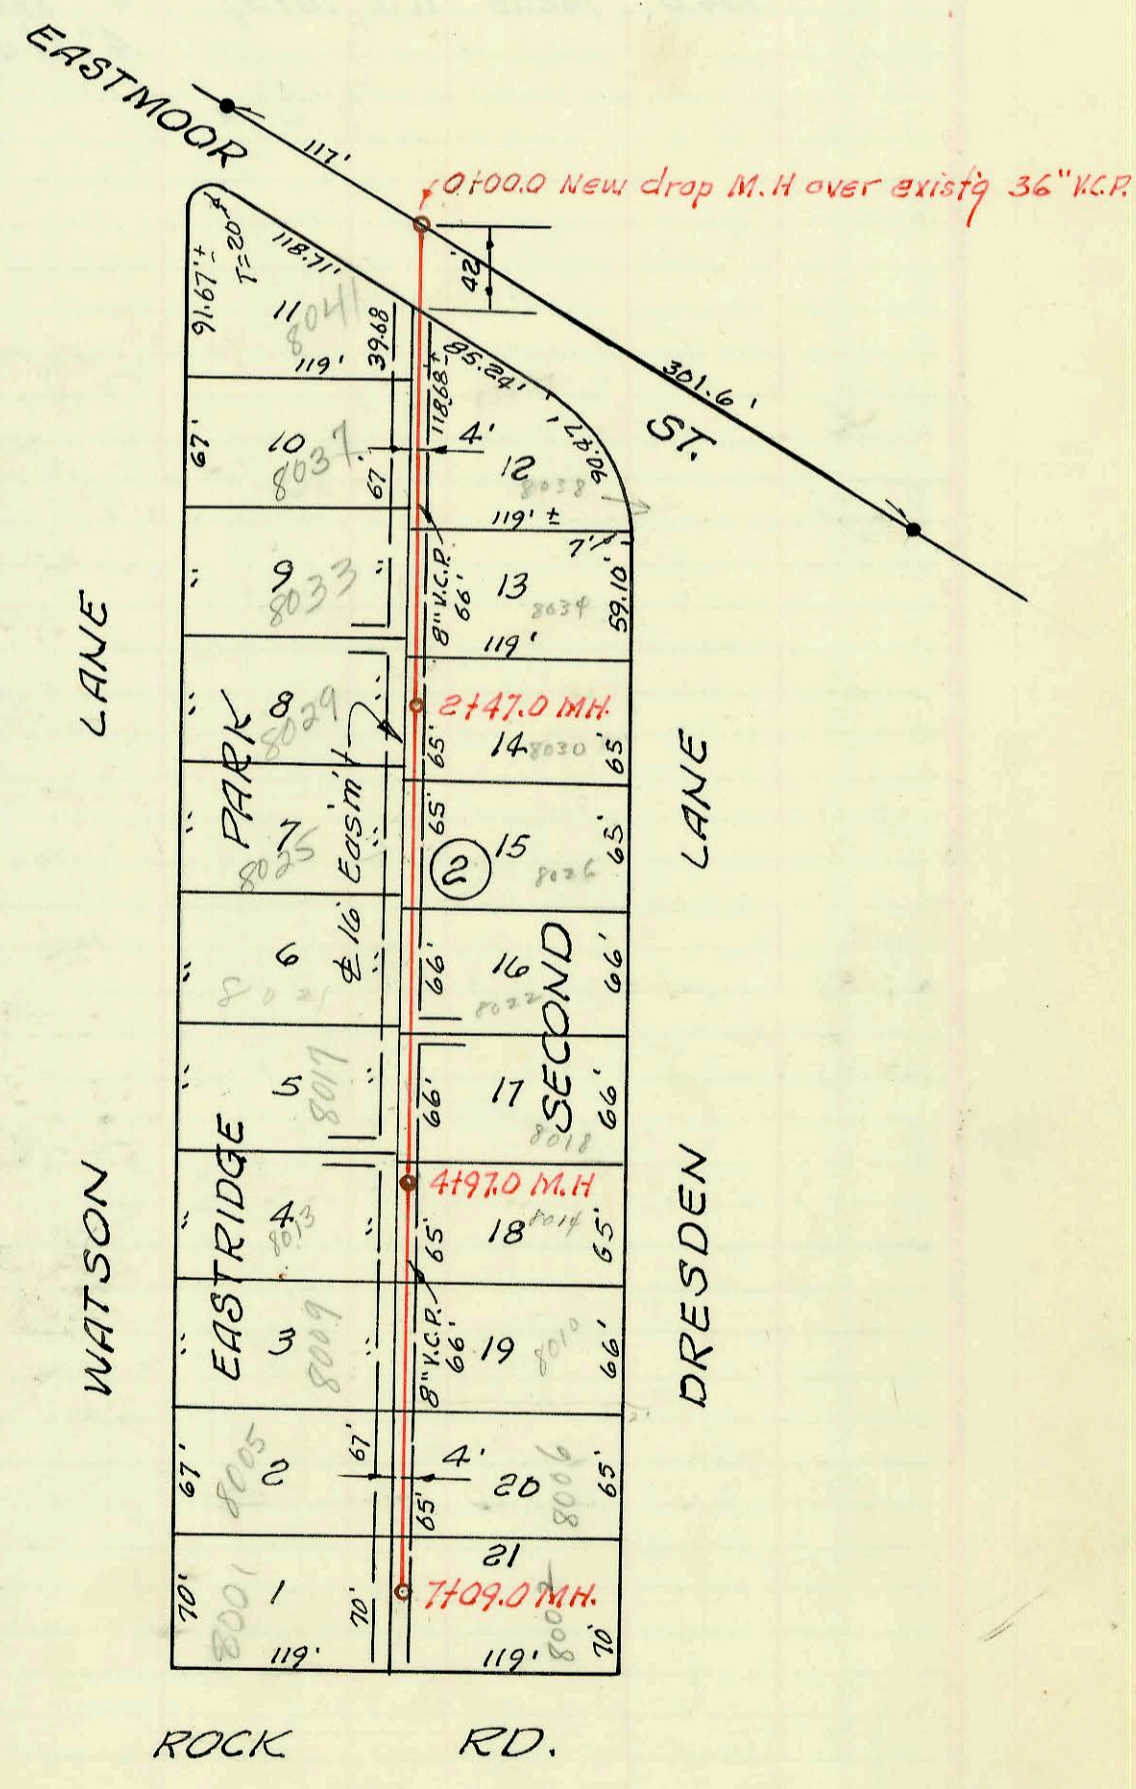

CONSTRUCTION RECORD						SERVICE RECORD						
STATION	ELEVATION		Depth	MANHOLE	4-INCH "Y" BRANCHES		No. of Permit		House Number		DATE OF PERMITS	
	Ground	Grade			North West	South East	North West	South East	North West	South East	North West	South East
LAT. 24, W. I. S. 0+00	140.6	out 123.19 in 131.5	11.4 9.1	0+00	drop slack 0+42°		B3983		8113E clay			8-17-65
1+00	140.2	132.5	7.7		1+04° 1+69°	1+07° 1+71°	B3984 B3985	B5875 B5469	8109E 8108E clay	8046 8042 Watson		8-17-65 6-22-66 8-17-65 4-18-66
2+00	142.5	133.5	9.0		2+32°	2+34°	B3601	B5610	8101E clay	8038 Watson		6-16-65 5-12-66
3+00	142.7	134.5	8.2	3+00°	3+08° 3+61°	3+10° 3+63°	B3600 B3052	B5338	8037E 8033 clay	8034 Watson		6-16-65 3-28-66 4-7-65
4+00	145.3	135.5	9.8		4+25° 4+91°	4+27° 4+93°	B2973 B2822	B5307	8029 8025 clay	8030 Watson		3-16-65 2-8-65
5+00	144.9	136.5	8.4		5+59°	5+61°	B2330	B4894	8021 E clay st.	8022 Watson		11-12-64 1-6-66
6+00	146.7	137.5	9.2	6+00°	6+18° 6+82°	6+21° 6+84°	B2372 B2398	B4711	8017 E 8013 clay	8014 Watson		11-23-64 11-27-64 12-7-65
7+00	150.1	140.0	10.1		7+47°	7+49°	B5319	B4471	8009 E clay st.	8010 Watson		11-12-64 11-7-65
8+00	152.0	142.5	9.5		8+13° 8+72°	8+15° 8+73°	B2978 B2558	B4324 B4480	8005 8001 E clay	8006 8002 Watson		3-11-65 10-10-65 12-24-64 11-4-65
	151.5	144.75	6.7	8+89°								
L.A.T. 33, W. I. S.												
0+00	139.8	123.78 out 131.00 in	88	0+00° Outside drop MH	0+51°		C7264		8041 Watson			3-11-68
1+00	139.5	131.80	7.7		0+89° 1+61°	0+62° 1+18°	C782 B6485		8037 8033 Watson			11-8-66 8-3-67 10-12-66
2+00	142.2	132.60	9.6		1+72°	1+72°	C3226		8034 Watson			5-23-67
	142.7	133.00	9.7	2+47°	2+24°	2+26°	B6199	C4221	8029 Watson	8030 Watson		8-16-66 8-3-67
3+00	142.7	133.30	9.4		2+87°	2+89°	B6302	C4220	8025 Watson	8026 Watson		9-7-66 8-3-67
4+00	145.4	133.90	11.5		3+58°	3+60°	B6198	C3225	8021 Watson	8022 Watson		8-16-66 5-23-67
	148.3	134.50	13.8	4+97°	4+21° 4+90°	4+23° 4+92°	B5659 B5876	C2151 C2346	8011 8013 Watson	8018 8014 Watson		5-18-66 4-19-67 6-22-66 3-22-67
5+00					5+58°	5+60°	B5660	C2084	8009 Watson	8010 Watson		5-18-66 3-1-67
6+00	147.8	135.70	12.1		6+22° 6+91°	6+24° 6+93°	B5796 B6395	C1883 C1882	8005 8001 Watson	8006 8002 Watson		6-9-66 2-14-67 9-27-66 2-14-67
7+00	144.8 144.6	136.90 137.02	7.9 7.6	7+09°								

B4712-8018 Watson Sr - Daulding Alley 12-7-65 top (5+95)
 B5071-8026 Watson Sr - Daulding Alley 2-10-66 top (4+61.5)