

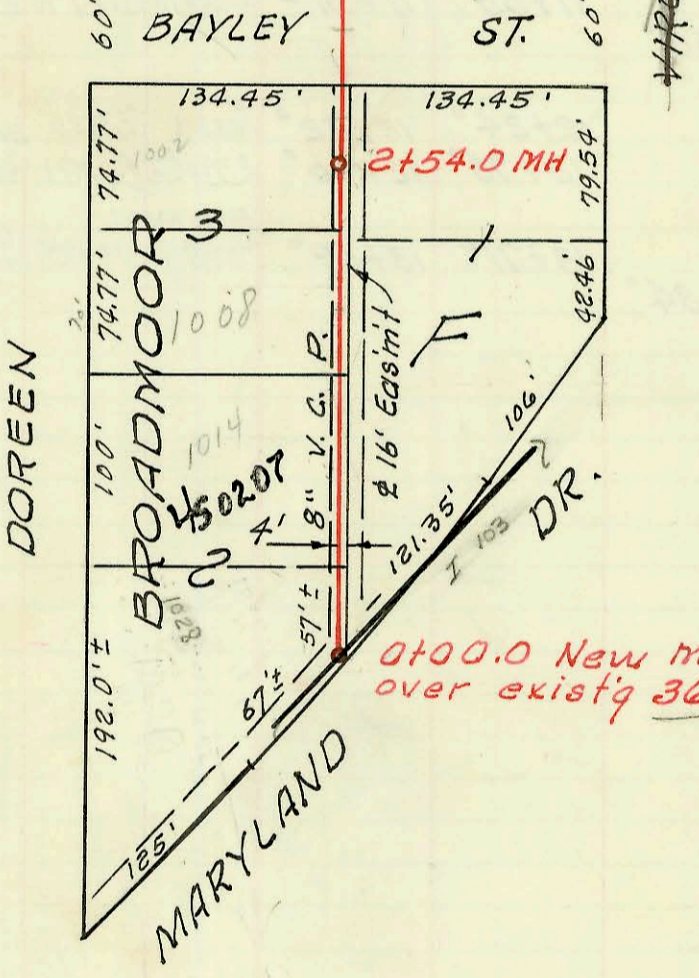


LINCOLN ST.

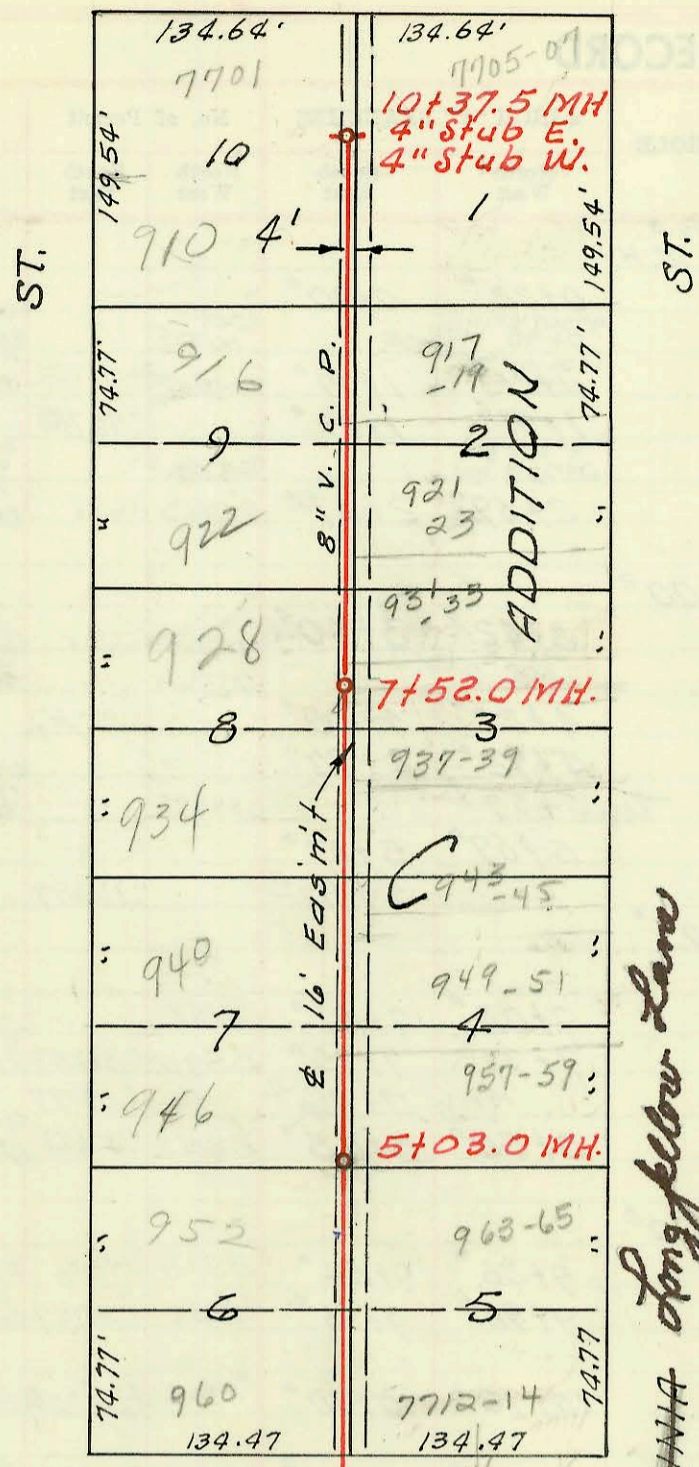

LAT. 32, W. I. S.  
 MID-STATES CONST. CO. INC., DEC. 1965  
 PROJ. NO. C25-32, BK NO. K-87  
 12-22-65

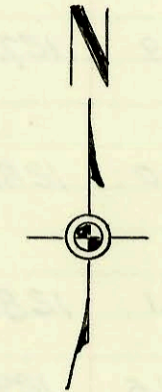

1" = 100'

Longfellow Lane

0+00.0 New M.H.  
 over existg 36" S.S.  
 WIS

K

CONSTRUCTION RECORD						SERVICE RECORD						
STATION	ELEVATION		Depth	MANHOLE	4-INCH "Y" BRANCHES		No. of Permit		House Number		DATE OF PERMITS	
	Ground	Grade			North West	South East	North West	South East	North West	South East	North West	South East
0+00	137.6	130.00	7.6	0+00 <sup>2</sup> New M.H.	0+06.0 <sup>2</sup>		7441		1028 Doreen		1-27-83	
					0+27 <sup>2</sup>							
					0+85 <sup>2</sup>	0+59 <sup>2</sup>			1014 Doreen		5-22-75	
1+00	138.0	130.50	7.5				C41623					
					1+84 <sup>5</sup>	1+82 <sup>5</sup>			1008 So Doreen		9-16-70	
2+00	139.4	131.00	8.4									
	140.2	131.25	8.4	2+54 <sup>2</sup>								
					2+63 <sup>2</sup>	2+65 <sup>2</sup>						
3+00	140.8	131.50	9.3									
					3+86 <sup>2</sup>	3+84 <sup>2</sup>			7715-17 S. Bayley		8-29-77	
					4+19 <sup>2</sup>				960 Doreen		6-27-72	
4+00	142.2	132.00	10.2						7713-14 S. Bayley		7-28-99	
					4+60 <sup>2</sup>	4+58 <sup>2</sup>					8-2-75	
					4+64 <sup>2</sup>							
5+00	144.5	132.50	12.0									
	144.5	132.51	12.0	5+03 <sup>2</sup>					952 Doreen		4-23-69	
					5+34 <sup>2</sup>	5+32 <sup>2</sup>						
6+00	146.0	133.00	13.0						946 Doreen		9-16-68	
					6+20 <sup>2</sup>	6+18 <sup>2</sup>			940 Doreen		6-2-72	
					6+89 <sup>2</sup>	6+87 <sup>2</sup>			934 Doreen		8-28-70	
7+00	146.2	133.50	12.7									
	146.2	133.75	12.4	7+52 <sup>0</sup>								
					7+57 <sup>2</sup>	7+59 <sup>2</sup>			928 Doreen	937-39 Langfellow	4-26-68	2-28-73
8+00	146.2	135.15	11.0									
					8+39 <sup>2</sup>	8+37 <sup>2</sup>			922 S Doreen		6-2-72	
9+00	147.6	137.95	9.6									
					9+16 <sup>2</sup>	9+14 <sup>2</sup>			916 Doreen		8-4-67	
					9+81 <sup>2</sup>	9+79 <sup>2</sup>			910 Doreen		6-5-72	
10+00	149.3	140.75	8.5									
	154.0	142.15	11.9	10+37 <sup>5</sup>	4" stub E							
					4" stub W				7765-07 E. Funicular		1-12-66	
									7701 Doreen		8-3-76	

Top C35704-917-19 Langfellow - Jap in 5+03 - 2-28-73 (8+96.6)  
 Top C35706-921-23 Langfellow " " - 2-28-73 (8+95.0)  
 Top C35707-931-33 Langfellow " " - 2-28-73 (7+64.0)  
 Top C38495-943-45 Langfellow " " - 4-25-73 (6+37.0)  
 Top C38496-949-51 Langfellow " " - 4/25/73 (6+33.0)  
 Top C38497-957-59 Langfellow " " - 4/25/73 (M.H. Jap in 5+03)  
 Top C38498-963-65 Langfellow " " - 4/25/73 (M.H. Jap in 5+03)